

BRIDGELAND PLACE

PROJECT INFORMATION

ARCHITECT

HINDLE ARCHITECTS
SUITE 510 - 237 8 AVENUE SE
CALGARY, AB
T2G 5C3

JESSE HINDLE
403.804.4344
jesse@hindle-architects.com

AMBER LAFONTAINE
403.804.7592
amber@hindle-architects.com

CIVIL

JUBILEE ENGINEERING CONSULTANTS LTD.

3702 EDMONTON TRAIL NE
CALGARY, AB
T2E 3P4

DAVID VATCHER
403.276.1001
david.vatcher@jubileeengineering.com

LANDSCAPE

BASSETT ASSOCIATES LANDSCAPE ARCHITECTURE INC.

#603, 550 11TH AVENUE SW
CALGARY, AB
T2R 1M7

RICHARD BASSETT
403.286.8118
rich@bassettassociates.ca

ELECTRICAL

EMBE CONSULTING ENGINEERS INC.

121 15TH AVENUE SE
CALGARY, AB
T2G 1G1

DRAUPADI KARADIA
403.440.2277
dkaradia@embeconsulting.ca

PROJECT ADDRESS

736 MCDUGALL CT NE
CALGARY, AB
T2E 2W6

LOT MCDUGALL RESERVE
BLOCK 2
PLAN 4301 R

APPLICANT

MR. DOUG CARROLL
604.785.8964
doug@hindle-architects.com

CLIENT

CALGARY HOUSING

WOOD CENTRE
200, 2535 3RD AVENUE SE
CALGARY, AB
T2A 7W5

BRETT O'REILLY
587.284.2961
brett.oreilly@calgary.ca

ISSUED TO

THE CITY OF CALGARY DEVELOPMENT APPROVALS REVIEW TEAM

P.O. BOX 2100 STN M
800 MACLEOD TRAIL SE
CALGARY, AB
T2P 2M5



DEVELOPMENT PERMIT

2025-12-18



EXISTING SITE PHOTO 1: FACING SOUTHWEST




EXISTING SITE PHOTO 2: FACING WEST



EXISTING SITE PHOTO 3: FACING EAST



EXISTING SITE PHOTO 4: FACING SOUTH

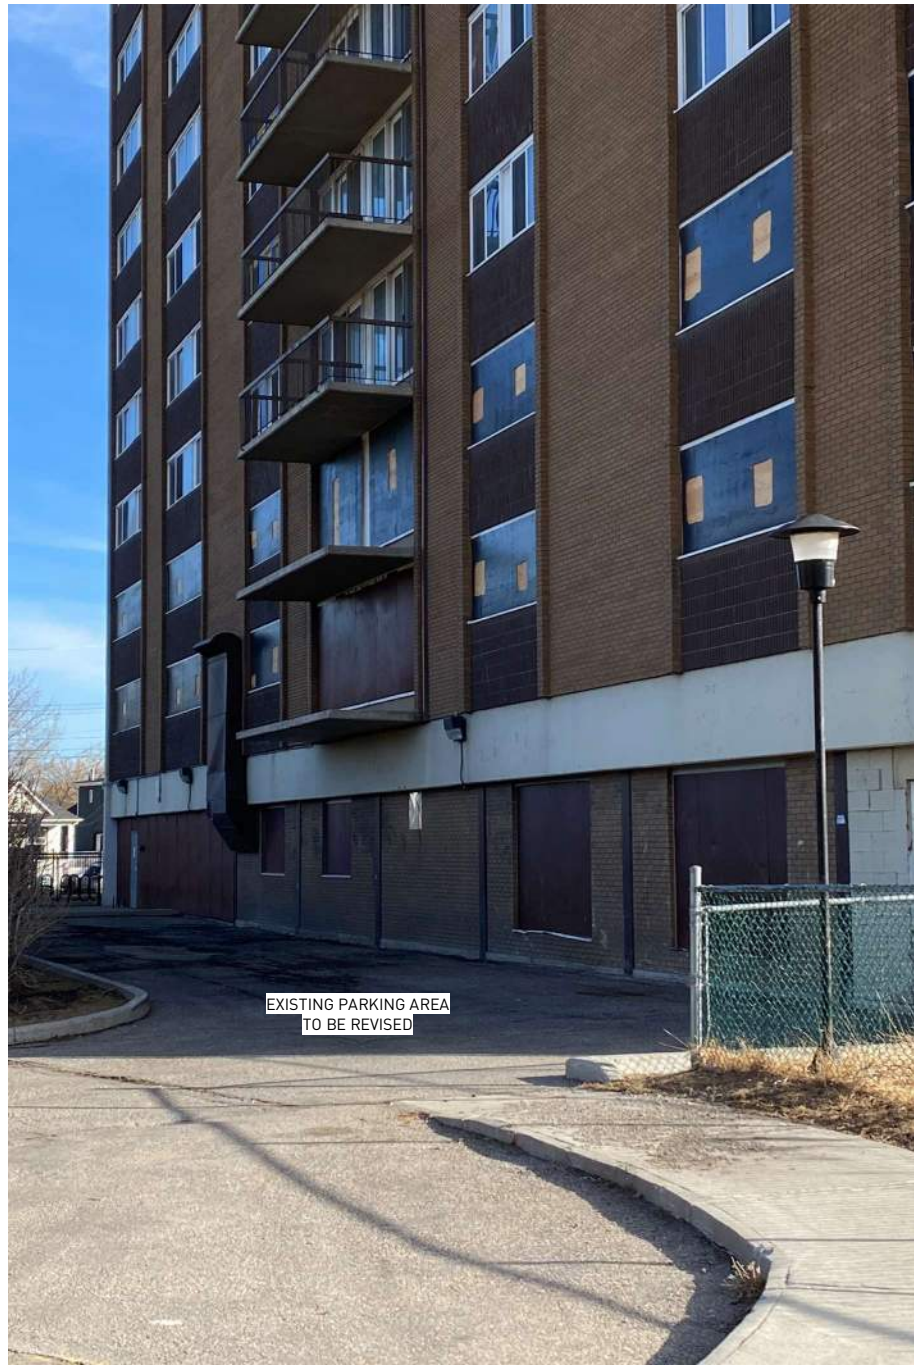

EXISTING SITE PHOTO 5: FACING SOUTHEAST





EXISTING SITE PHOTO 6: FACING SOUTH



EXISTING SITE PHOTO 7: FACING SOUTHEAST



EXISTING SITE PHOTO 8: FACING WEST

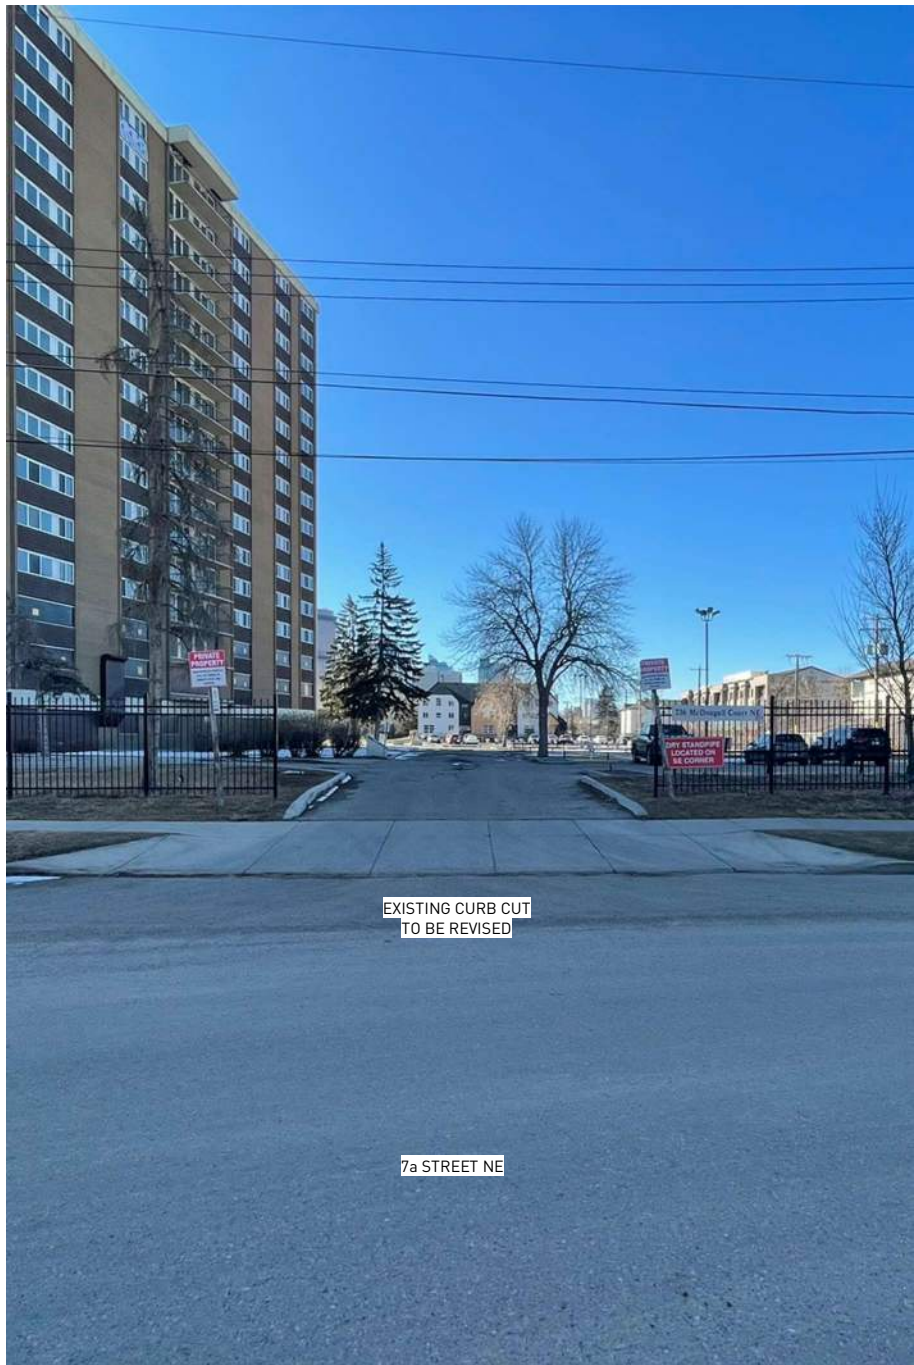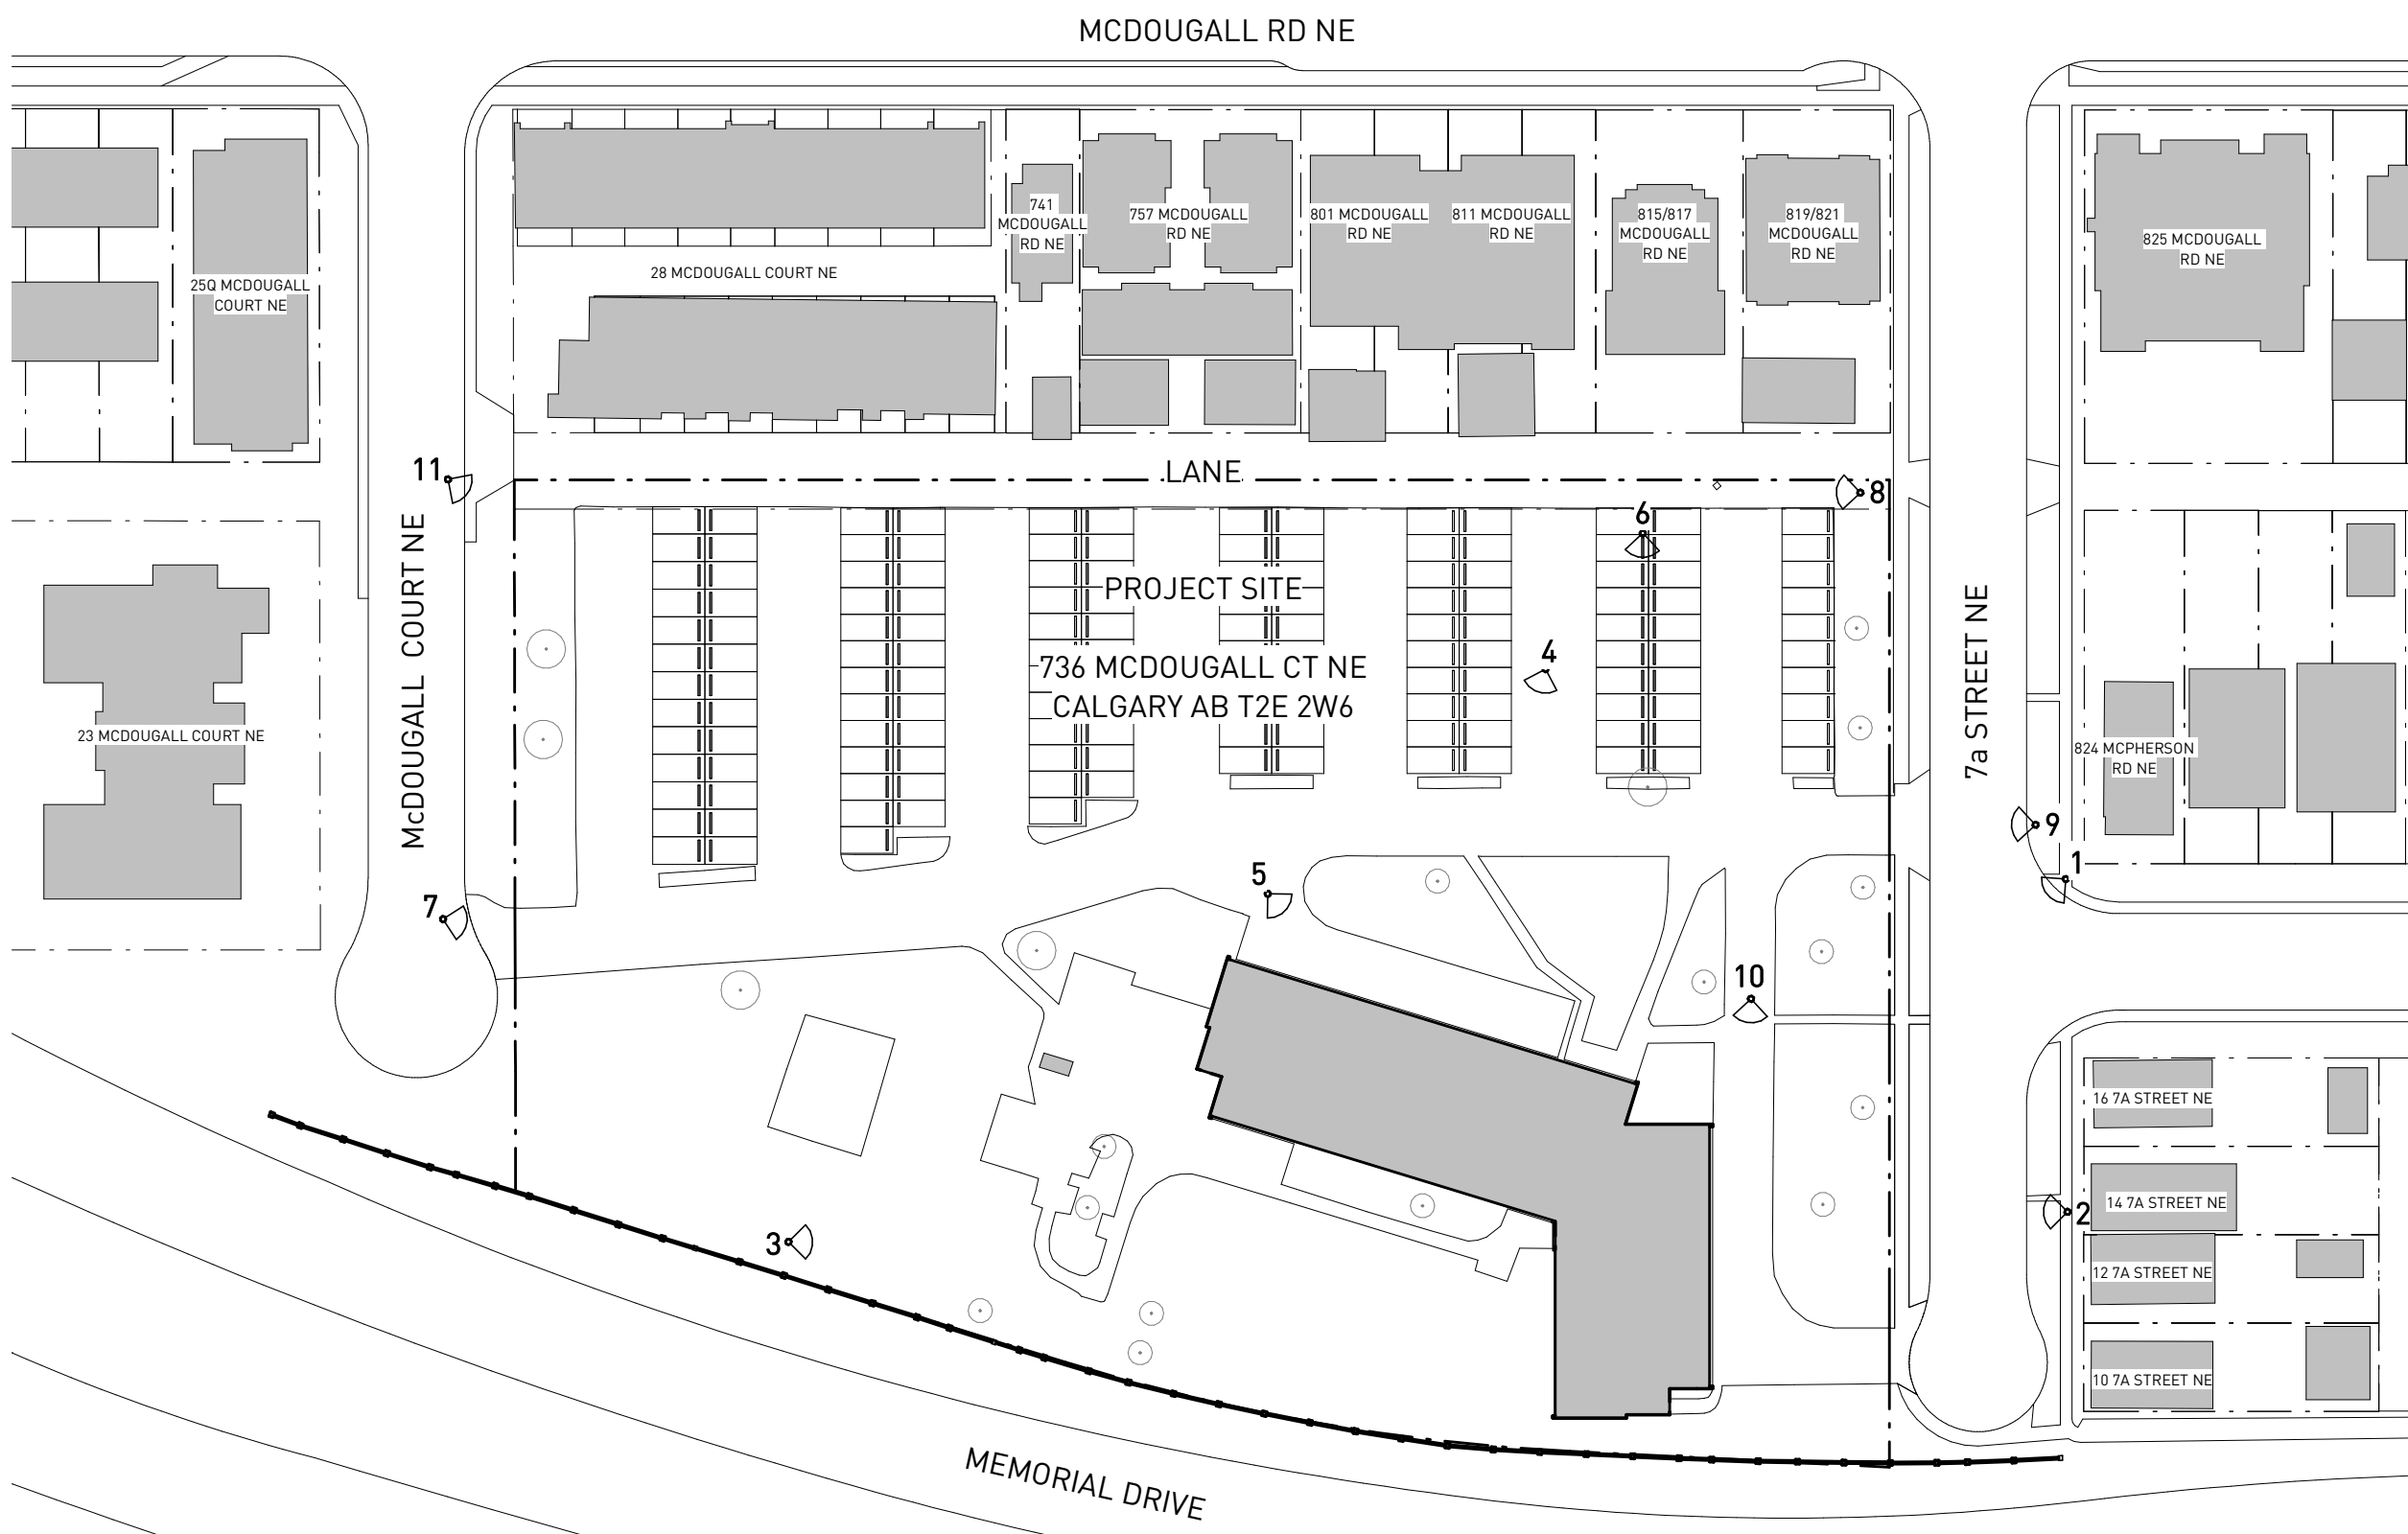

EXISTING SITE PHOTO 9: FACING WEST



EXISTING SITE PHOTO 10: FACING SOUTH



EXISTING SITE PHOTO 11: FACING SOUTHEAST

REVISION			DATE	DESCRIPTION
00			2025-12-18	DEVELOPMENT PERMIT
PROJECT NAME				
BRIDGELAND PLACE				
736 MCDOUGALL CT NE CALGARY AB T2E 2W6				
LOT		MCDUGALL RESERVE		
BLOCK		2		
PLAN		4301 R		
PROJECT NUMBER				
5310				
HINDLE ARCHITECTS SUITE 510 - 237 8 AVENUE SE CALGARY - ALBERTA - CANADA				
CONTACT				
MR. DOUG CARROLL 604.785.8964 doug@hindle-architects.com				
DO NOT SCALE FROM DRAWING. THE AUTHOR OF THIS DRAWING TAKES NO RESPONSIBILITY FOR ANY DIMENSIONS OBTAINED BY MEASURING OR SCALING FROM THIS DRAWING AND NO RELIANCE MAY BE PLACED ON SUCH DIMENSIONS. IF NO DIMENSION IS GIVEN, IT IS THE RESPONSIBILITY OF THE RECIPIENT TO ASCERTAIN THE DIMENSION SPECIFICALLY FROM THE AUTHOR OR BY SITE MEASUREMENT.				
THE SIZING OF ALL STRUCTURAL AND SERVICE ELEMENTS MUST ALWAYS BE CHECKED AGAINST THE RELEVANT CONSULTANT'S DRAWINGS. NO RELIANCE SHOULD BE PLACED UPON SIZING INFORMATION SHOWN ON THIS DRAWING.				
COPYRIGHT: THE DOCUMENT HEREIN, INCLUDING BUT NOT LIMITED TO PLANS, SKETCHES, GRAPHIC REPRESENTATIONS, AND SPECIFICATIONS IS PROTECTED BY COPYRIGHT LAW AND MAY NOT BE USED, REPRODUCED IN ANY FORM OR MANNER, OR REVISED EXCEPT WITH WRITTEN PERMISSION FROM HINDLE ARCHITECTS LTD.				
REPORT ANY ERRORS OR OMISSIONS TO THE ARCHITECT PRIOR TO COMMENCEMENT OF THE WORK.				
DRAWING PURPOSE				
DEVELOPMENT PERMIT				
DRAWN BY		CHECKED BY		AUTHORIZED BY
HA				
STAMP				
NORTH				
PROJECT NORTH				
DRAWING TITLE				
SITE PHOTOS				
DRAWING NUMBER				
A-0600.0				
DRAWING DATE		SCALE @ ARCH D		
2025-12-18				
REVISION DATE		REVISION NUMBER		
2025-12-18		00		

DEVELOPMENT
PERMIT
DECISION
RENDERED
ON THIS PLAN



RENDERINGS ILLUSTRATE DESIGN INTENT ONLY AND ARE SUBJECT TO CHANGE




RENDERINGS ILLUSTRATE DESIGN INTENT ONLY AND ARE SUBJECT TO CHANGE



RENDERINGS ILLUSTRATE DESIGN INTENT ONLY AND ARE SUBJECT TO CHANGE



RENDERINGS ILLUSTRATE DESIGN INTENT ONLY AND ARE SUBJECT TO CHANGE

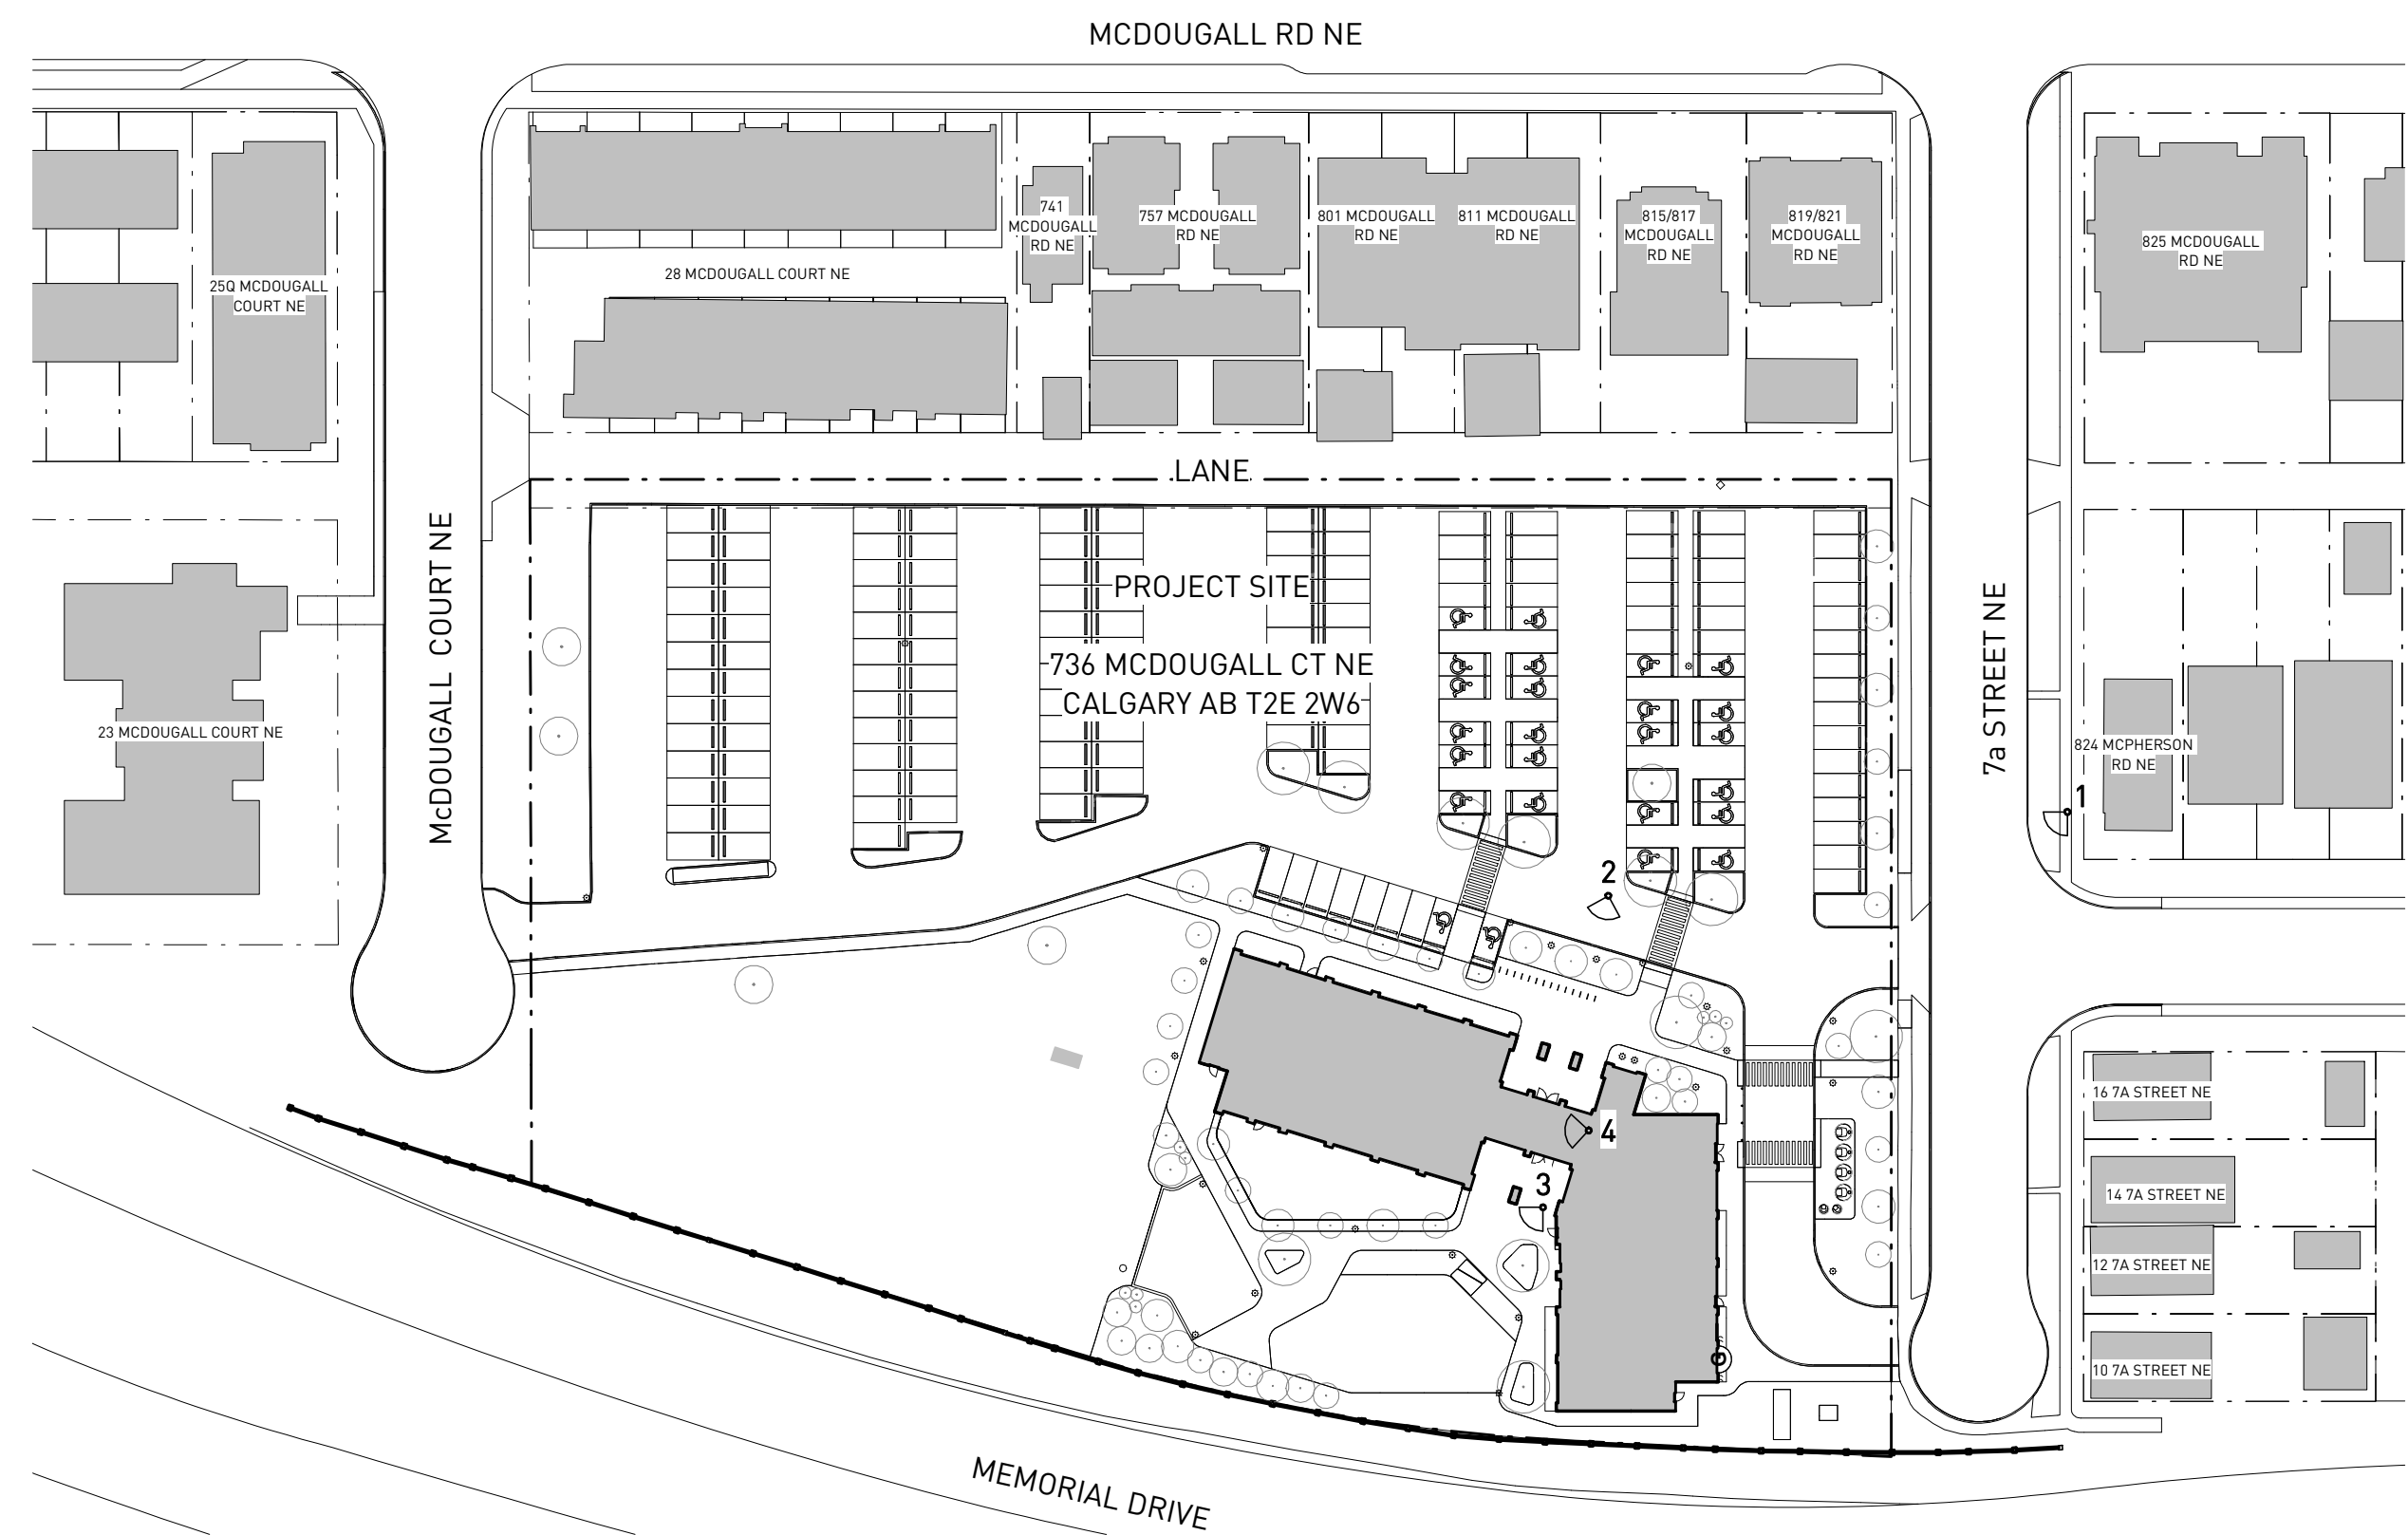

REVISION	DATE	DESCRIPTION
00	2025-12-18	DEVELOPMENT PERMIT

PROJECT NAME

BRIDGELAND PLACE

736 MCDUGALL CT NE
CALGARY AB T2E 2W6

LOT
BLOCK
PLAN

MCDUGALL RESERVE
2
4301 R

5310

HINDLE ARCHITECTS
SUITE 510 - 237 8 AVENUE SE
CALGARY - ALBERTA - CANADA

CONTACT

MR. DOUG CARROLL
604.785.8964
doug@hindle-architects.com

DO NOT SCALE FROM DRAWING. THE AUTHOR OF THIS DRAWING TAKES NO RESPONSIBILITY FOR ANY DIMENSIONS OBTAINED BY MEASURING OR SCALING FROM THIS DRAWING AND NO RELIANCE MAY BE PLACED ON SUCH DIMENSIONS. IF NO DIMENSION IS GIVEN, IT IS THE RESPONSIBILITY OF THE RECIPIENT TO ASCERTAIN THE DIMENSION SPECIFICALLY FROM THE AUTHOR OR BY SITE MEASUREMENT.

THE SIZING OF ALL STRUCTURAL AND SERVICE ELEMENTS MUST ALWAYS BE CHECKED AGAINST THE RELEVANT CONSULTANT'S DRAWINGS. NO RELIANCE SHOULD BE PLACED UPON SIZING INFORMATION SHOWN ON THIS DRAWING.

COPYRIGHT: THE DOCUMENT HEREIN, INCLUDING BUT NOT LIMITED TO PLANS, SKETCHES, GRAPHIC REPRESENTATIONS, AND SPECIFICATIONS IS PROTECTED BY COPYRIGHT LAW AND MAY NOT BE USED, REPRODUCED IN ANY FORM OR MANNER, OR REVISED EXCEPT WITH WRITTEN PERMISSION FROM HINDLE ARCHITECTS LTD.

REPORT ANY ERRORS OR OMISSIONS TO THE ARCHITECT PRIOR TO COMMENCEMENT OF THE WORK.

DRAWING PURPOSE

DEVELOPMENT PERMIT

DRAWN BY HA	CHECKED BY	AUTHORIZED BY
----------------	------------	---------------

STAMP

NORTH	PROJECT NORTH
-------	---------------


DRAWING TITLE

PROPOSED RENDERINGS

DRAWING NUMBER

A-0700.0

DRAWING DATE 2025-12-18	SCALE @ ARCH D
REVISION DATE 2025-12-18	REVISION NUMBER 00

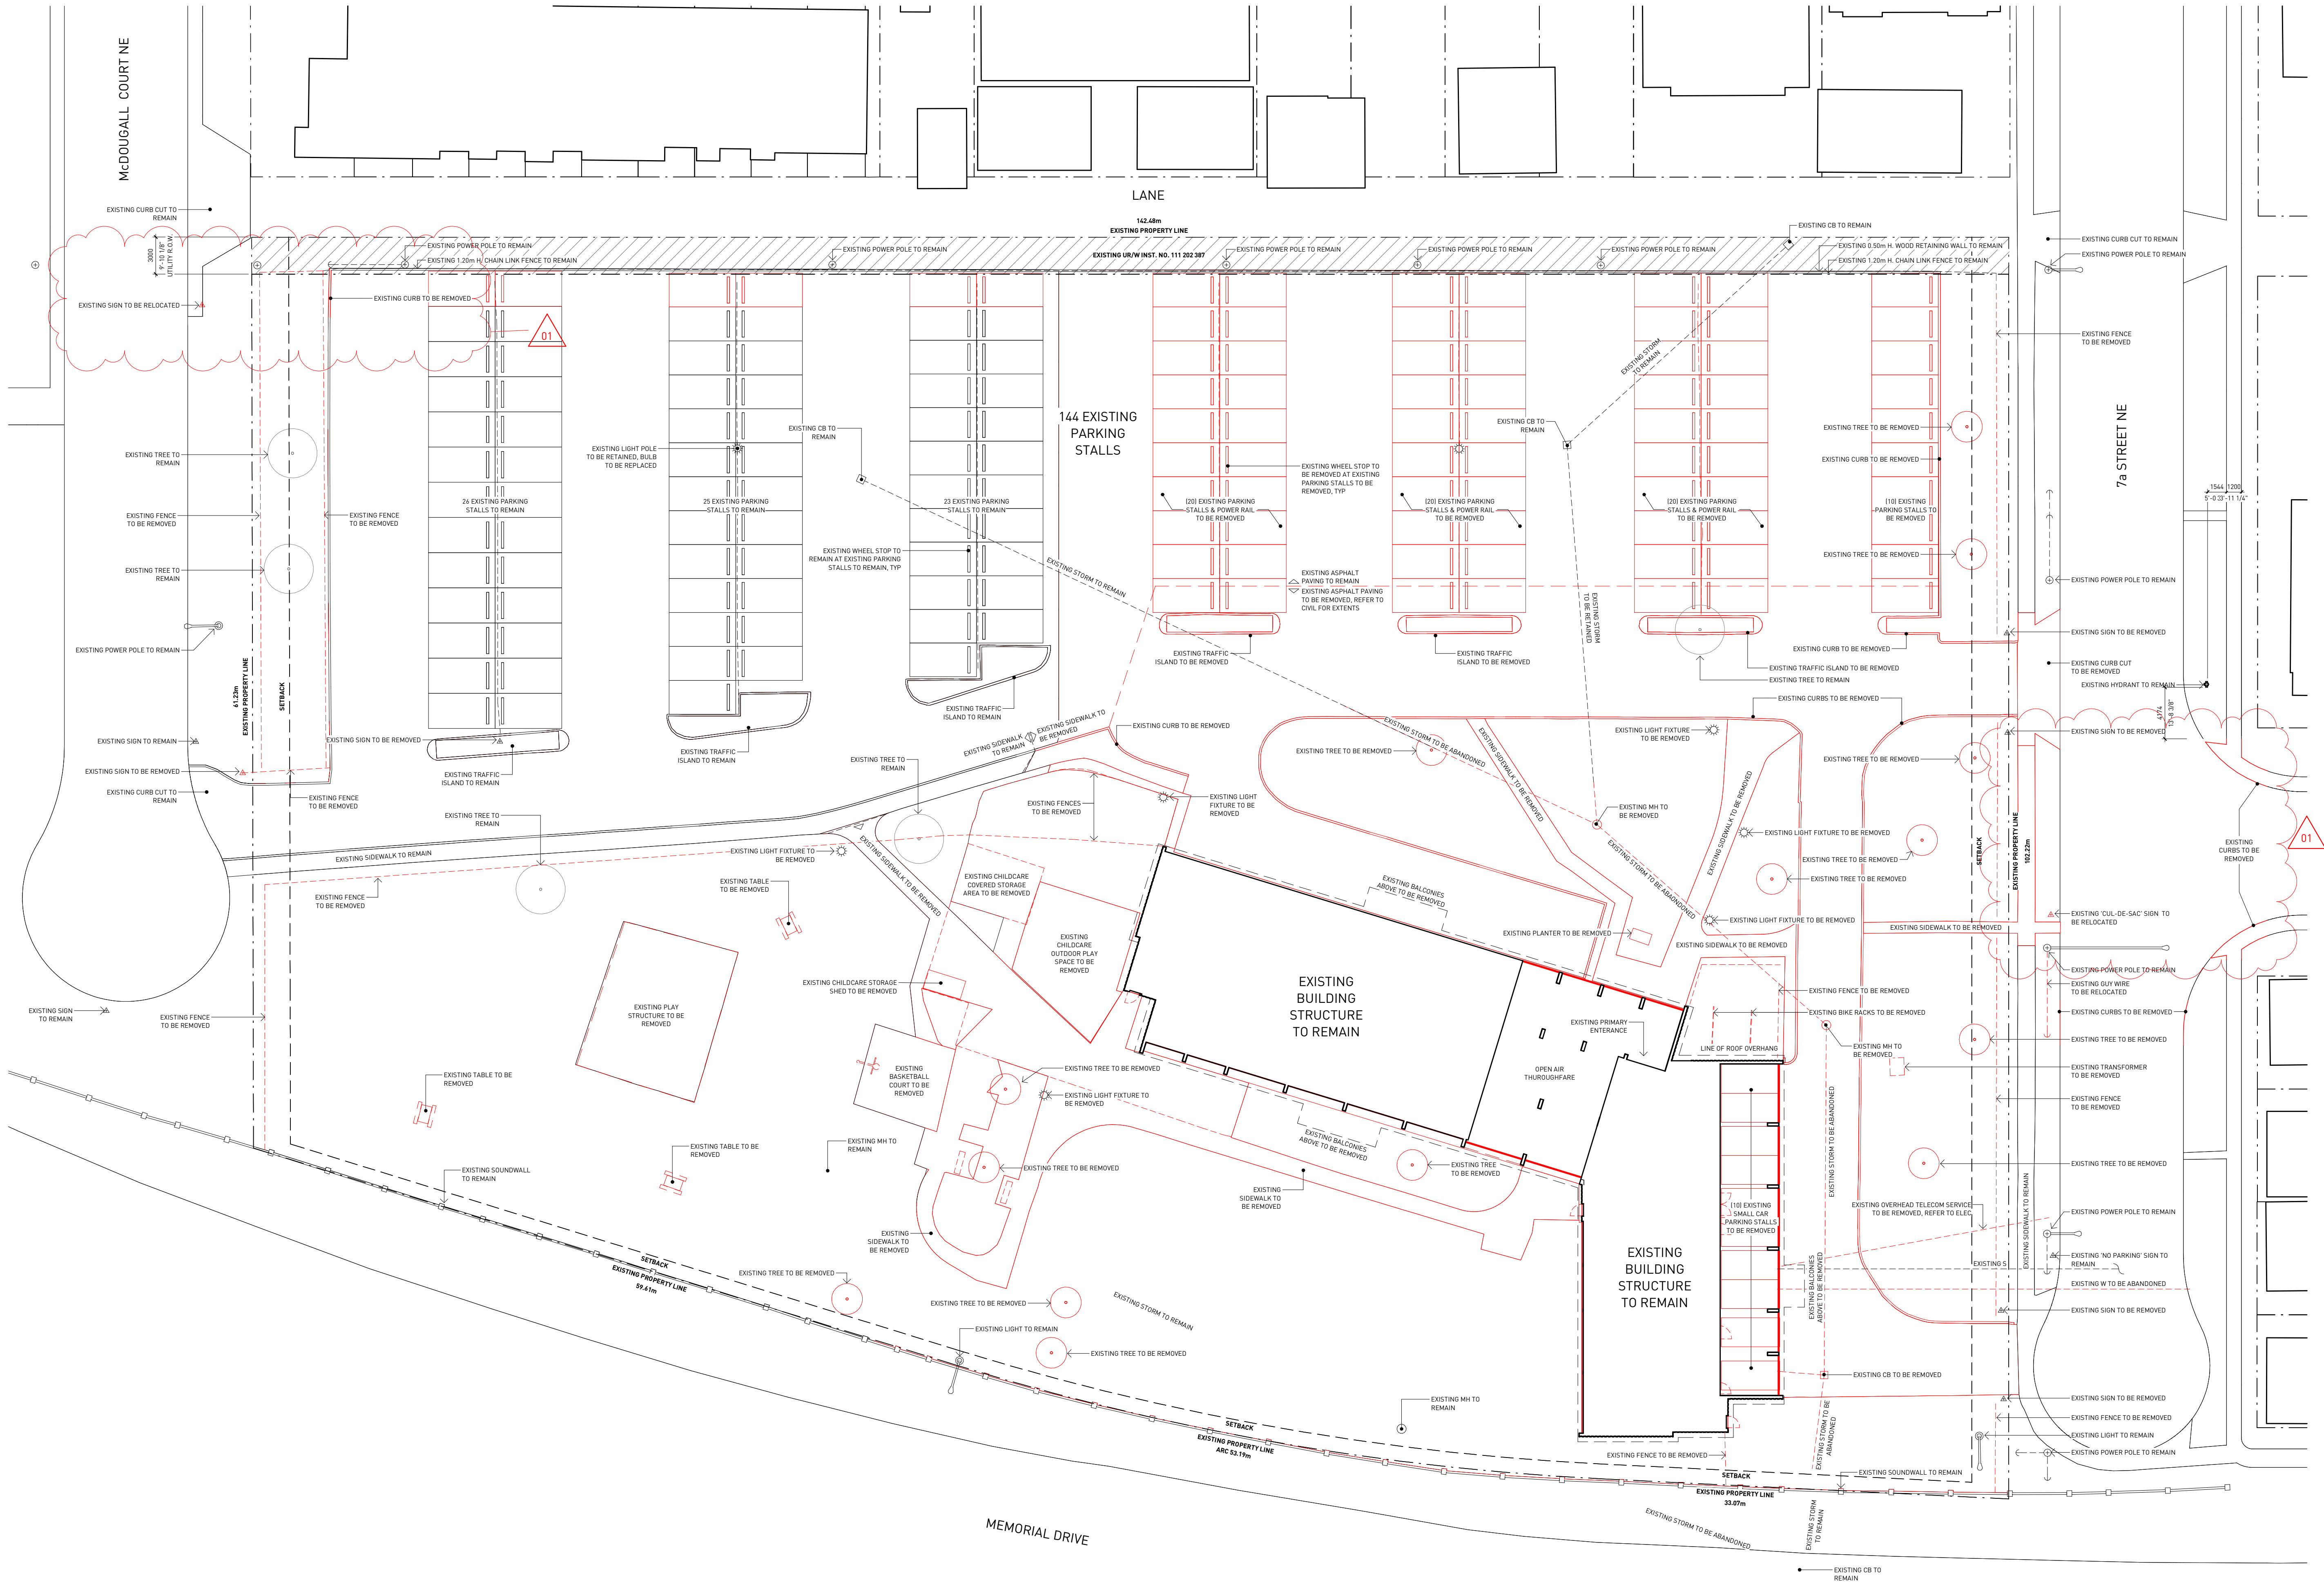

DEVELOPMENT
PERMIT
DECISION
RENDERED
ON THIS PLAN

DEMO DRAWING LEGEND	
	RED LINES INDICATE EXISTING ELEMENTS TO BE REMOVED
	BLACK LINES INDICATE EXISTING ELEMENTS TO BE RETAINED

REVISION	DATE	DESCRIPTION
00	2025-12-10	DEVELOPMENT PERMIT
01	2026-06-24	DR 2 RESPONSE

PROJECT NAME
BRIDGELAND PLACE

73& MCDUGALL CT NE
CALGARY AB T2E 2W6

PLAN
BLOCK

4301 R
MCDUGALL RESERVE

PROJECT NUMBER
5310

HINDLE ARCHITECTS
SUITE 510 - 237 8 AVENUE SE
CALGARY - ALBERTA - CANADA

CONTACT
MS. AMBER LAFONTAINE
403.804.7592
amber@hindle-architects.com

DO NOT SCALE FROM DRAWING. THE AUTHOR OF THIS DRAWING TAKES NO RESPONSIBILITY FOR ANY DIMENSIONS OBTAINED BY MEASURING OR SCALING FROM THIS DRAWING AND NO RELIANCE MAY BE PLACED ON SUCH DIMENSIONS. IF NO DIMENSION IS GIVEN, IT IS THE RESPONSIBILITY OF THE RECIPIENT TO ASCERTAIN THE DIMENSION SPECIFICALLY FROM THE AUTHOR OR BY SITE MEASUREMENT.

THE SIZING OF ALL STRUCTURAL AND SERVICE ELEMENTS MUST ALWAYS BE CHECKED AGAINST THE RELEVANT CONSULTANT'S DRAWINGS. NO RELIANCE SHOULD BE PLACED UPON SIZING INFORMATION SHOWN ON THIS DRAWING.


COPYRIGHT: THE DOCUMENT HEREIN, INCLUDING BUT NOT LIMITED TO PLANS, SKETCHES, GRAPHIC REPRESENTATIONS, AND SPECIFICATIONS IS PROTECTED BY COPYRIGHT LAW AND MAY NOT BE USED, REPRODUCED IN ANY FORM OR MANNER, OR REVISED EXCEPT WITH WRITTEN PERMISSION FROM HINDLE ARCHITECTS LTD.

REPORT ANY ERRORS OR OMISSIONS TO THE ARCHITECT PRIOR TO COMMENCEMENT OF THE WORK.

DRAWING PURPOSE
DEVELOPMENT PERMIT - DR2

DRAWN BY	CHECKED BY	AUTHORIZED BY
HA	AL	JH



STAMP

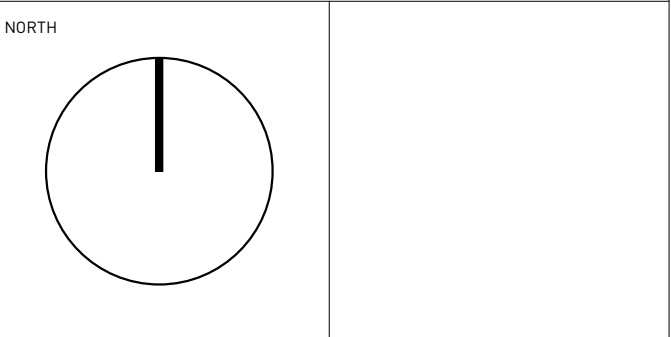


DRAWING TITLE
SITE PLAN - DEMOLITION

DRAWING NUMBER
A-1910.0

DRAWING DATE	SCALE @ ARCH D
2025-12-18	1:250
REVISION DATE	REVISION NUMBER
2026-06-24	01

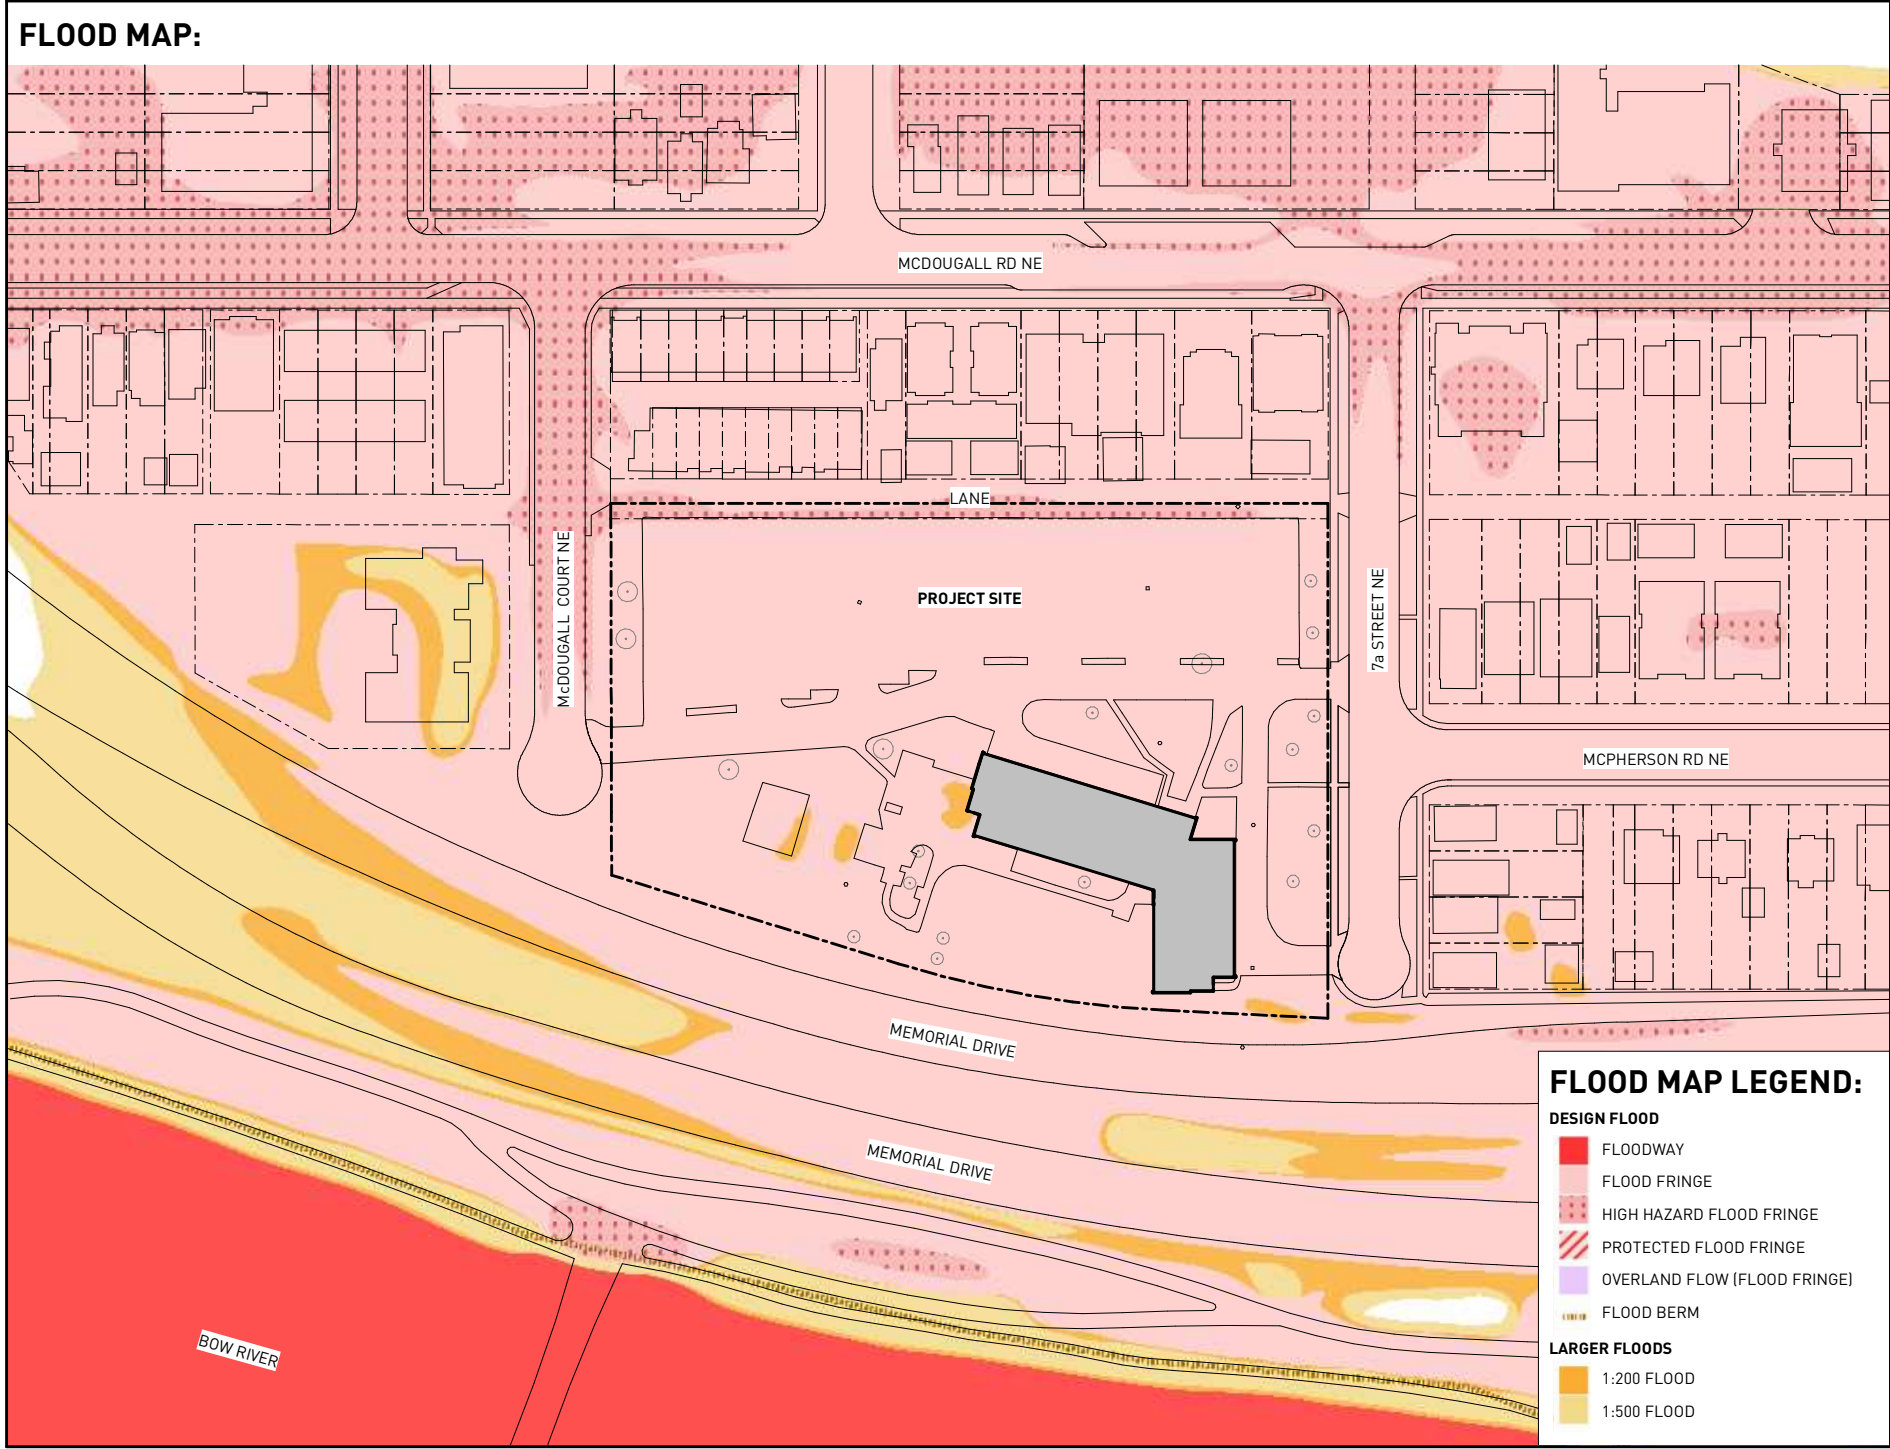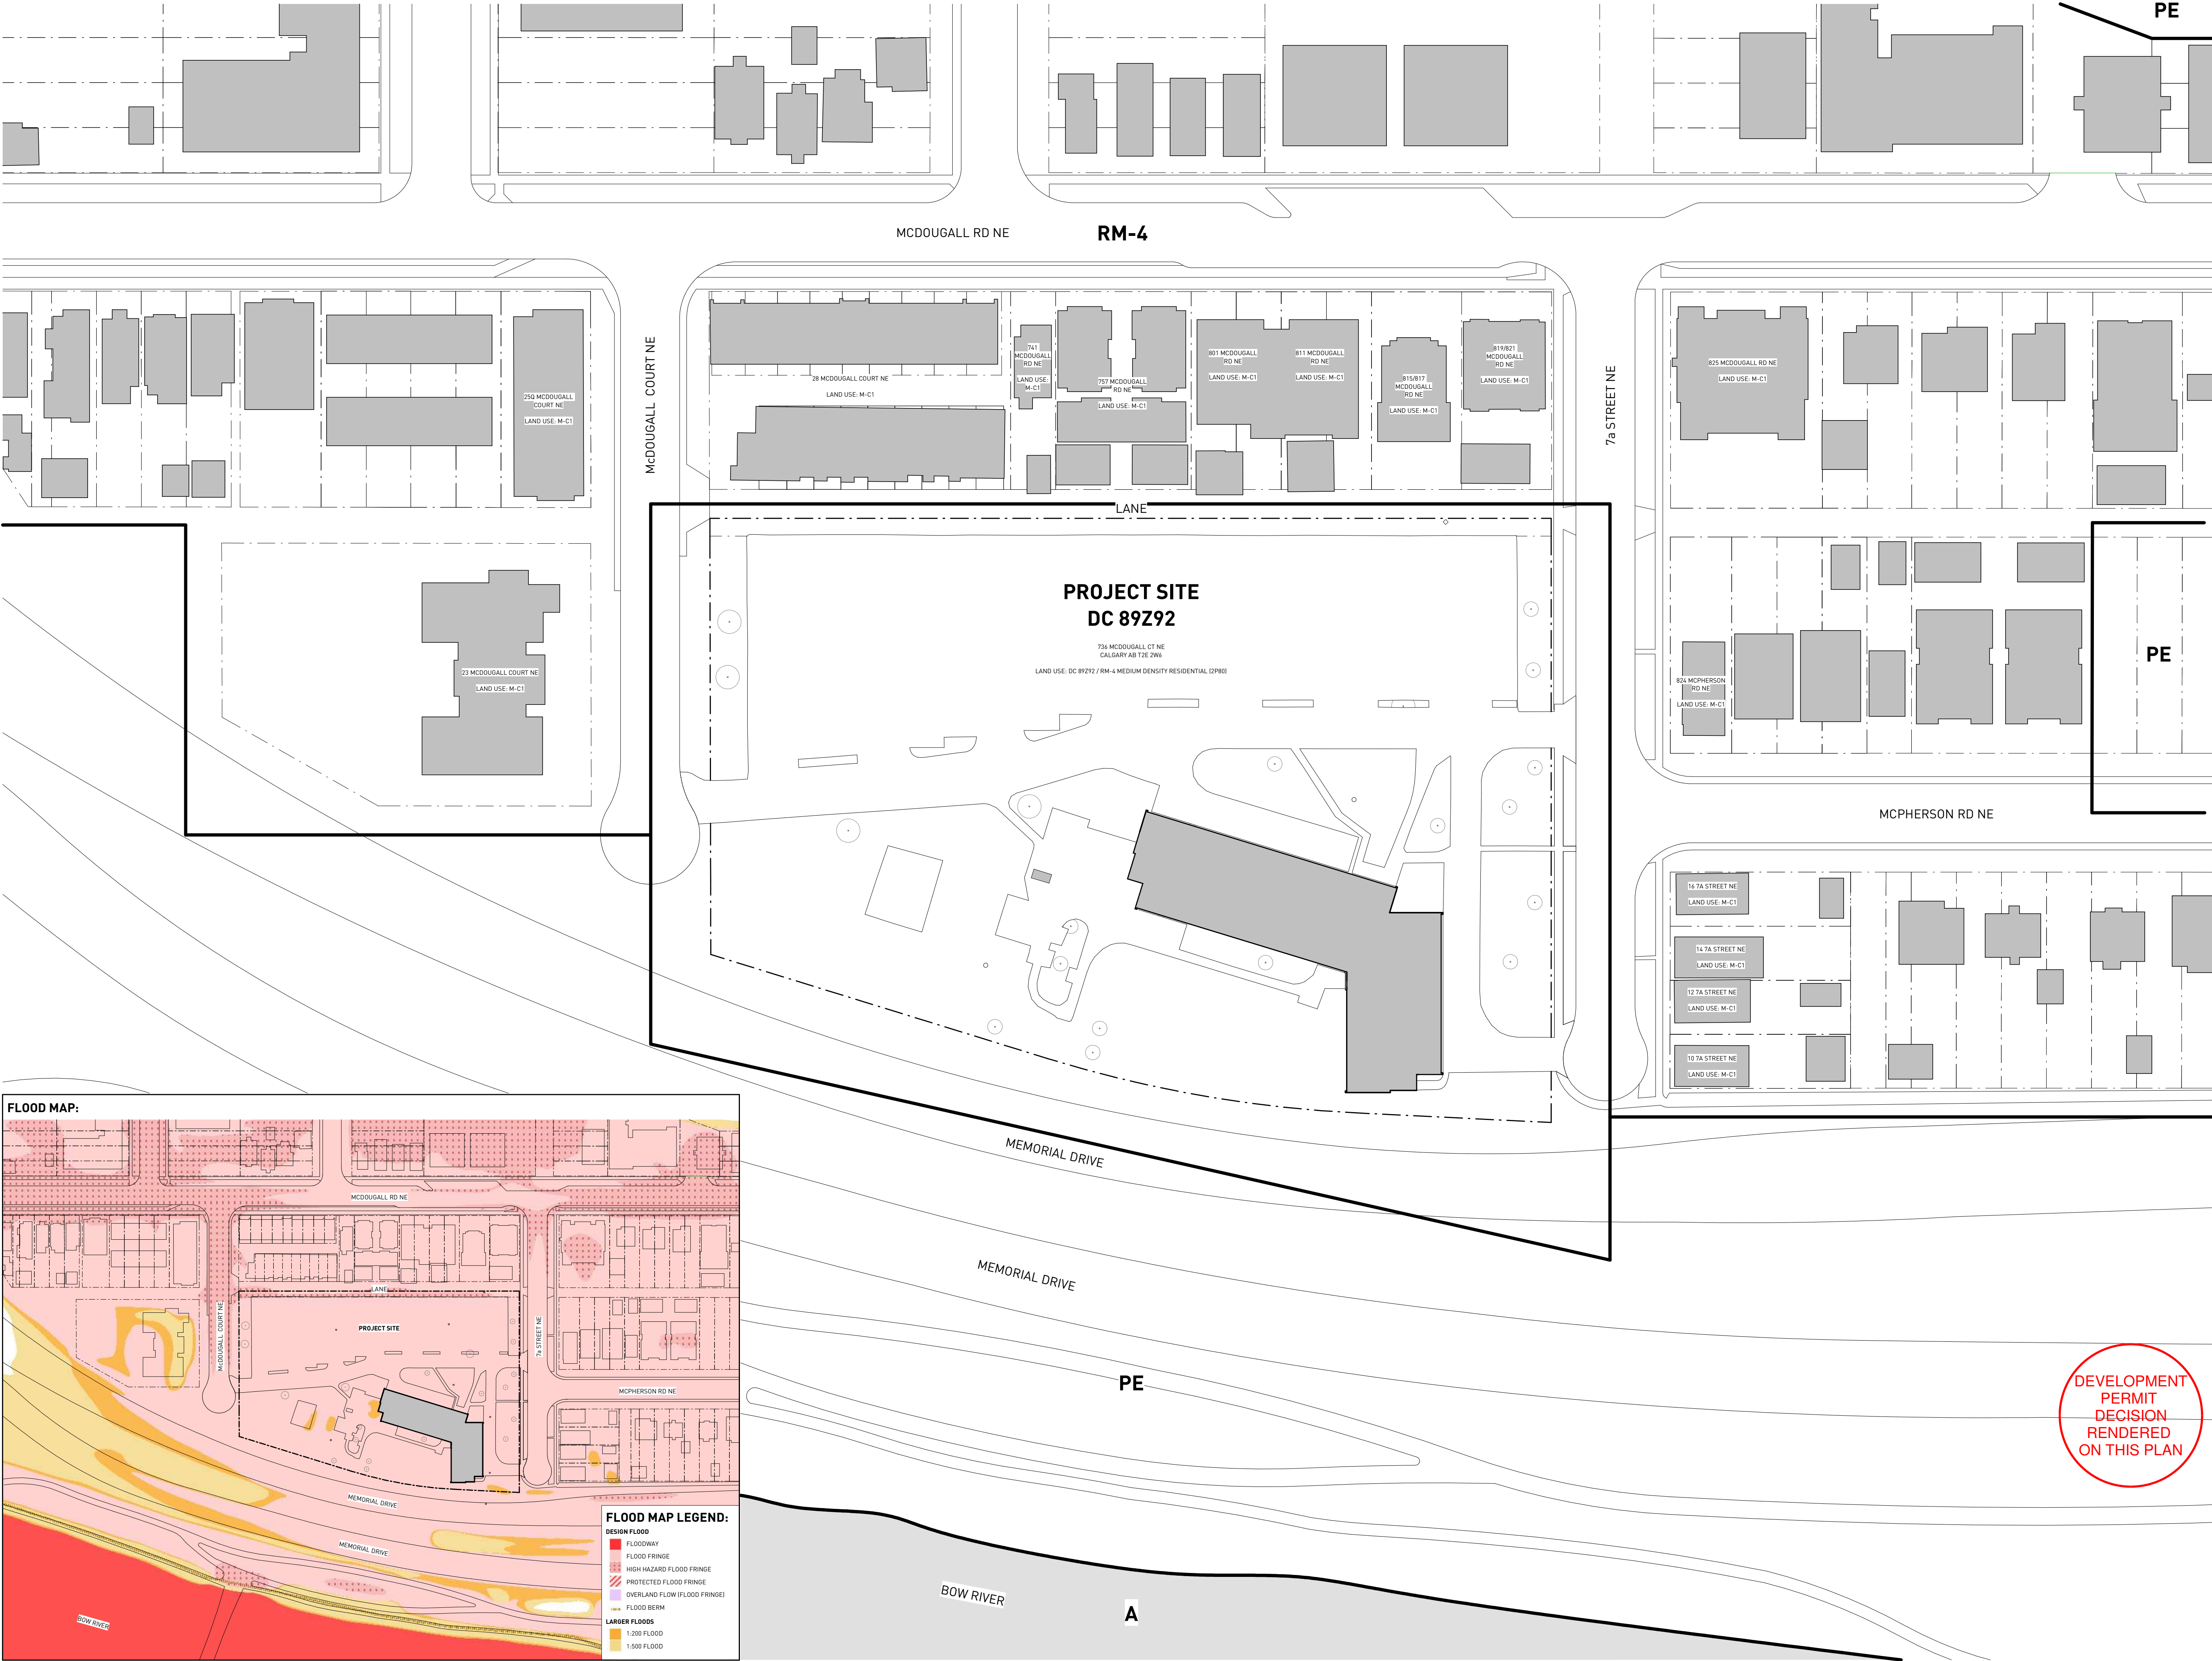

REVISION		DATE	DESCRIPTION
00		2025-12-18	DEVELOPMENT PERMIT
PROJECT NAME			
BRIDGELAND PLACE			
736 MCDougALL CT NE CALGARY AB T2E 2W6			
LOT		MCDougALL RESERVE	
BLOCK		2	
PLAN		4301 R	
PROJECT NUMBER			
5310			
HINDLE ARCHITECTS			
SUITE 510 - 237 8 AVENUE SE CALGARY - ALBERTA - CANADA			
CONTACT			
MR. DOUG CARROLL 604.785.8964 doug@hindle-architects.com			
DO NOT SCALE FROM DRAWING. THE AUTHOR OF THIS DRAWING TAKES NO RESPONSIBILITY FOR ANY DIMENSIONS OBTAINED BY MEASURING OR SCALING FROM THIS DRAWING AND NO RELIANCE MAY BE PLACED ON SUCH DIMENSIONS. IF NO DIMENSION IS GIVEN, IT IS THE RESPONSIBILITY OF THE RECIPIENT TO ASCERTAIN THE DIMENSION SPECIFICALLY FROM THE AUTHOR OR BY SITE MEASUREMENT.			
THE SIZING OF ALL STRUCTURAL AND SERVICE ELEMENTS MUST ALWAYS BE CHECKED AGAINST THE RELEVANT CONSULTANT'S DRAWINGS. NO RELIANCE SHOULD BE PLACED UPON SIZING INFORMATION SHOWN ON THIS DRAWING.			
COPYRIGHT: THE DOCUMENT HEREIN, INCLUDING BUT NOT LIMITED TO PLANS, SKETCHES, GRAPHIC REPRESENTATIONS, AND SPECIFICATIONS IS PROTECTED BY COPYRIGHT LAW AND MAY NOT BE USED, REPRODUCED IN ANY FORM OR MANNER, OR REVISED EXCEPT WITH WRITTEN PERMISSION FROM HINDLE ARCHITECTS LTD.			
REPORT ANY ERRORS OR OMISSIONS TO THE ARCHITECT PRIOR TO COMMENCEMENT OF THE WORK.			
DRAWING PURPOSE			
DEVELOPMENT PERMIT			
DRAWN BY	CHECKED BY	AUTHORIZED BY	
HA			
STAMP			
NORTH		PROJECT NORTH	
			
DRAWING TITLE			
CONTEXT PLAN			
DRAWING NUMBER			
A-2000.0			
DRAWING DATE		SCALE & ARCH D	
2025-12-18		1:500	
REVISION DATE		REVISION NUMBER	
2025-12-18		00	

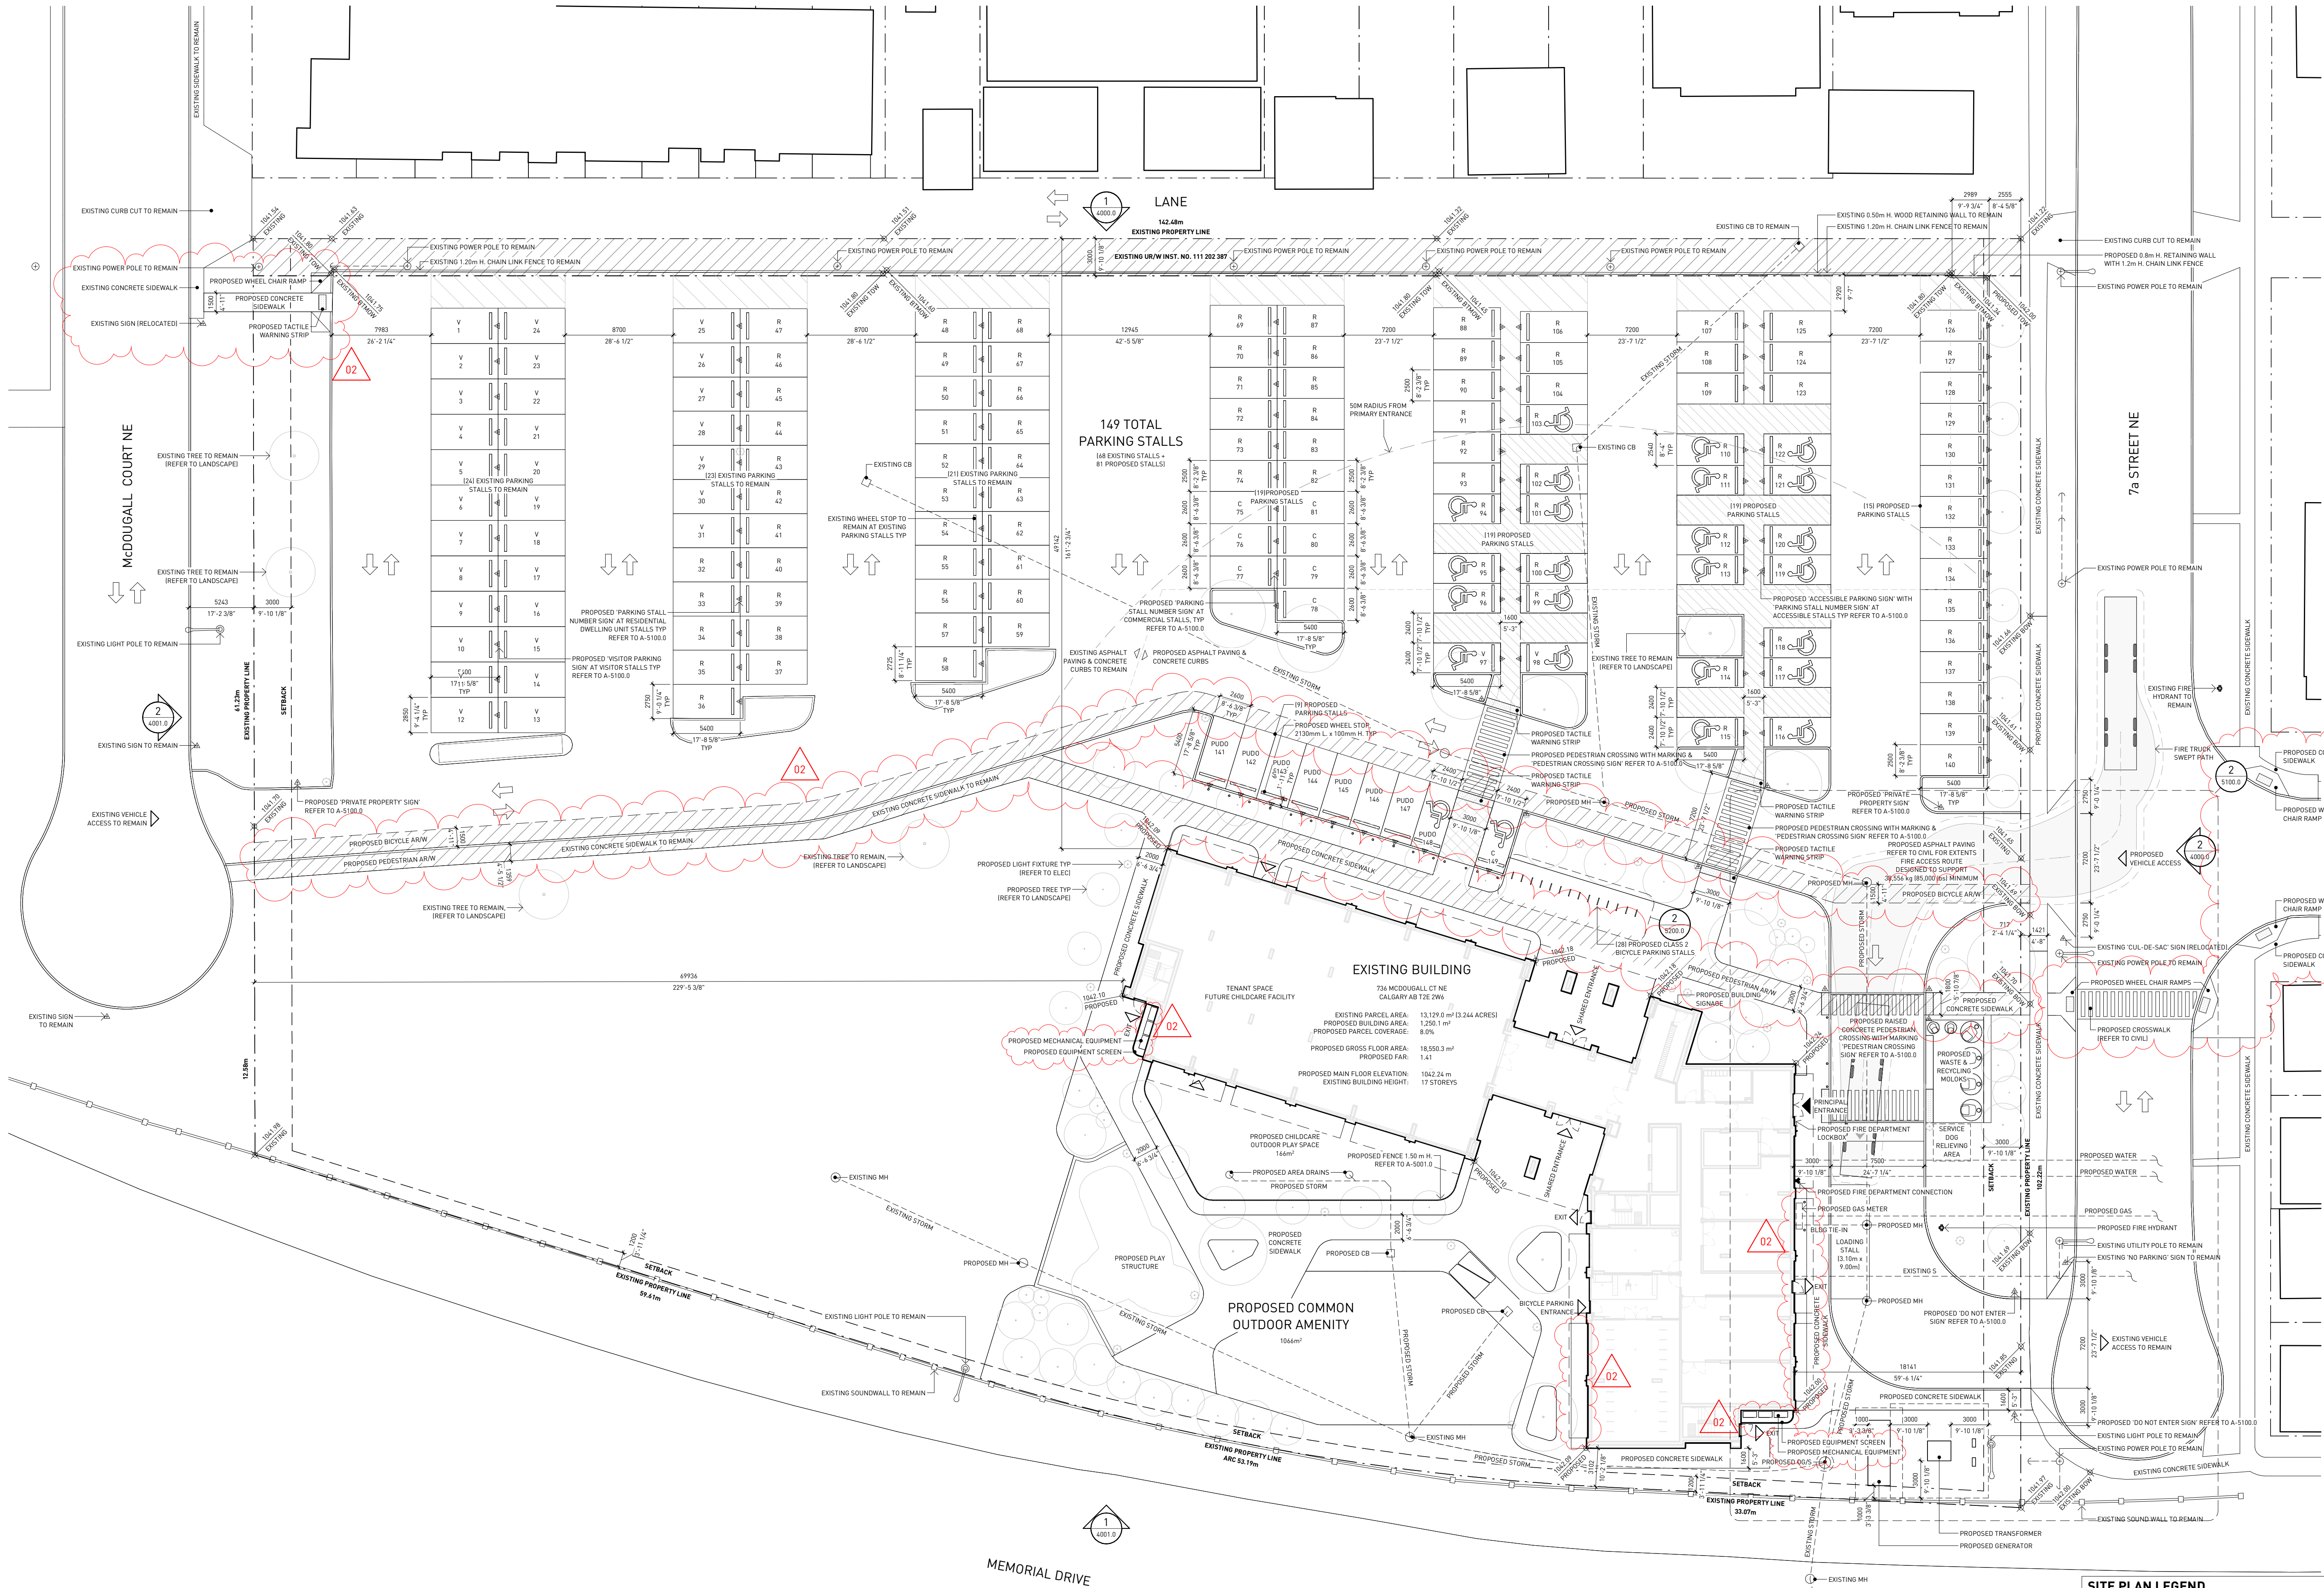

SITE PLAN LEGEND		
PARKING LEGEND		
TYPE	DESCRIPTION	COUNT
C	COMMERCIAL STALLS	8
PUDO	COMMERCIAL PICK-UP/DROP-OFF STALLS	8
R	RESIDENTIAL DWELLING UNIT STALLS	102
V	RESIDENTIAL VISITOR STALLS	31
GRAPHIC LEGEND		
⊙	SITE LIGHT FIXTURE, REFER TO ELEC	
⊖	POWER POLE	
—	GUY WIRE	
△	SIGN	

REVISION	DATE	DESCRIPTION
00	2025-12-10	DEVELOPMENT PERMIT
01	2026-03-10	DR 1 RESPONSE
02	2026-06-24	DR 2 RESPONSE

PROJECT NAME
BRIDGELAND PLACE
736 MCDOUGALL CT NE
CALGARY AB T2E 2W6
PLAN BLOCK 4301 R
BLOCK MCDOUGALL RESERVE

PROJECT NUMBER
5310

HINDLE ARCHITECTS
SUITE 510 - 237 8 AVENUE SE
CALGARY - ALBERTA - CANADA

CONTACT
MS. AMBER LAFONTAINE
403.804.7592
amber@hindle-architects.com

DO NOT SCALE FROM DRAWING. THE AUTHOR OF THIS DRAWING TAKES NO RESPONSIBILITY FOR ANY DIMENSIONS OBTAINED BY MEASURING OR SCALING FROM THIS DRAWING AND NO RELIANCE MAY BE PLACED ON SUCH DIMENSIONS. IF NO DIMENSION IS GIVEN, IT IS THE RESPONSIBILITY OF THE RECIPIENT TO ASCERTAIN THE DIMENSION SPECIFICALLY FROM THE AUTHOR OR BY SITE MEASUREMENT.

THE SIZING OF ALL STRUCTURAL AND SERVICE ELEMENTS MUST ALWAYS BE CHECKED AGAINST THE RELEVANT CONSULTANT'S DRAWINGS. NO RELIANCE SHOULD BE PLACED UPON SIZING INFORMATION SHOWN ON THIS DRAWING.


COPYRIGHT: THE DOCUMENT HEREIN, INCLUDING BUT NOT LIMITED TO PLANS, SKETCHES, GRAPHIC REPRESENTATIONS, AND SPECIFICATIONS IS PROTECTED BY COPYRIGHT LAW AND MAY NOT BE USED, REPRODUCED IN ANY FORM OR MANNER, OR REVISED EXCEPT WITH WRITTEN PERMISSION FROM HINDLE ARCHITECTS LTD.

REPORT ANY ERRORS OR OMISSIONS TO THE ARCHITECT PRIOR TO COMMENCEMENT OF THE WORK.

DRAWING PURPOSE
DEVELOPMENT PERMIT - DR2

DRAWN BY	CHECKED BY	AUTHORIZED BY
HA	AL	JH


STAMP

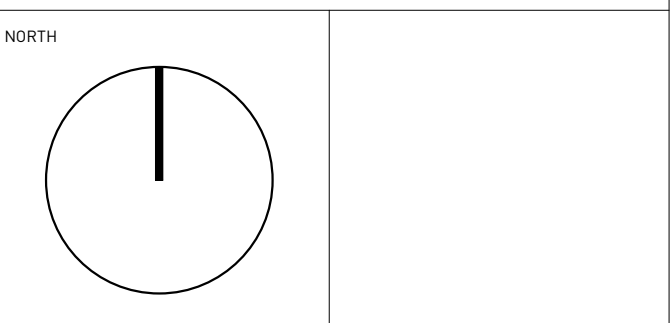


DRAWING TITLE
SITE PLAN
PROPOSED

DRAWING NUMBER
A-2100.0

DRAWING DATE	SCALE & ARCH D
2025-12-18	1:250
REVISION DATE	REVISION NUMBER
2026-06-24	02

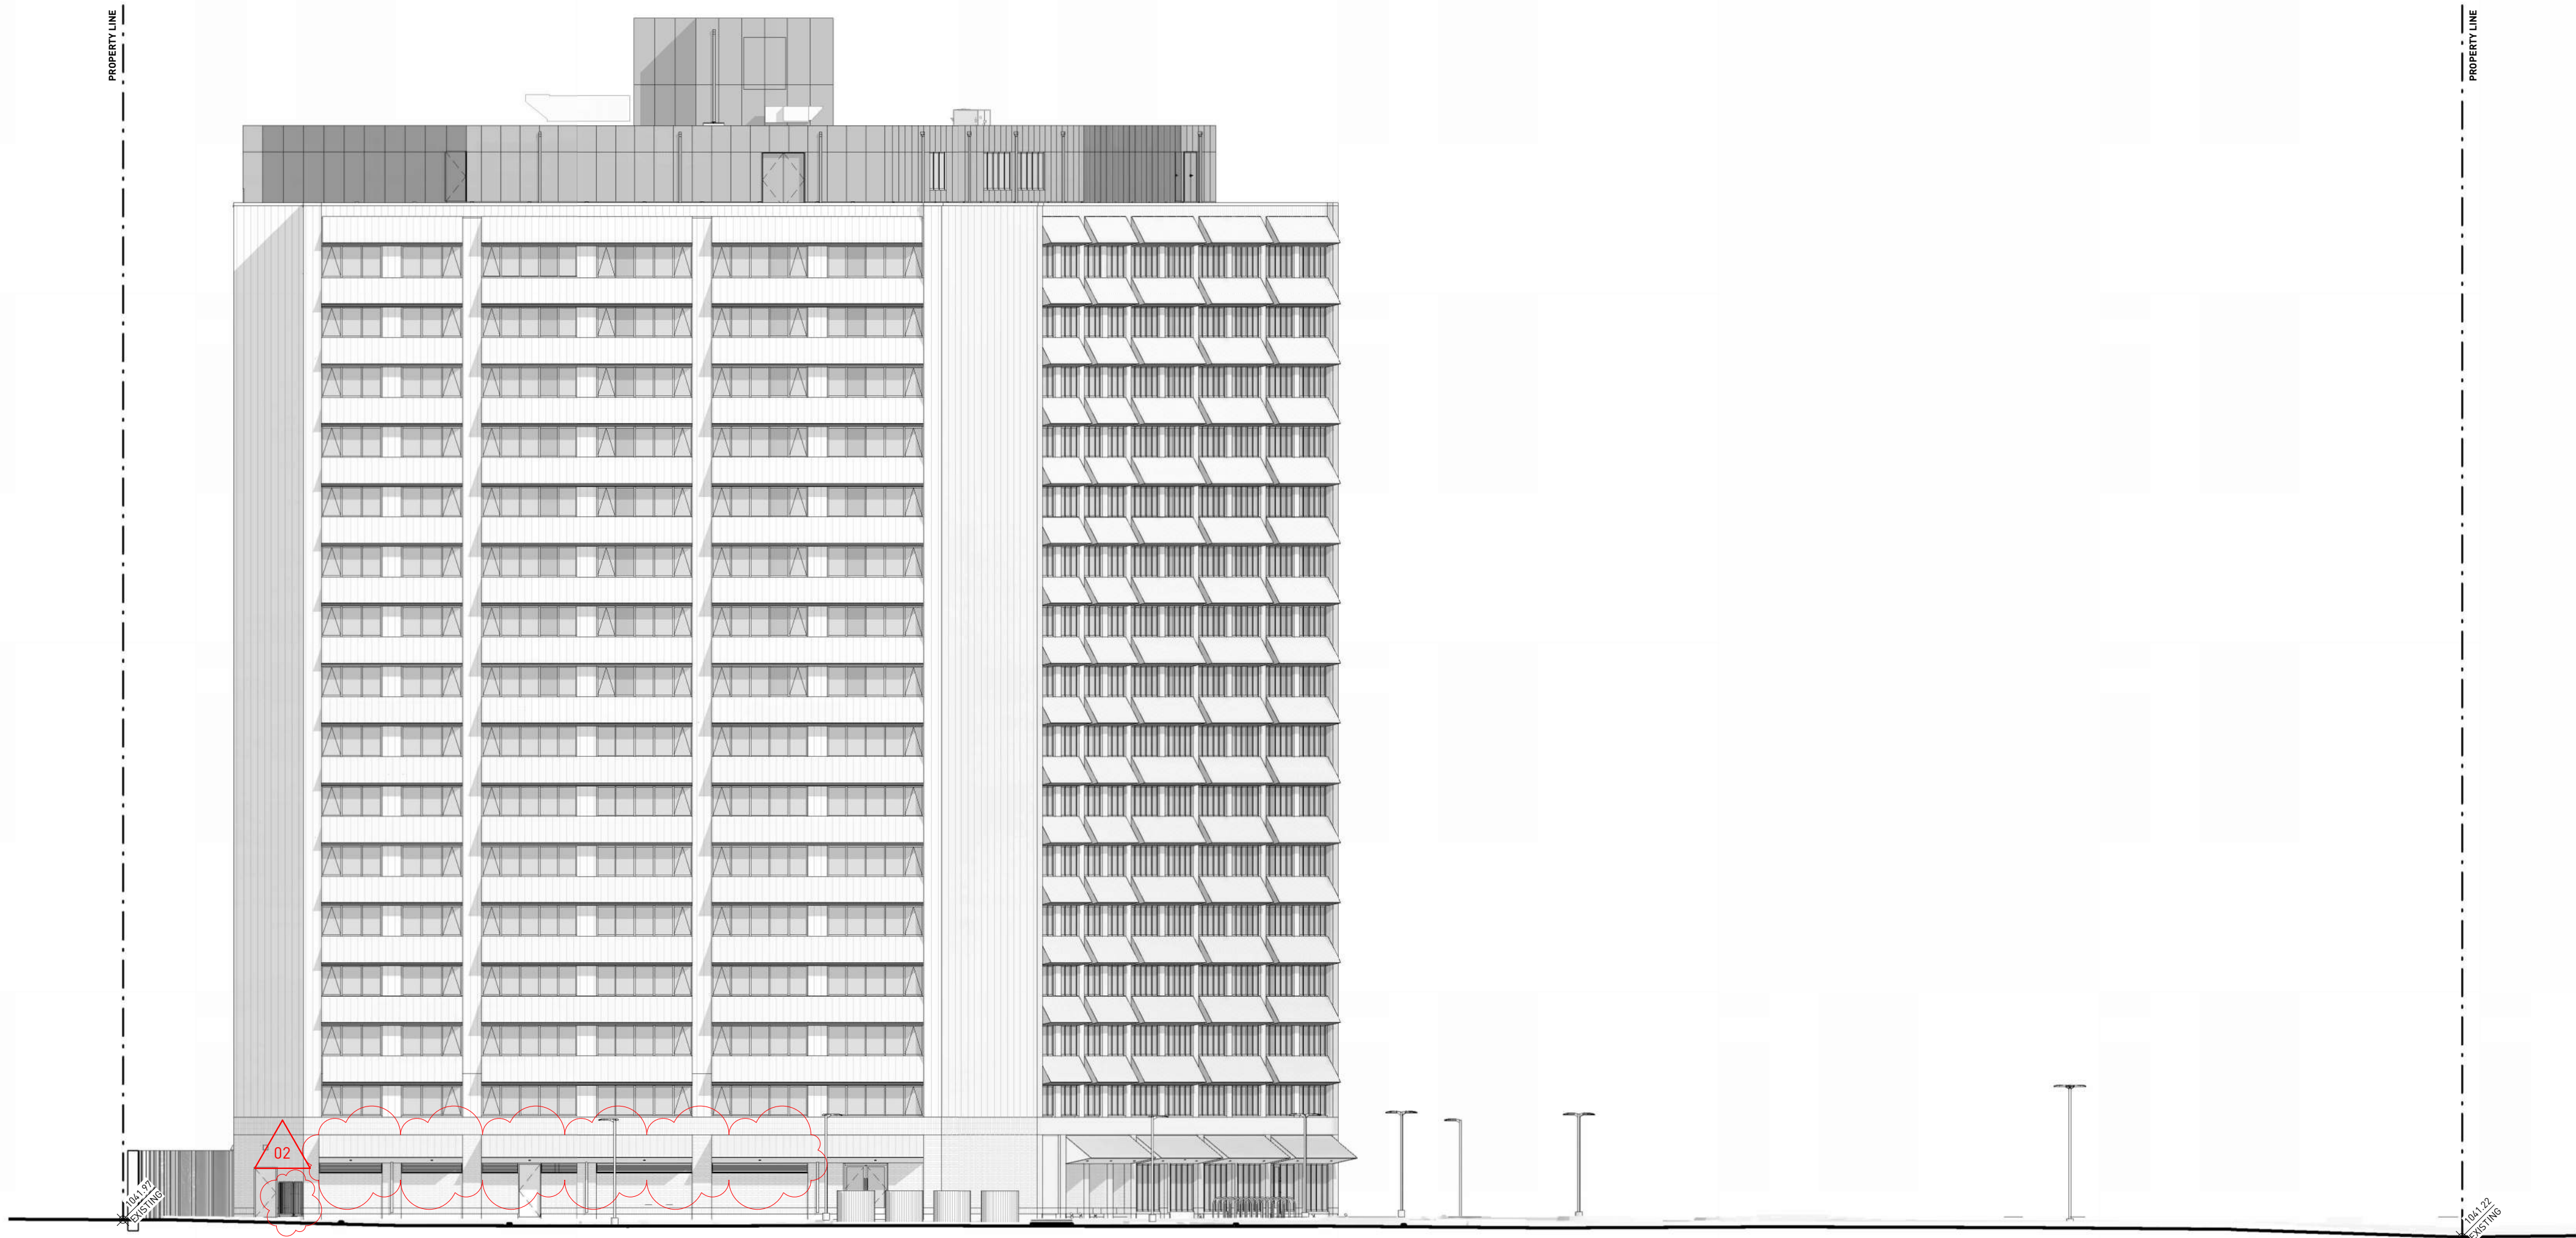



2 STREETScape ELEVATIONS
EAST ELEVATION 1 : 200

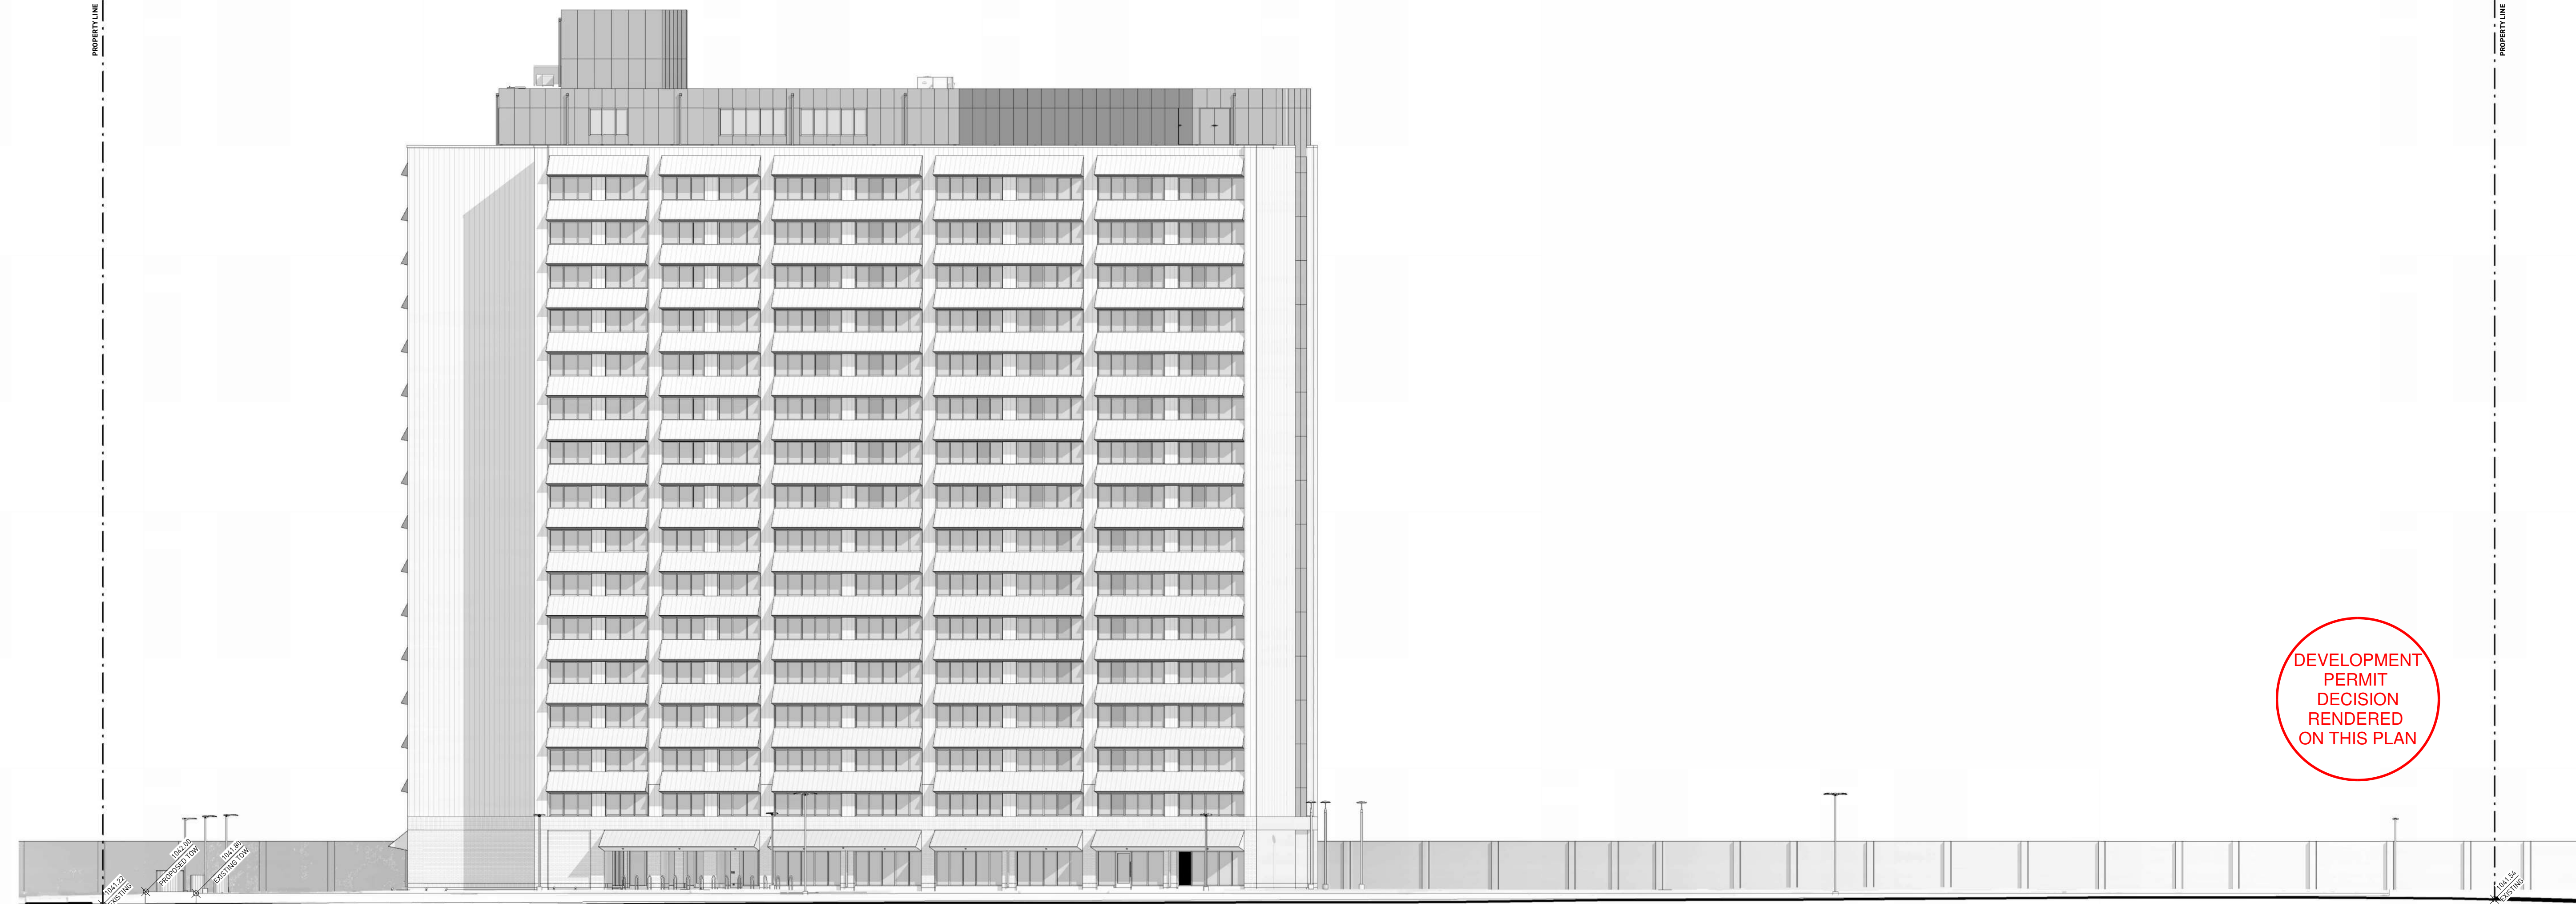

1 STREETScape ELEVATIONS
NORTH ELEVATION 1 : 200


REVISION	DATE	DESCRIPTION
00	2025-12-18	DEVELOPMENT PERMIT
01	2026-03-10	DR 1 RESPONSE
02	2026-06-24	DR 2 RESPONSE
PROJECT NAME		
BRIDGLAND PLACE		
736 MCDOUGALL CT NE CALGARY AB T2E 2W6		
PLAN BLOCK	4301 R MCDOUGALL RESERVE	
PROJECT NUMBER		
5310		
HINDLE ARCHITECTS SUITE 510 - 237 8 AVENUE SE CALGARY - ALBERTA - CANADA		
CONTACT		
MS. AMBER LAFONTAINE 403.804.7592 amber@hindle-architects.com		
DO NOT SCALE FROM DRAWING. THE AUTHOR OF THIS DRAWING TAKES NO RESPONSIBILITY FOR ANY DIMENSIONS OBTAINED BY MEASURING OR SCALING FROM THIS DRAWING AND NO RELIANCE MAY BE PLACED ON SUCH DIMENSIONS. IF NO DIMENSION IS GIVEN, IT IS THE RESPONSIBILITY OF THE RECIPIENT TO ASCERTAIN THE DIMENSION SPECIFICALLY FROM THE AUTHOR OR BY SITE MEASUREMENT.		
THE SIZING OF ALL STRUCTURAL AND SERVICE ELEMENTS MUST ALWAYS BE CHECKED AGAINST THE RELEVANT CONSULTANT'S DRAWINGS. NO RELIANCE SHOULD BE PLACED UPON SIZING INFORMATION SHOWN ON THIS DRAWING.		
COPYRIGHT: THE DOCUMENT HEREIN, INCLUDING BUT NOT LIMITED TO PLANS, SKETCHES, GRAPHIC REPRESENTATIONS, AND SPECIFICATIONS IS PROTECTED BY COPYRIGHT LAW AND MAY NOT BE USED, REPRODUCED IN ANY FORM OR MANNER, OR REVISED EXCEPT WITH WRITTEN PERMISSION FROM HINDLE ARCHITECTS LTD.		
REPORT ANY ERRORS OR OMISSIONS TO THE ARCHITECT PRIOR TO COMMENCEMENT OF THE WORK.		
DRAWING PURPOSE		
DEVELOPMENT PERMIT - DR2		
DRAWN BY	CHECKED BY	AUTHORIZED BY
HA	AL	JH
STAMP		
NORTH		
DRAWING TITLE		
GENERAL ARRANGEMENT ELEVATIONS		
DRAWING NUMBER		
A-4000.0		
DRAWING DATE	SCALE @ ARCH D	
2025-12-18	1:200	
REVISION DATE	REVISION NUMBER	
2026-06-24	02	

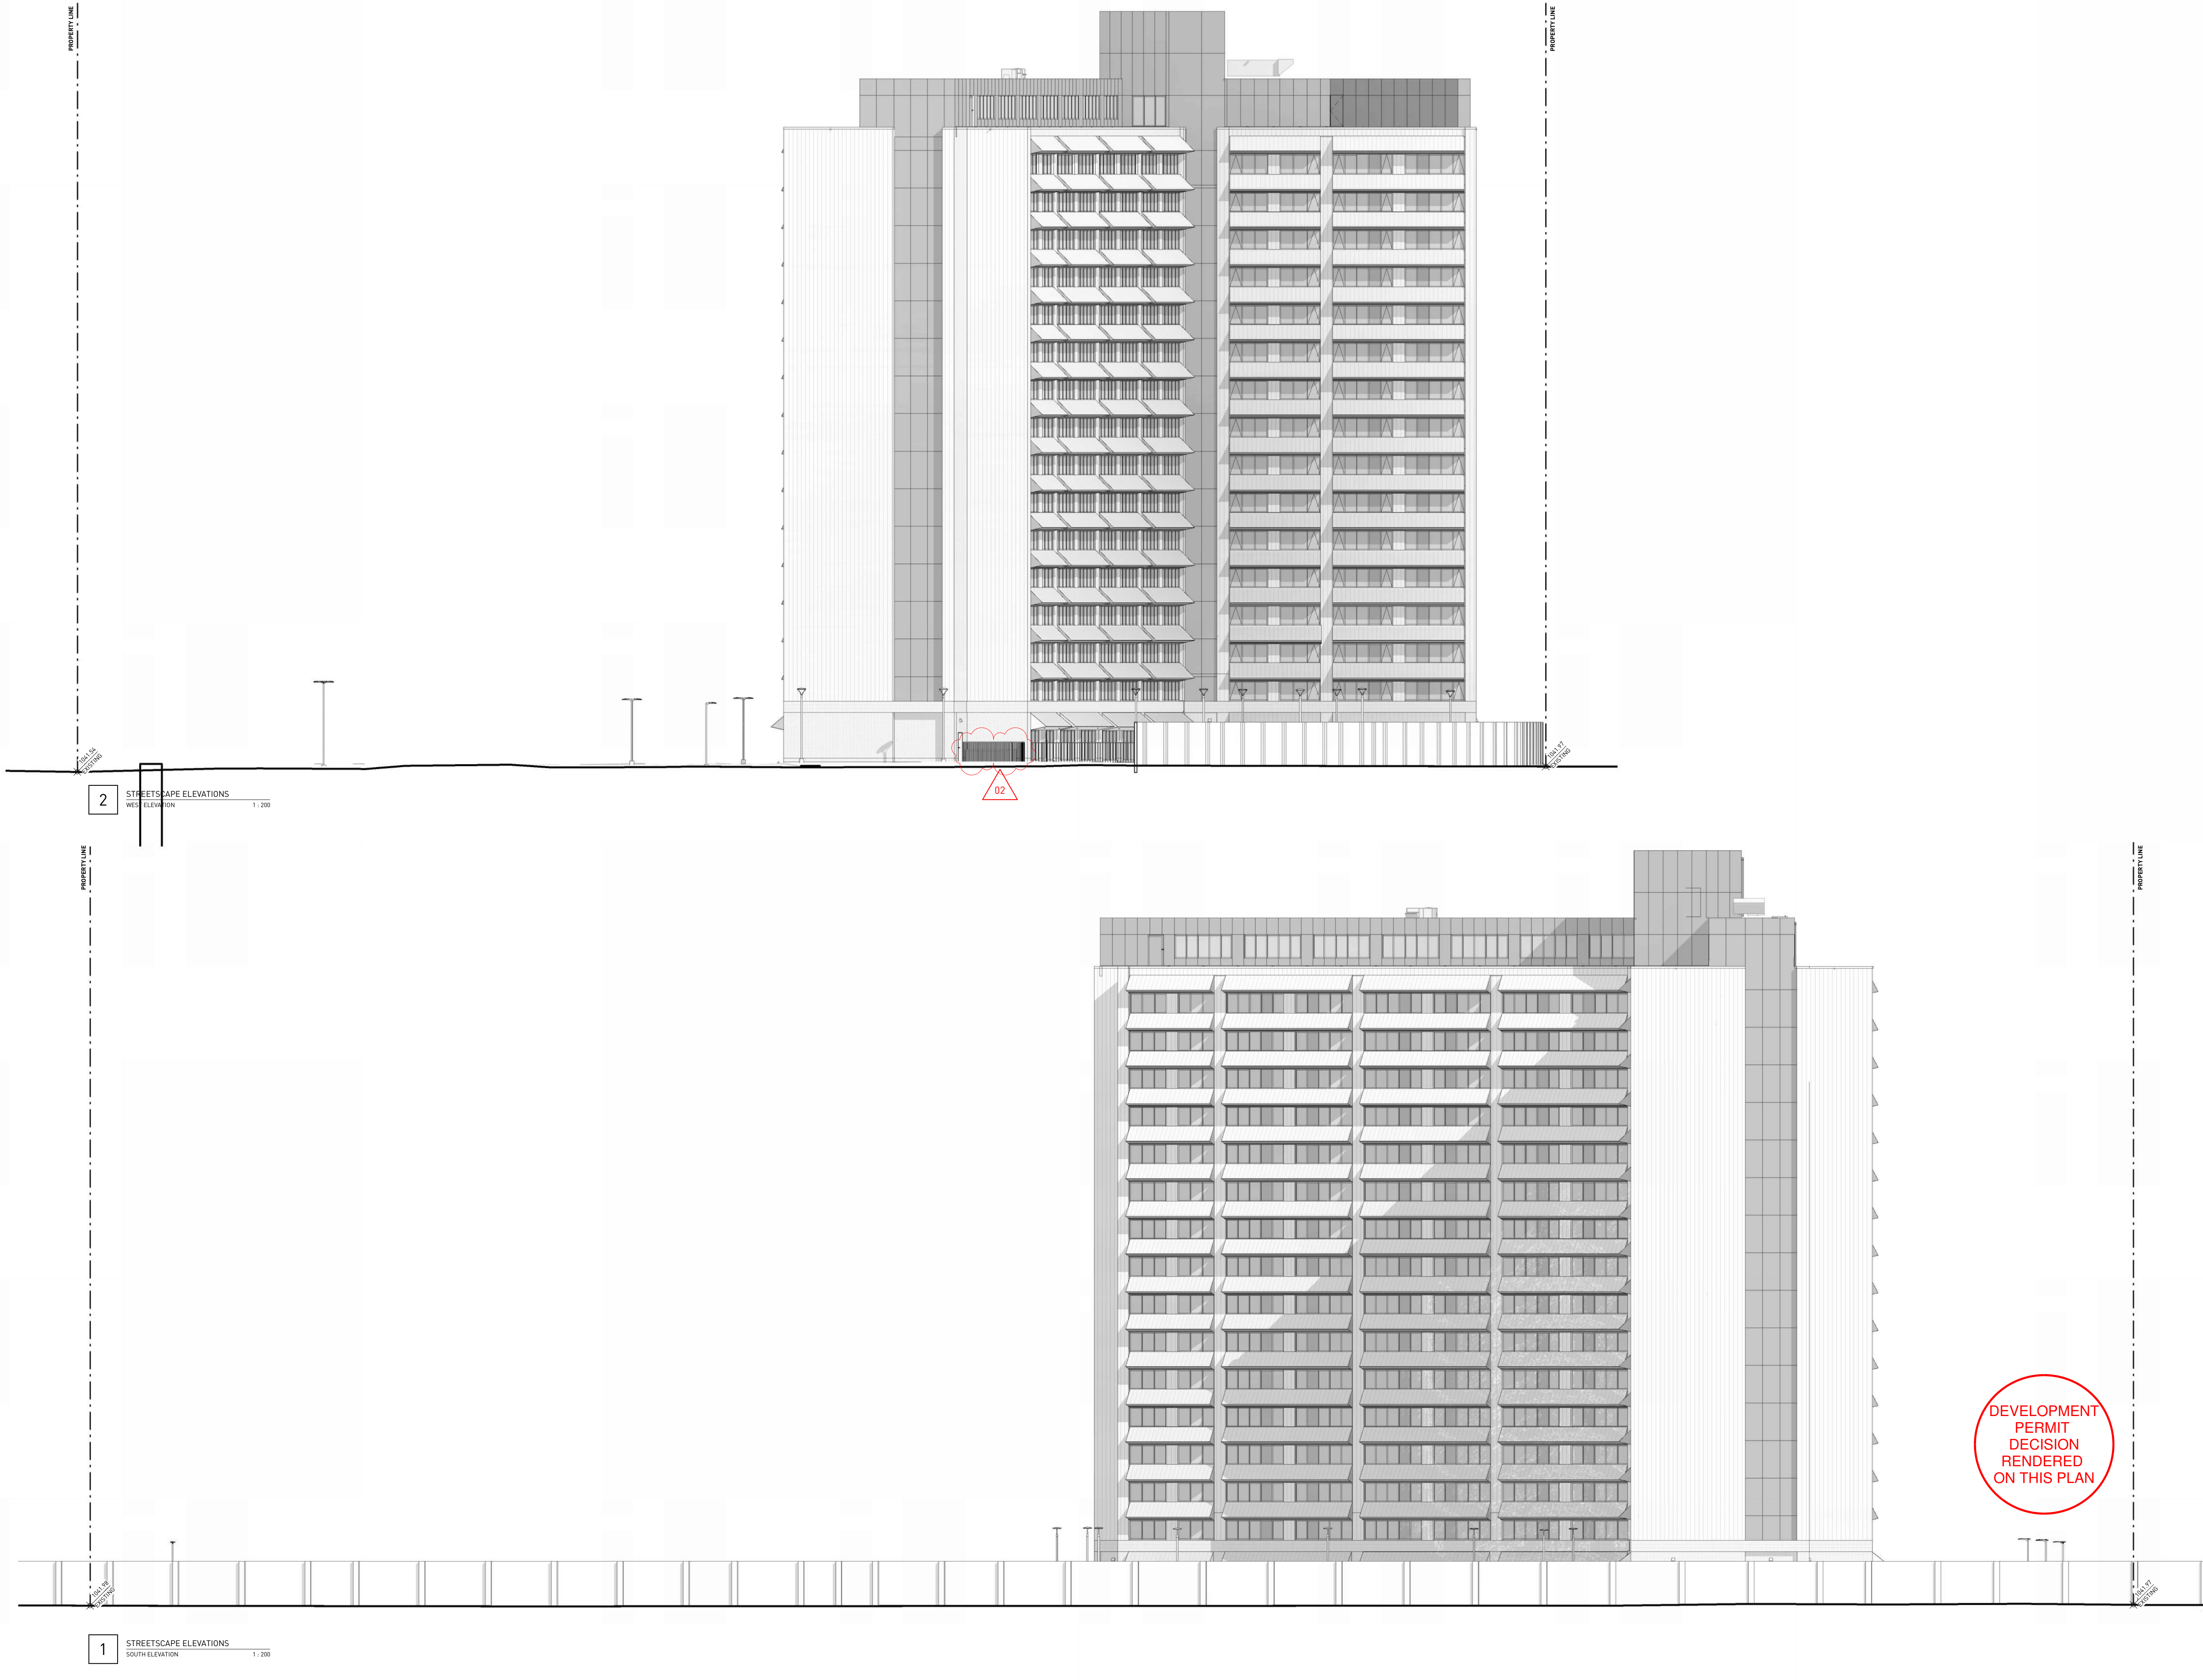

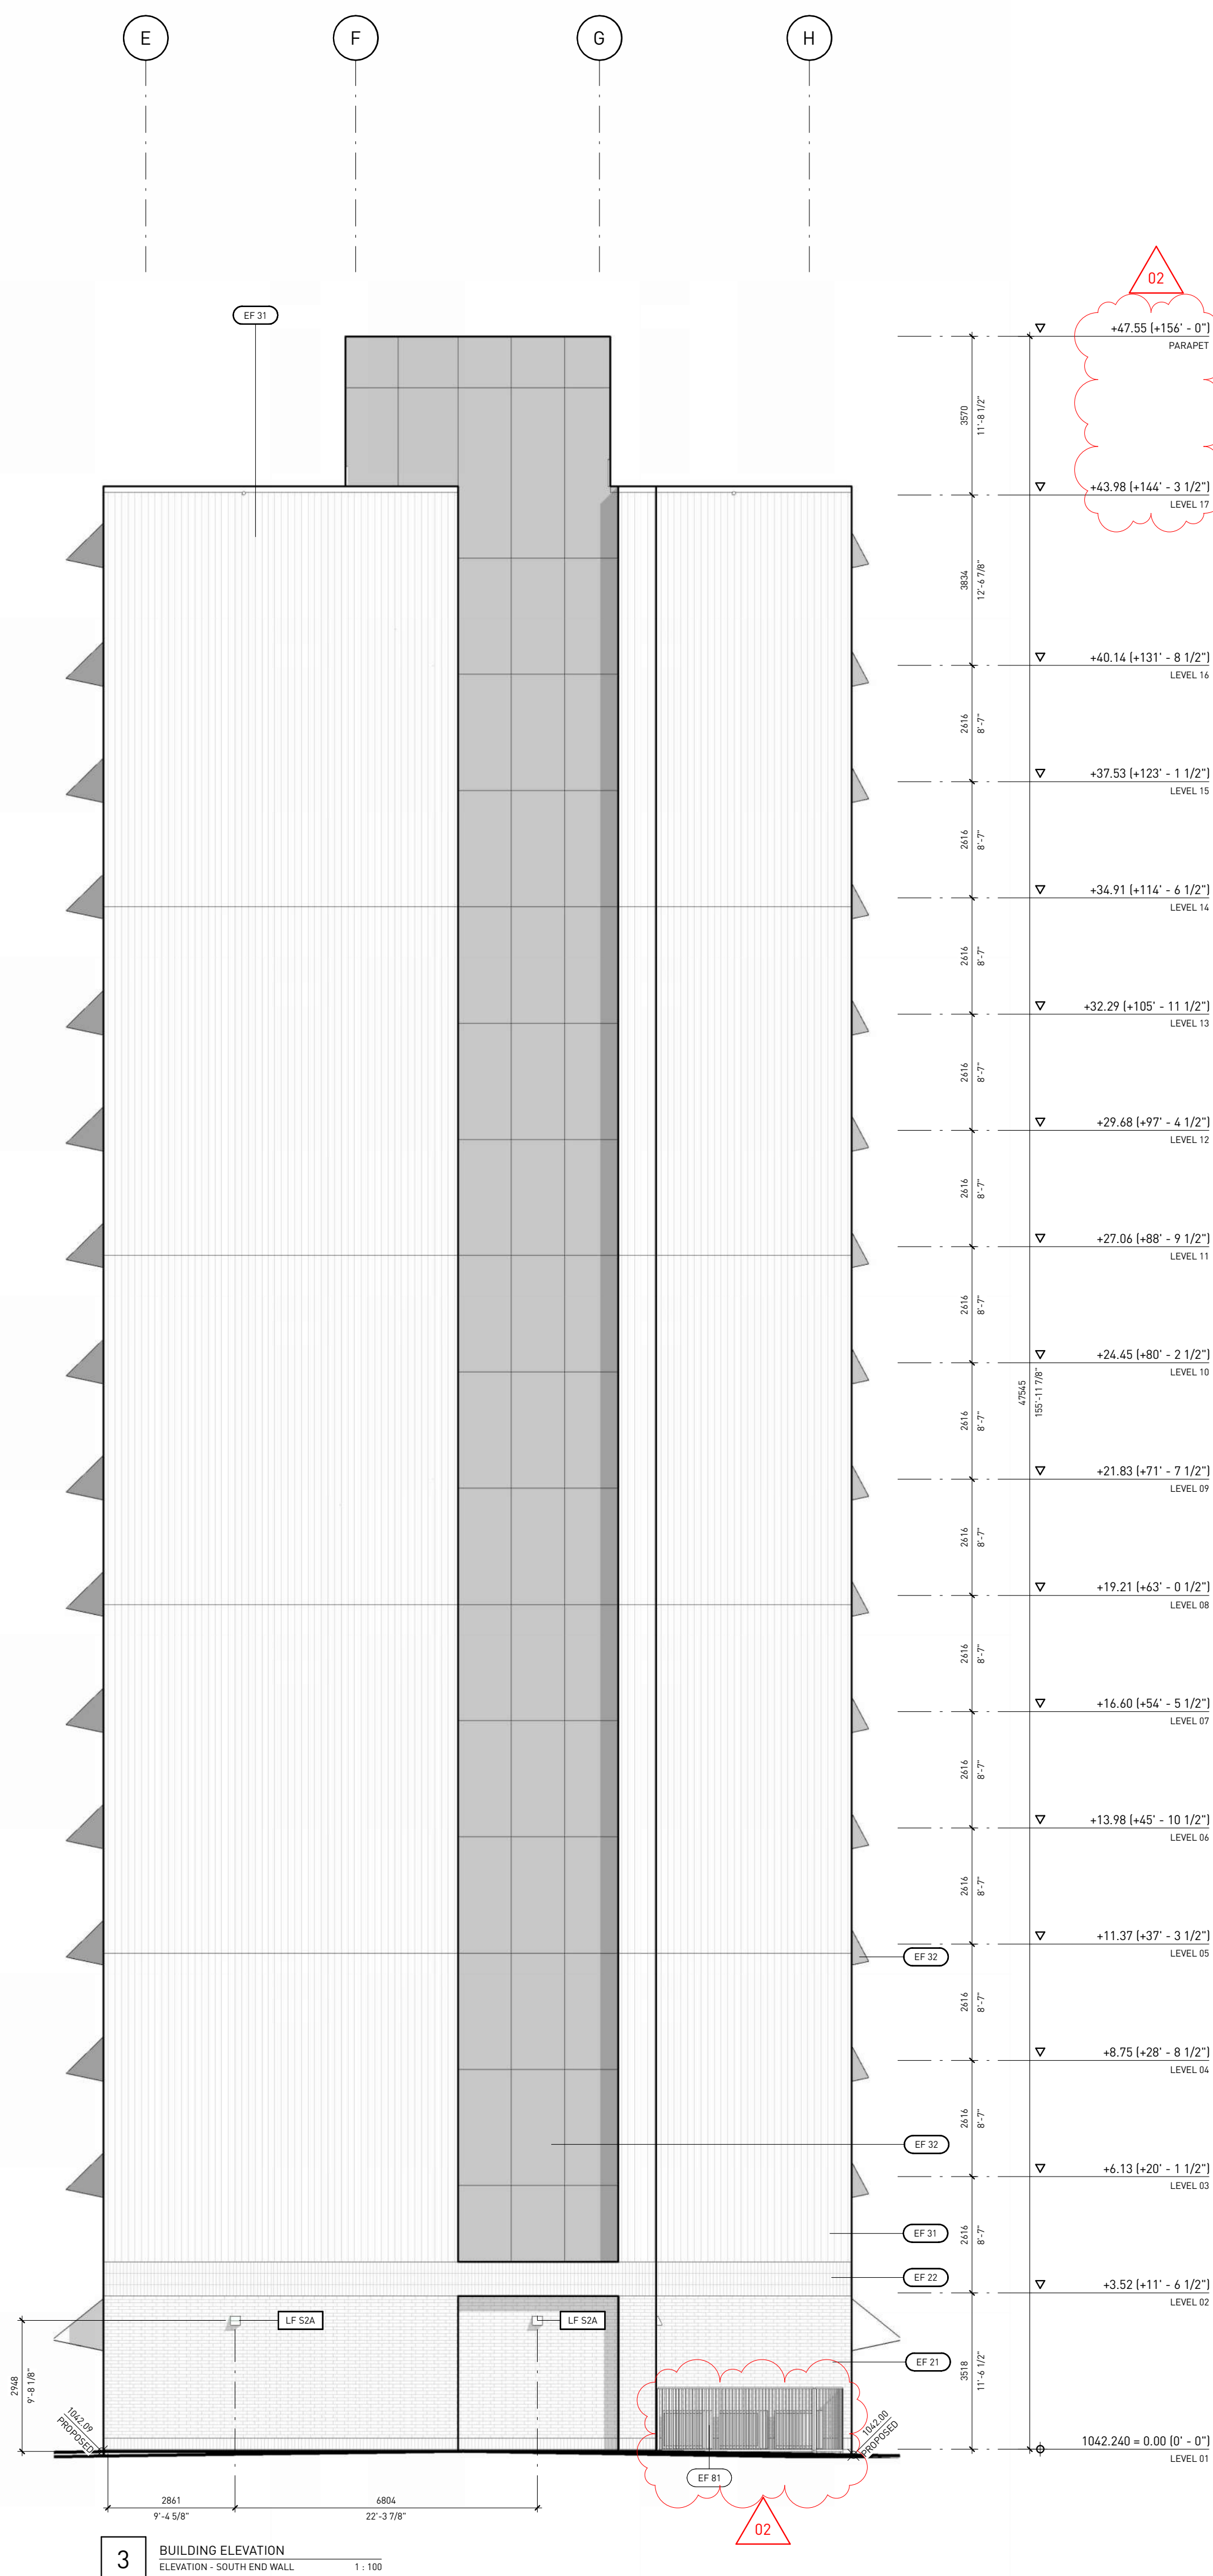

REVISIONDATEDESCRIPTION002025-12-18DEVELOPMENT PERMIT012026-03-10DR 1 RESPONSE022026-06-24DR 2 RESPONSE		
PROJECT NAME BRIDGELAND PLACE 736 MCDOUGALL CT NE CALGARY AB T2E ZW6 PLAN4301 R BLOCKMCDOUGALL RESERVE		
PROJECT NUMBER 5310		
HINDLE ARCHITECTS SUITE 510 - 237 8 AVENUE SE CALGARY - ALBERTA - CANADA		
CONTACT MS. AMBER LAFONTAINE 403.804.7592 amber@hindle-architects.com		
DO NOT SCALE FROM DRAWING. THE AUTHOR OF THIS DRAWING TAKES NO RESPONSIBILITY FOR ANY DIMENSIONS OBTAINED BY MEASURING OR SCALING FROM THIS DRAWING AND NO RELIANCE MAY BE PLACED ON SUCH DIMENSIONS. IF NO DIMENSION IS GIVEN, IT IS THE RESPONSIBILITY OF THE RECIPIENT TO ASCERTAIN THE DIMENSION SPECIFICALLY FROM THE AUTHOR OR BY SITE MEASUREMENT. THE SIZING OF ALL STRUCTURAL AND SERVICE ELEMENTS MUST ALWAYS BE CHECKED AGAINST THE RELEVANT CONSULTANT'S DRAWINGS. NO RELIANCE SHOULD BE PLACED UPON USING INFORMATION SHOWN ON THIS DRAWING. COPYRIGHT: THE DOCUMENT HEREIN, INCLUDING BUT NOT LIMITED TO PLANS, SKETCHES, GRAPHIC REPRESENTATIONS, AND SPECIFICATIONS IS PROTECTED BY COPYRIGHT LAW AND MAY NOT BE USED, REPRODUCED IN ANY FORM OR MANNER, OR REVISED EXCEPT WITH WRITTEN PERMISSION FROM HINDLE ARCHITECTS LTD. REPORT ANY ERRORS OR OMISSIONS TO THE ARCHITECT PRIOR TO COMMENCEMENT OF THE WORK.		
DRAWING PURPOSE DEVELOPMENT PERMIT - DR2		
DRAWN BY HA	CHECKED BY AL	AUTHORIZED BY JH
STAMP		
NORTH		
DRAWING TITLE BUILDING ELEVATIONS SOUTH & WEST		
DRAWING NUMBER A-4100.0		
DRAWING DATE 2025-12-18	SCALE @ ARCH D 1:100	
REVISION DATE 2026-06-24	REVISION NUMBER 02	





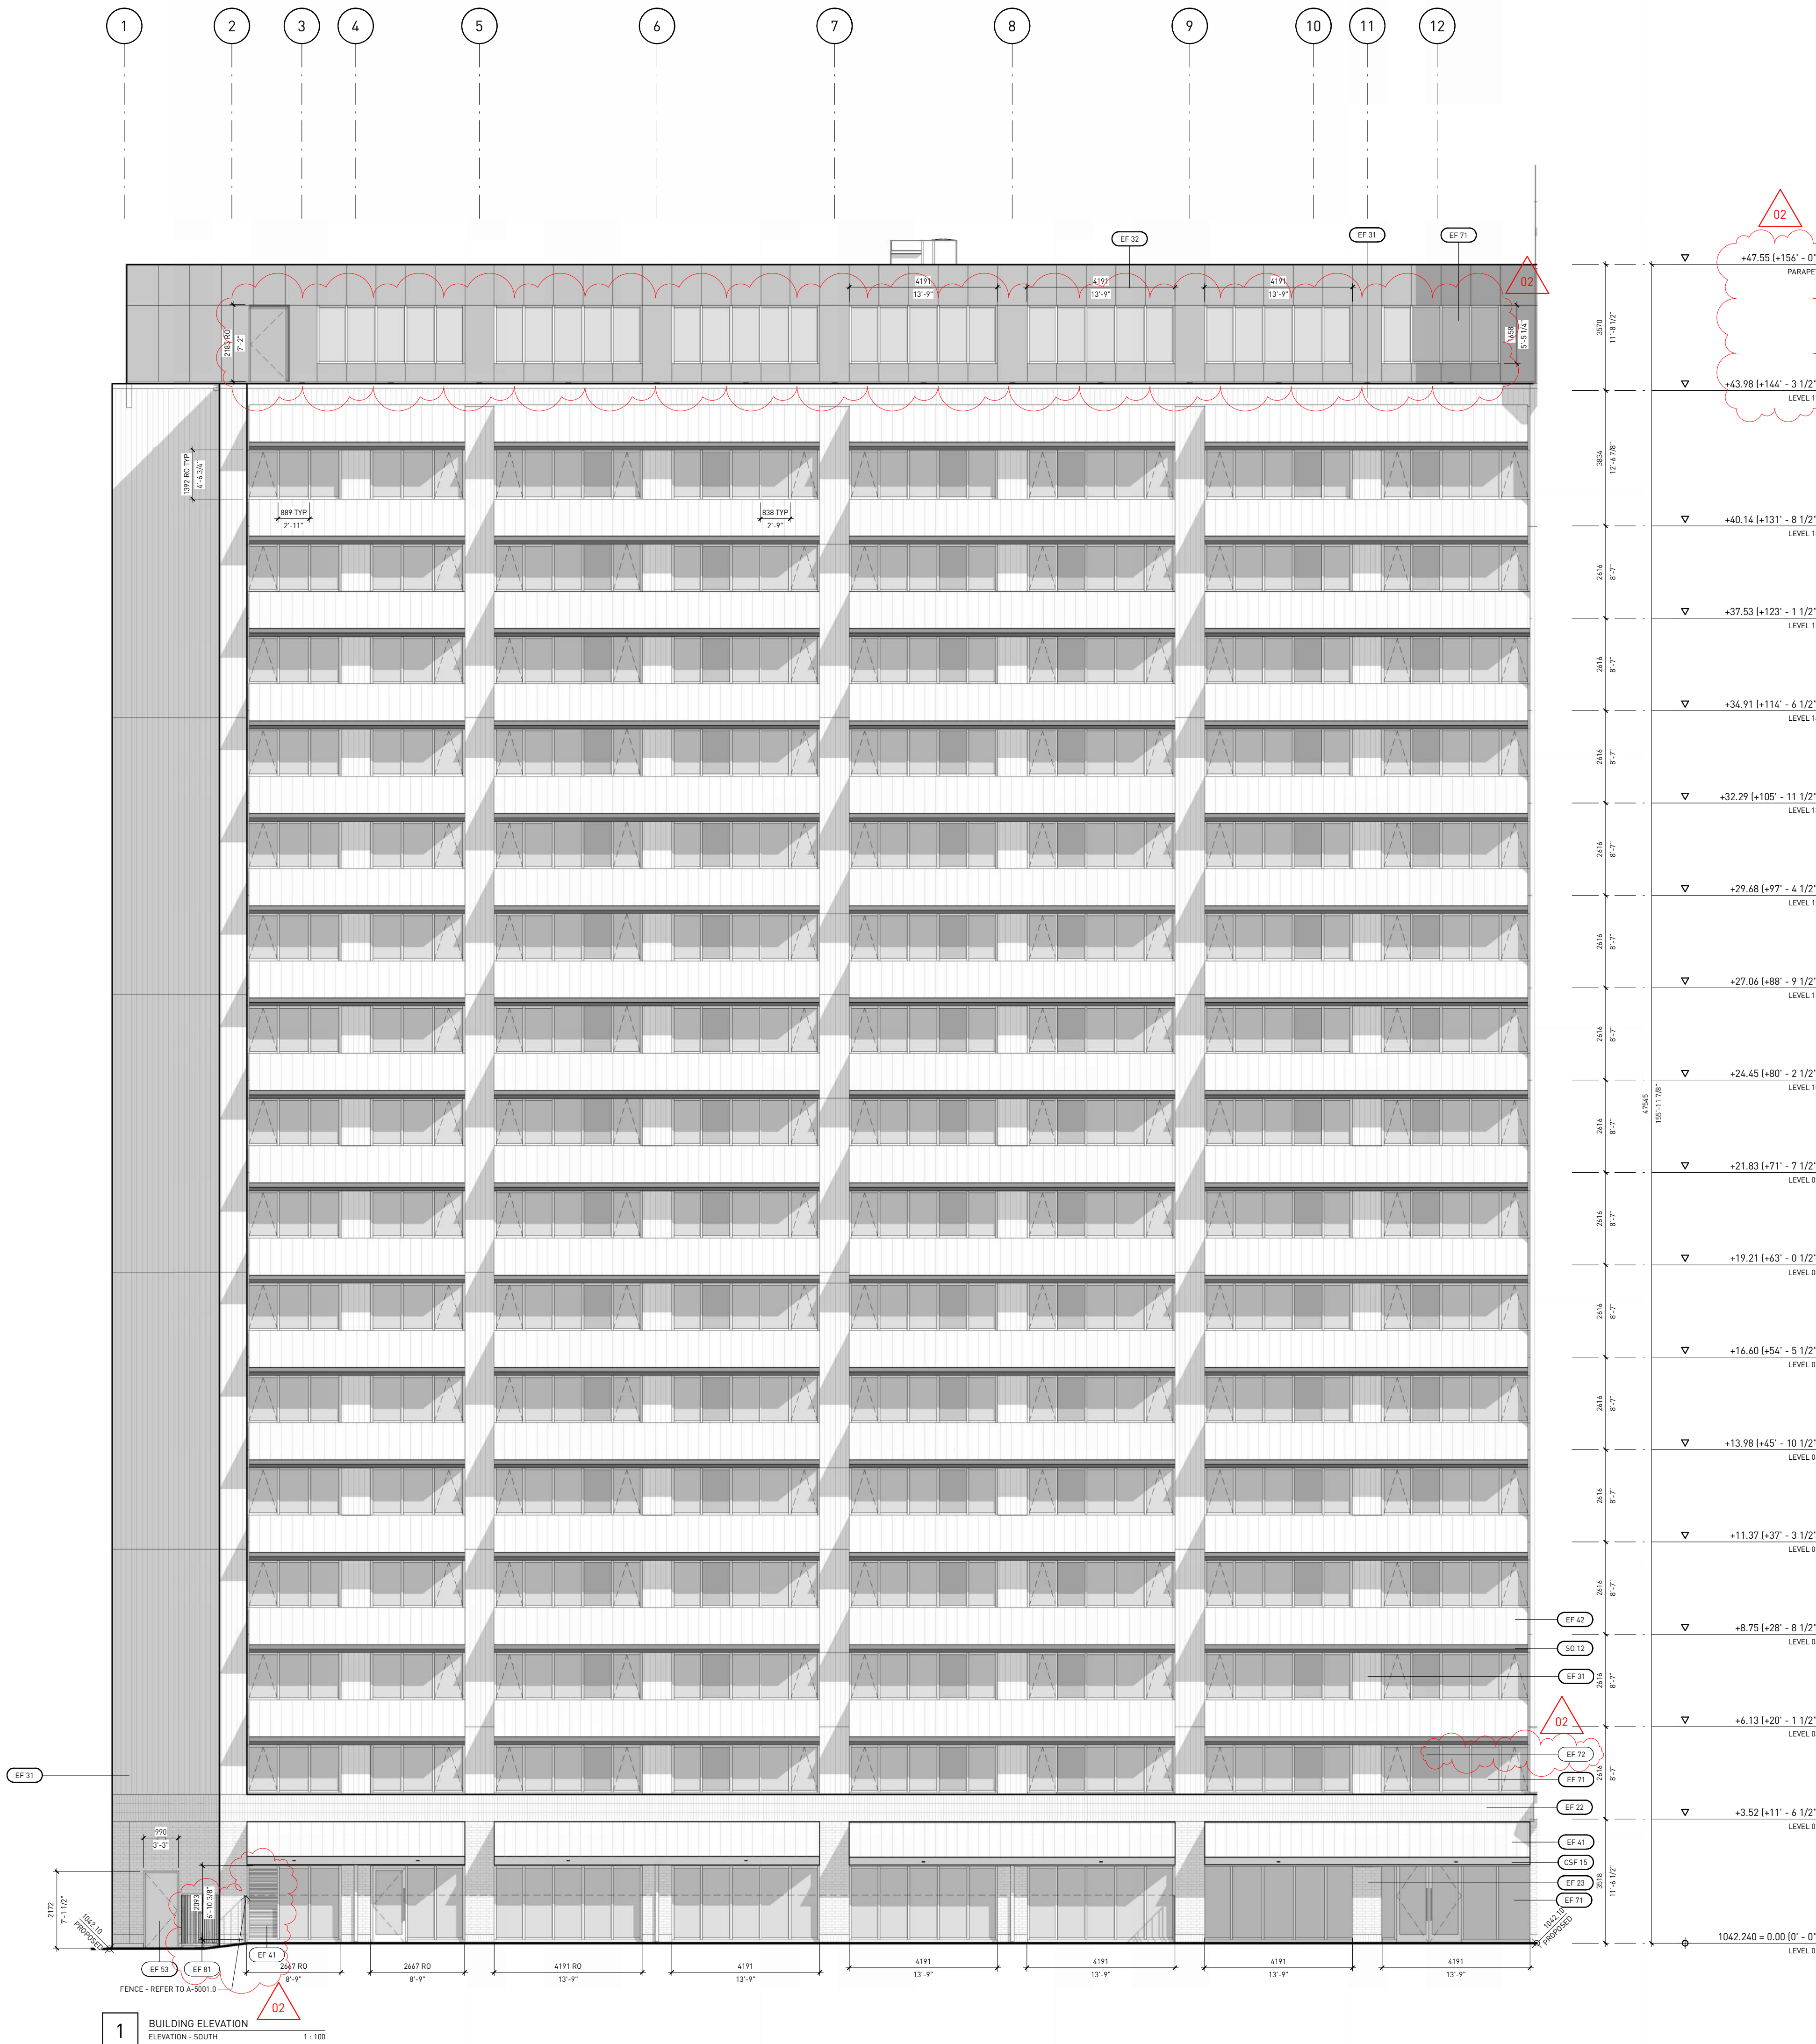

EXTERIOR FINISHES		
EF 21	BRICK VENEER - BRICK TONE (LEVEL 01)	
EF 22	BRICK VENEER ACCENT - BRICK TONE (LEVEL 01)	
EF 23	BRICK VENEER ACCENT - LIGHT NEUTRAL TONE (LEVEL 01)	
EF 31	METAL PANEL - LIGHT NEUTRAL TONE (LEVELS 02-16)	
EF 32	SMOOTH METAL PANEL - DARK NEUTRAL TONE (LEVELS 02-17)	
EF 41	STANDING SEAM METAL CANOPY - BRICK TONE (LEVEL 01)	
EF 42	STANDING SEAM METAL CANOPY - WARM NEUTRAL TONE (LEVELS 02-16)	
EF 51	GUTTERS AND DOWNSPOUTS (LEVEL 01)	
EF 53	EXTERIOR DOORS (LEVEL 01)	
EF 54	EXTERIOR DOORS (LEVEL 17)	
EF 61	EXTERIOR LOUVERS (LEVEL 01)	
EF 62	PERFORATED METAL SCREEN (LEVEL 17)	
EF 71	CLEAR GLAZING	
EF 72	BACKPAINTED SPANDREL GLAZING	
SO 11	METAL SOFFIT - LIGHT	
SO 12	METAL SOFFIT - DARK	

REVISION		DATE	DESCRIPTION
00		2025-12-18	DEVELOPMENT PERMIT
01		2026-03-10	DR 1 RESPONSE
02		2026-06-24	DR 2 RESPONSE
PROJECT NAME			
BRIDGELAND PLACE			
736 MCDOUGALL CT NE CALGARY AB T2E 2W6			
PLAN BLOCK		4301 R MCDOUGALL RESERVE	
PROJECT NUMBER			
5310			
HINDLE ARCHITECTS SUITE 510 - 237 8 AVENUE SE CALGARY - ALBERTA - CANADA			
CONTACT			
MS. AMBER LAFONTAINE 403.804.7592 amber@hindle-architects.com			
DO NOT SCALE FROM DRAWING. THE AUTHOR OF THIS DRAWING TAKES NO RESPONSIBILITY FOR ANY DIMENSIONS OBTAINED BY MEASURING OR SCALING FROM THIS DRAWING AND NO RELIANCE MAY BE PLACED ON SUCH DIMENSIONS. IF NO DIMENSION IS GIVEN, IT IS THE RESPONSIBILITY OF THE RECIPIENT TO ASCERTAIN THE DIMENSION SPECIFICALLY FROM THE AUTHOR OR BY SITE MEASUREMENT.			
THE SIZING OF ALL STRUCTURAL AND SERVICE ELEMENTS MUST ALWAYS BE CHECKED AGAINST THE RELEVANT CONSULTANT'S DRAWINGS. NO RELIANCE SHOULD BE PLACED UPON SIZING INFORMATION SHOWN ON THIS DRAWING.			
COPYRIGHT: THE DOCUMENT HEREIN, INCLUDING BUT NOT LIMITED TO PLANS, SKETCHES, GRAPHIC REPRESENTATIONS, AND SPECIFICATIONS IS PROTECTED BY COPYRIGHT LAW AND MAY NOT BE USED, REPRODUCED IN ANY FORM OR MANNER, OR REVISED EXCEPT WITH WRITTEN PERMISSION FROM HINDLE ARCHITECTS LTD.			
REPORT ANY ERRORS OR OMISSIONS TO THE ARCHITECT PRIOR TO COMMENCEMENT OF THE WORK.			
DRAWING PURPOSE			
DEVELOPMENT PERMIT - DR2			
DRAWN BY	CHECKED BY	AUTHORIZED BY	
HA	AL	JH	
STAMP			
NORTH			
DRAWING TITLE			
BUILDING ELEVATIONS SOUTH			
DRAWING NUMBER			
A-4110.0			
DRAWING DATE		SCALE & ARCH D	
2025-12-18		1:100	
REVISION DATE		REVISION NUMBER	
2026-06-24		02	

DEVELOPMENT
PERMIT
DECISION
RENDERED
ON THIS PLAN

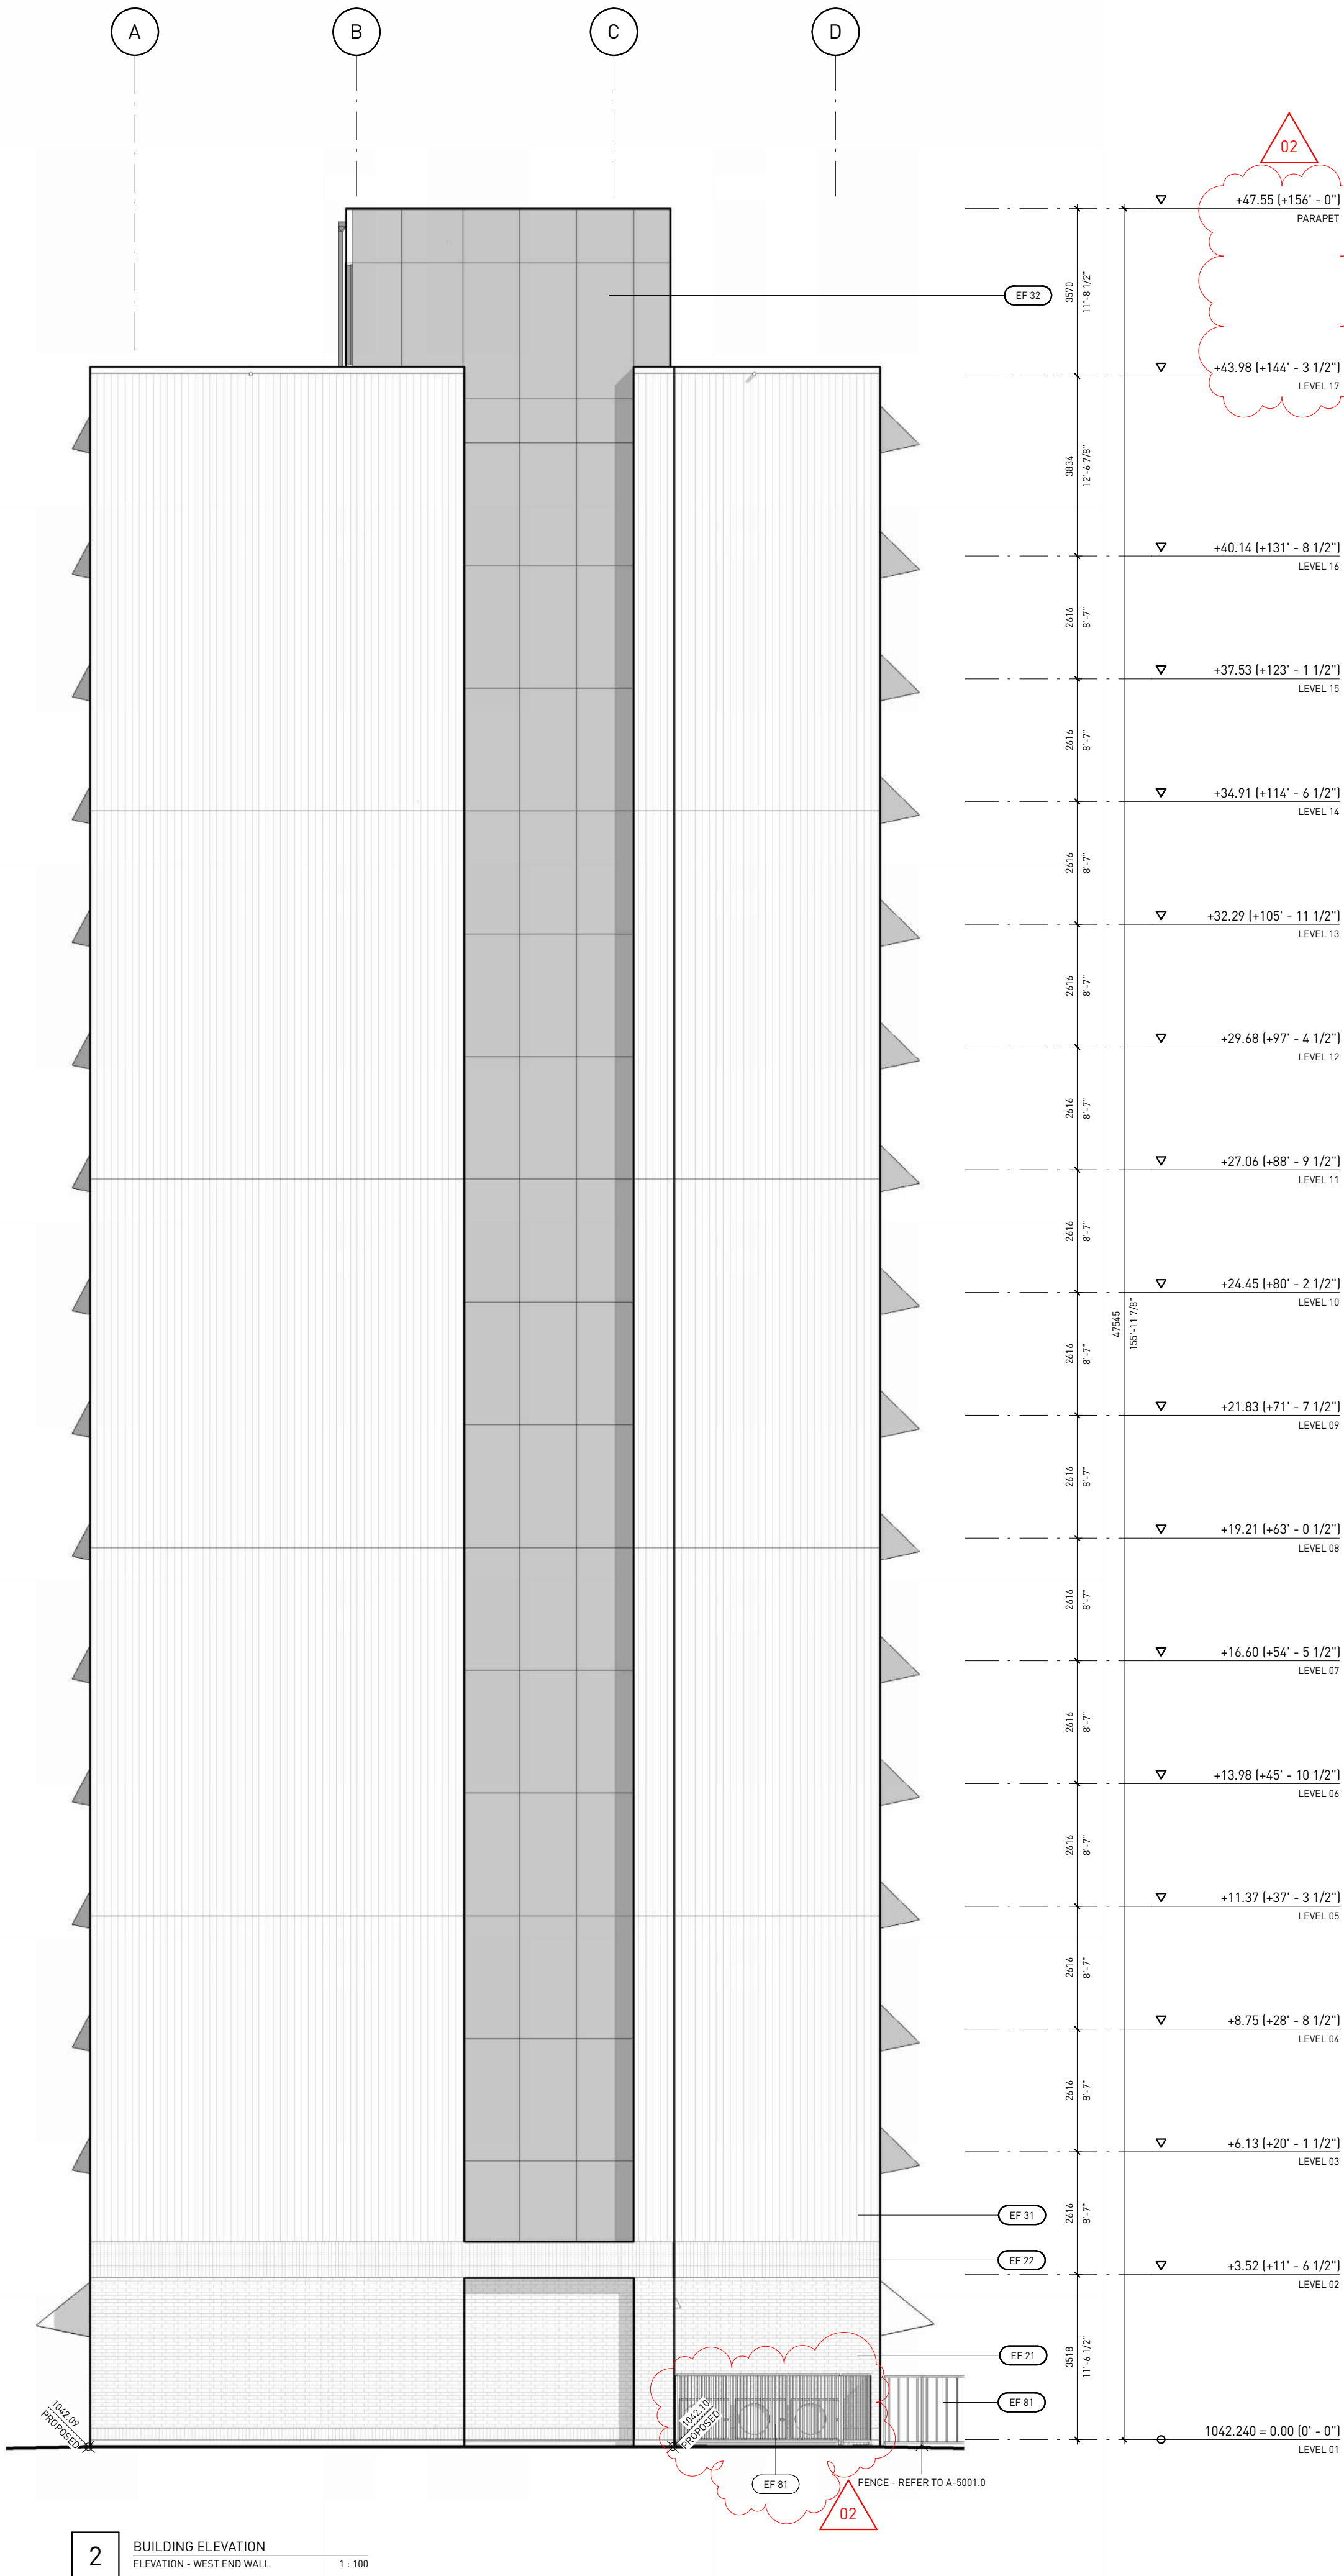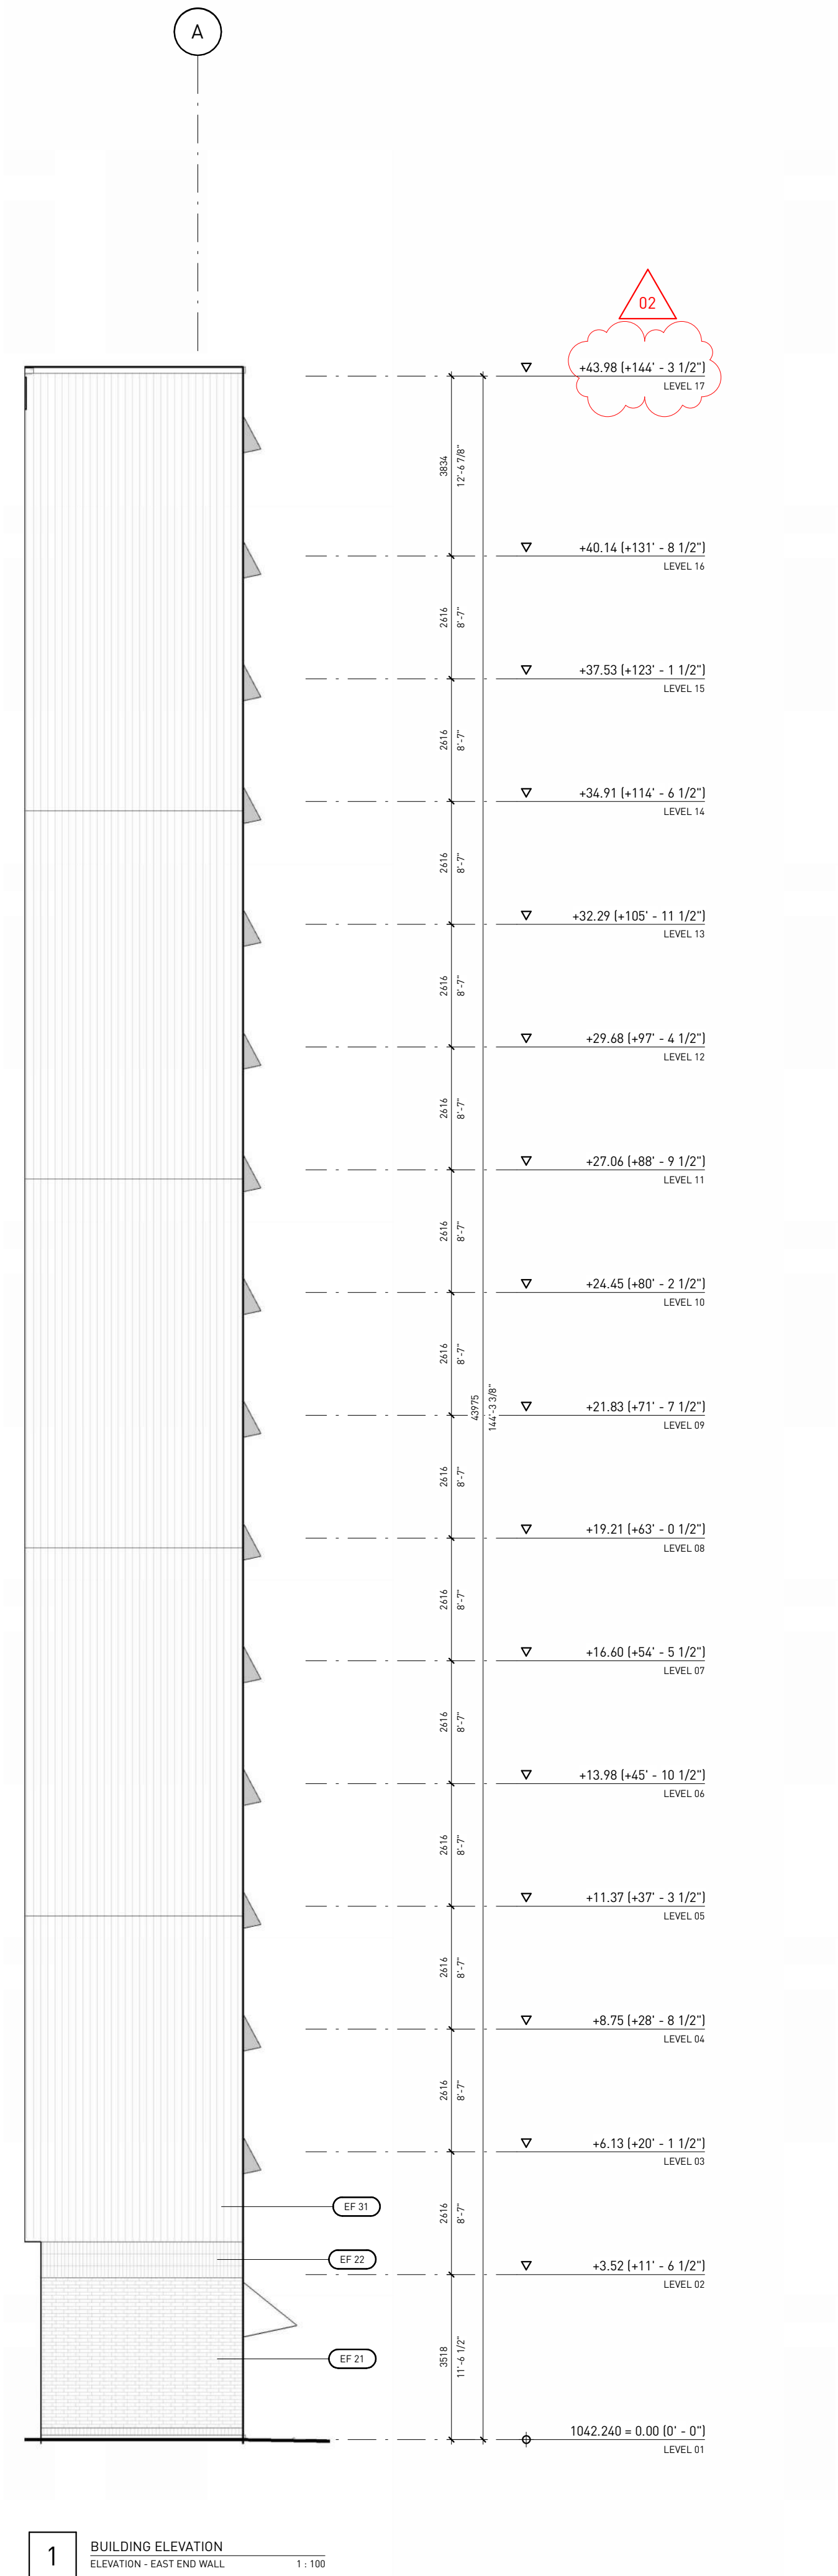

EXTERIOR FINISHES		
EF 21	BRICK VENEER - BRICK TONE (LEVEL 01)	
EF 22	BRICK VENEER ACCENT - BRICK TONE (LEVEL 01)	
EF 23	BRICK VENEER ACCENT - LIGHT NEUTRAL TONE (LEVEL 01)	
EF 31	METAL PANEL - LIGHT NEUTRAL TONE (LEVELS 02-16)	
EF 32	SMOOTH METAL PANEL - DARK NEUTRAL TONE (LEVELS 02-17)	
EF 41	STANDING SEAM METAL CANOPY - BRICK TONE (LEVEL 01)	
EF 42	STANDING SEAM METAL CANOPY - WARM NEUTRAL TONE (LEVELS 02-16)	
EF 51	GUTTERS AND DOWNSPOUTS (LEVEL 01)	
EF 53	EXTERIOR DOORS (LEVEL 01)	
EF 54	EXTERIOR DOORS (LEVEL 17)	
EF 61	EXTERIOR LOUVERS (LEVEL 01)	
EF 62	PERFORATED METAL SCREEN (LEVEL 17)	
EF 71	CLEAR GLAZING	
EF 72	BACKPAINTED SPANDREL GLAZING	
SO 11	METAL SOFFIT - LIGHT	
SO 12	METAL SOFFIT - DARK	

REVISION			DATE	DESCRIPTION
00			2025-12-18	DEVELOPMENT PERMIT
01			2026-03-10	DR 1 RESPONSE
02			2026-06-24	DR 2 RESPONSE

PROJECT NAME	
BRIDGELAND PLACE	
736 MCDOUGALL CT NE CALGARY AB T2E 2W6	
PLAN BLOCK	4301 R MCDOUGALL RESERVE

PROJECT NUMBER	
5310	

HINDLE ARCHITECTS	
SUITE 510 - 237 8 AVENUE SE CALGARY - ALBERTA - CANADA	

CONTACT	
MS. AMBER LAFONTAINE 403.804.7592 amber@hindle-architects.com	

DO NOT SCALE FROM DRAWING. THE AUTHOR OF THIS DRAWING TAKES NO RESPONSIBILITY FOR ANY DIMENSIONS OBTAINED BY MEASURING OR SCALING FROM THIS DRAWING AND NO RELIANCE MAY BE PLACED ON SUCH DIMENSIONS. IF NO DIMENSION IS GIVEN, IT IS THE RESPONSIBILITY OF THE RECIPIENT TO ASCERTAIN THE DIMENSION SPECIFICALLY FROM THE AUTHOR OR BY SITE MEASUREMENT.	
THE SIZING OF ALL STRUCTURAL AND SERVICE ELEMENTS MUST ALWAYS BE CHECKED AGAINST THE RELEVANT CONSULTANT'S DRAWINGS. NO RELIANCE SHOULD BE PLACED UPON SIZING INFORMATION SHOWN ON THIS DRAWING.	
COPYRIGHT: THE DOCUMENT HEREIN, INCLUDING BUT NOT LIMITED TO PLANS, SKETCHES, GRAPHIC REPRESENTATIONS, AND SPECIFICATIONS IS PROTECTED BY COPYRIGHT LAW AND MAY NOT BE USED, REPRODUCED IN ANY FORM OR MANNER, OR REVISED EXCEPT WITH WRITTEN PERMISSION FROM HINDLE ARCHITECTS LTD.	
REPORT ANY ERRORS OR OMISSIONS TO THE ARCHITECT PRIOR TO COMMENCEMENT OF THE WORK.	

DRAWING PURPOSE		
DEVELOPMENT PERMIT - DR2		

DRAWN BY	CHECKED BY	AUTHORIZED BY
HA	AL	JH
STAMP		

NORTH	
-------	--

DRAWING TITLE	
BUILDING ELEVATIONS WEST & EAST	


DRAWING NUMBER	
A-4120.0	

DRAWING DATE	SCALE @ ARCH D
2025-12-18	1:100
REVISION DATE	REVISION NUMBER
2026-06-24	02

DEVELOPMENT
PERMIT
DECISION
RENDERED
ON THIS PLAN




REVISION DATE DESCRIPTION		
00	2025-12-18	DEVELOPMENT PERMIT
01	2026-03-10	DR 1 RESPONSE
02	2026-06-24	DR 2 RESPONSE
PROJECT NAME		
BRIDGELAND PLACE		
736 MCDOUGALL CT NE CALGARY AB T2E 2W6		
PLAN BLOCK		4301 R MCDOUGALL RESERVE
PROJECT NUMBER		
5310		
HINDLE ARCHITECTS SUITE 510 - 237 8 AVENUE SE CALGARY - ALBERTA - CANADA		
CONTACT		
MS. AMBER LAFONTAINE 403.804.7592 amber@hindle-architects.com		
DO NOT SCALE FROM DRAWING. THE AUTHOR OF THIS DRAWING TAKES NO RESPONSIBILITY FOR ANY DIMENSIONS OBTAINED BY MEASURING OR SCALING FROM THIS DRAWING AND NO RELIANCE MAY BE PLACED ON SUCH DIMENSIONS. IF NO DIMENSION IS GIVEN, IT IS THE RESPONSIBILITY OF THE RECIPIENT TO ASCERTAIN THE DIMENSION SPECIFICALLY FROM THE AUTHOR OR BY SITE MEASUREMENT.		
THE SIZING OF ALL STRUCTURAL AND SERVICE ELEMENTS MUST ALWAYS BE CHECKED AGAINST THE RELEVANT CONSULTANT'S DRAWINGS. NO RELIANCE SHOULD BE PLACED UPON USING INFORMATION SHOWN ON THIS DRAWING.		
COPYRIGHT: THE DOCUMENT HEREIN, INCLUDING BUT NOT LIMITED TO PLANS, SKETCHES, GRAPHIC REPRESENTATIONS, AND SPECIFICATIONS IS PROTECTED BY COPYRIGHT LAW AND MAY NOT BE USED, REPRODUCED IN ANY FORM OR MANNER, OR REVISED EXCEPT WITH WRITTEN PERMISSION FROM HINDLE ARCHITECTS LTD.		
REPORT ANY ERRORS OR OMISSIONS TO THE ARCHITECT PRIOR TO COMMENCEMENT OF THE WORK.		
DRAWING PURPOSE		
DEVELOPMENT PERMIT - DR2		
DRAWN BY	CHECKED BY	AUTHORIZED BY
HA	AL	JH
STAMP		
NORTH		
DRAWING TITLE		
BUILDING ELEVATIONS NORTH		
DRAWING NUMBER		
A-4130.0		
DRAWING DATE	SCALE @ ARCH D	
2025-12-18	1:100	
REVISION DATE	REVISION NUMBER	
2026-06-24	02	

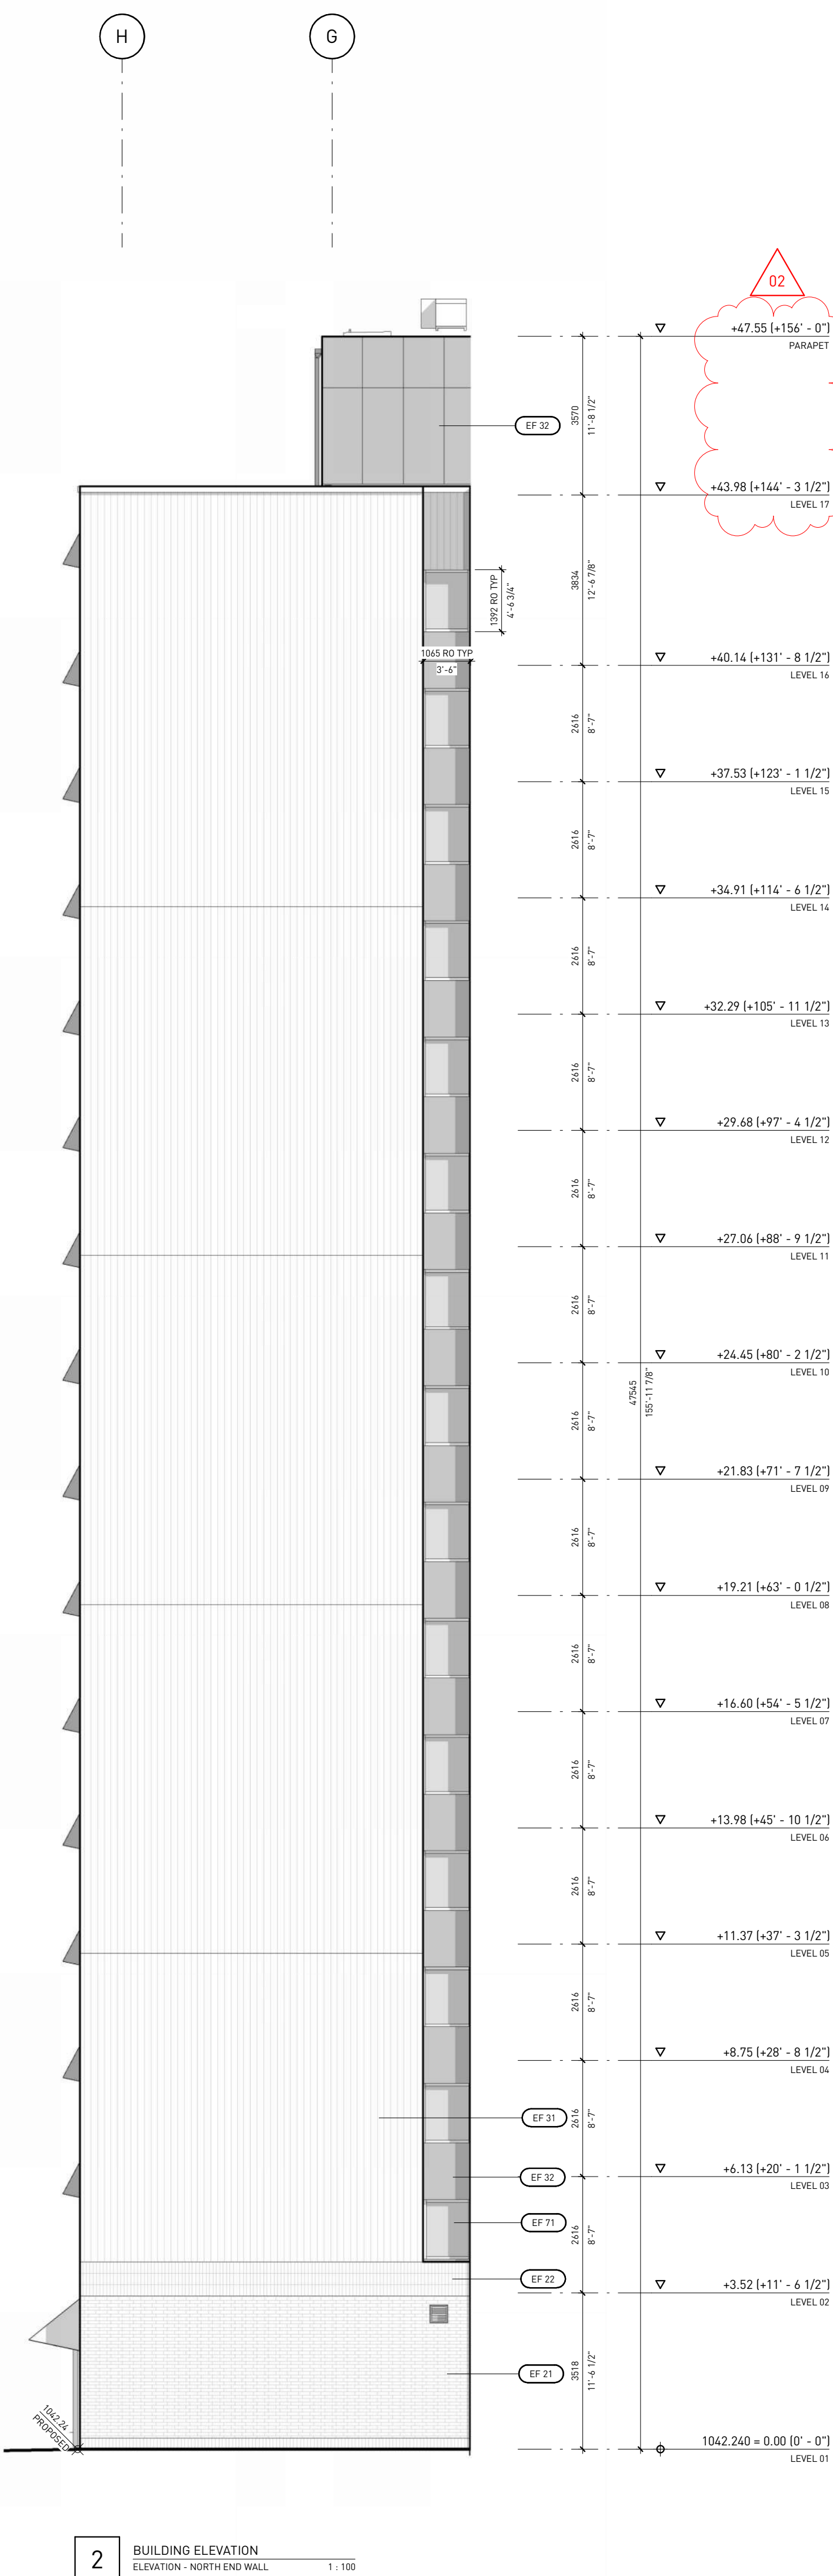

REVISION					
DATE		DESCRIPTION			
00	2025-12-18	DEVELOPMENT PERMIT			
01	2026-03-10	DR 1 RESPONSE			
02	2026-06-24	DR 2 RESPONSE			
PROJECT NAME					
BRIDGELAND PLACE					
736 MCDUGALL CT NE CALGARY AB T2E ZW6					
PLAN BLOCK		4301 R MCDUGALL RESERVE			
PROJECT NUMBER					
5310					
HINDLE ARCHITECTS					
SUITE 510 - 237 8 AVENUE SE CALGARY - ALBERTA - CANADA					
CONTACT					
MS. AMBER LAFONTAINE 403.804.7592 amber@hindle-architects.com					
DO NOT SCALE FROM DRAWING. THE AUTHOR OF THIS DRAWING TAKES NO RESPONSIBILITY FOR ANY DIMENSIONS OBTAINED BY MEASURING OR SCALING FROM THIS DRAWING AND NO RELIANCE MAY BE PLACED ON SUCH DIMENSIONS. IF NO DIMENSION IS GIVEN, IT IS TO THE RESPONSIBILITY OF THE RECIPIENT TO ASCERTAIN THE DIMENSION SPECIFICALLY FROM THE AUTHOR OR BY SITE MEASUREMENT.					
THE SIZING OF ALL STRUCTURAL AND SERVICE ELEMENTS MUST ALWAYS BE CHECKED AGAINST THE RELEVANT CONSULTANT'S DRAWINGS. NO RELIANCE SHOULD BE PLACED UPON USING INFORMATION SHOWN ON THIS DRAWING.					
COPYRIGHT: THE DOCUMENT HEREIN, INCLUDING BUT NOT LIMITED TO PLANS, SKETCHES, GRAPHIC REPRESENTATIONS, AND SPECIFICATIONS IS PROTECTED BY COPYRIGHT LAW AND MAY NOT BE USED, REPRODUCED IN ANY FORM OR MANNER, OR REVISED EXCEPT WITH WRITTEN PERMISSION FROM HINDLE ARCHITECTS LTD.					
REPORT ANY ERRORS OR OMISSIONS TO THE ARCHITECT PRIOR TO COMMENCEMENT OF THE WORK.					
DRAWING PURPOSE					
DEVELOPMENT PERMIT - DR2					
DRAWN BY	CHECKED BY		AUTHORIZED BY		
HA			JH		
STAMP					
NORTH					
DRAWING TITLE					
BUILDING ELEVATIONS NORTH & EAST					
DRAWING NUMBER					
A-4140.0					
DRAWING DATE		SCALE @ ARCH D			
2025-12-18		1:100			
REVISION DATE		REVISION NUMBER			
2026-06-24		02			



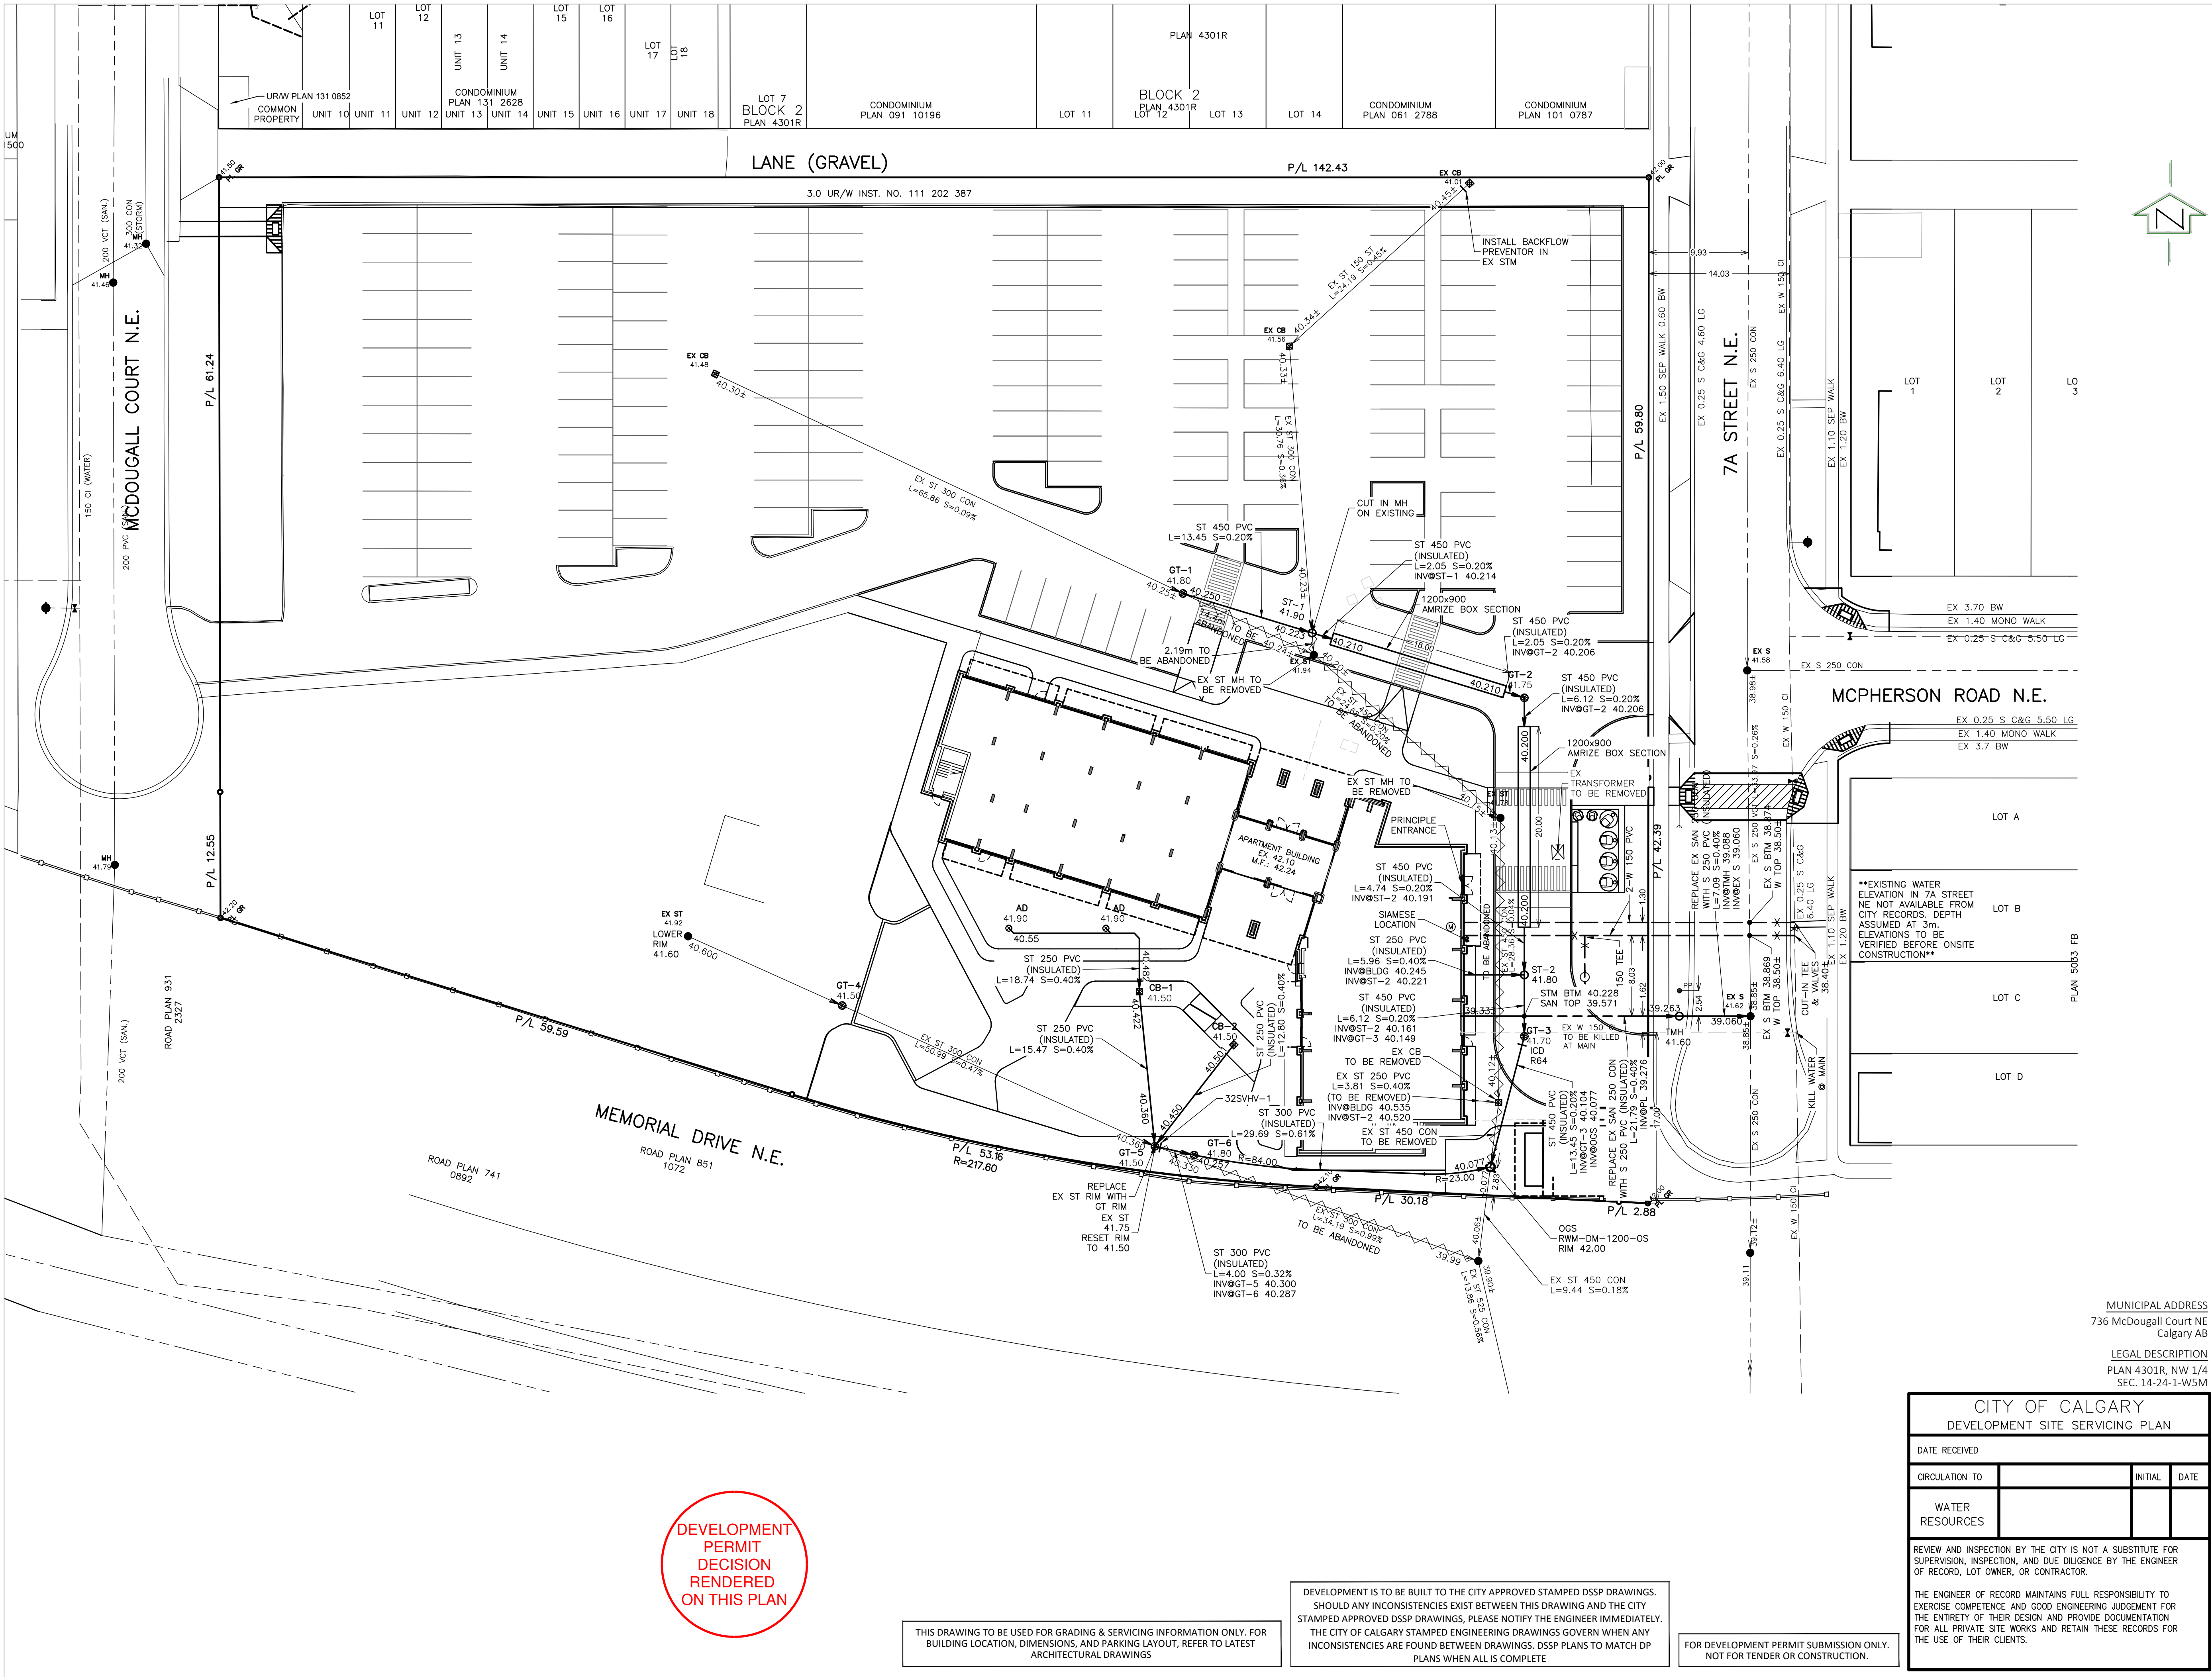

PERMIT

STAMP

- NOTES
- All elevations referenced to 1000m Geodetic Datum.
 - Hydrants, valves, check valves, manholes, sewer lines, water lines etc., to be installed to City of Calgary standards.
 - All manholes to be S.R.C.
 - Match crown minimum at all sewer connections.
 - All sewer distribution pipes to be SDR 35 PVC. All sewer service pipes <= to 150mm to be SDR 28 PVC. Sewer service pipes > than 150mm to be SDR 35.
 - Sewer lines to minimum slopes as per City of Calgary Standards.
 - Use City of Calgary Type 2 Installation, Class 1A bedding for sewer pipes unless unwise noted.
 - Insulation required for sanitary sewers if cover less than 2.50m on mains.
 - Insulation required for storm sewers if cover less than 1.20m as per City of Calgary Standards.
 - All water mains to be DR 18 PVC unless otherwise noted.
 - Use City of Calgary Type 1 Installation, Class 1A bedding for water mains, Type 2 installation, class 'B' bedding for services.
 - Depth of bury for water lines to conform with City of Calgary standards.
 - No trees to be planted over water line(s).
 - Protection of Potable Water Supply From Contamination: All Cross connections or potential cross connections must be either eliminated or protected against backflow by the installation of a cross connection control device. All cross connection control devices must be installed in accordance with the Water Utility By-law 22M82 and the National Plumbing Code of Canada.
 - For building locations and dimensions refer to latest Architectural drawings. The contractor is responsible for locating all shallow utilities.
 - The contractor is to verify the location of existing sanitary storm and water services and confirm existing inverts prior to installation within the project area. The Engineer should be notified immediately of any discrepancies.
 - Weeping Tile & Free Flow area drains to be tied to unrestricted free flow storm sewer.
 - All Civil Scope of Work Ends at 1.00m away from the Building Foot Print.

LEGEND	
	Existing hydrant
	Proposed hydrant
	Existing valve
	Valve
	Watermain
	Sanitary sewer
	Storm sewer
	Existing manhole
	Proposed manhole
	Manhole with plastic inserts
	Grated top manhole
	Catch basin
	Water meter location
	Existing elevation
	Sanitary manhole number & elevation
	CB/GT/Storm manhole number & elevation
	Main floor elevation
	Top of footing elevation
	Sanitary sewer invert at bldg

DEVELOPMENT PERMIT 2025-07446

REVISIONS		
No.	DATE	DESCRIPTION
5		
4		
3		
2		
1		

ISSUED FOR		
No.	DATE	DESCRIPTION
4		AS-BUILT
3		FOR CONSTRUCTION
2		FOR TENDER
1		DEVELOPMENT PERMIT
No.	DATE	DRAWING STATUS

CLIENT
HINDLE ARCHITECTS LTD.

PROJECT
BRIDGELAND PLACE - CALGARY HOUSING CORP
NUMBER OF UNITS
736 MCDUGALL COURT NE

TITLE
SITE SERVICING PLAN

DESIGN BY: DV	SCALE: 1:300	JOB NUMBER: 24-208
DRAWN BY: WB		
CHECKED BY: DV	REV NO.: -	DRAWING NUMBER: SP1
DATE: 19-Jun-26		

MUNICIPAL ADDRESS
736 McDougall Court NE
Calgary AB

LEGAL DESCRIPTION
PLAN 4301R, NW 1/4
SEC. 14-24-1-W5M

CITY OF CALGARY
DEVELOPMENT SITE SERVICING PLAN

DATE RECEIVED

CIRCULATION TO	INITIAL	DATE
WATER RESOURCES		





REVIEW AND INSPECTION BY THE CITY IS NOT A SUBSTITUTE FOR SUPERVISION, INSPECTION, AND DUE DILIGENCE BY THE ENGINEER OF RECORD, LOT OWNER, OR CONTRACTOR.

THE ENGINEER OF RECORD MAINTAINS FULL RESPONSIBILITY TO EXERCISE COMPETENCE AND GOOD ENGINEERING JUDGEMENT FOR THE ENTIRETY OF THEIR DESIGN AND PROVIDE DOCUMENTATION FOR ALL PRIVATE SITE WORKS AND RETAIN THESE RECORDS FOR THE USE OF THEIR CLIENTS.

THIS DRAWING IS TO BE USED FOR GRADING & SERVICING INFORMATION ONLY. FOR BUILDING LOCATION, DIMENSIONS, AND PARKING LAYOUT, REFER TO LATEST ARCHITECTURAL DRAWINGS

DEVELOPMENT IS TO BE BUILT TO THE CITY APPROVED STAMPED DSSP DRAWINGS. SHOULD ANY INCONSISTENCIES EXIST BETWEEN THIS DRAWING AND THE CITY STAMPED APPROVED DSSP DRAWINGS, PLEASE NOTIFY THE ENGINEER IMMEDIATELY. THE CITY OF CALGARY STAMPED ENGINEERING DRAWINGS GOVERN WHEN ANY INCONSISTENCIES ARE FOUND BETWEEN DRAWINGS. DSSP PLANS TO MATCH DP PLANS WHEN ALL IS COMPLETE

FOR DEVELOPMENT PERMIT SUBMISSION ONLY. NOT FOR TENDER OR CONSTRUCTION.

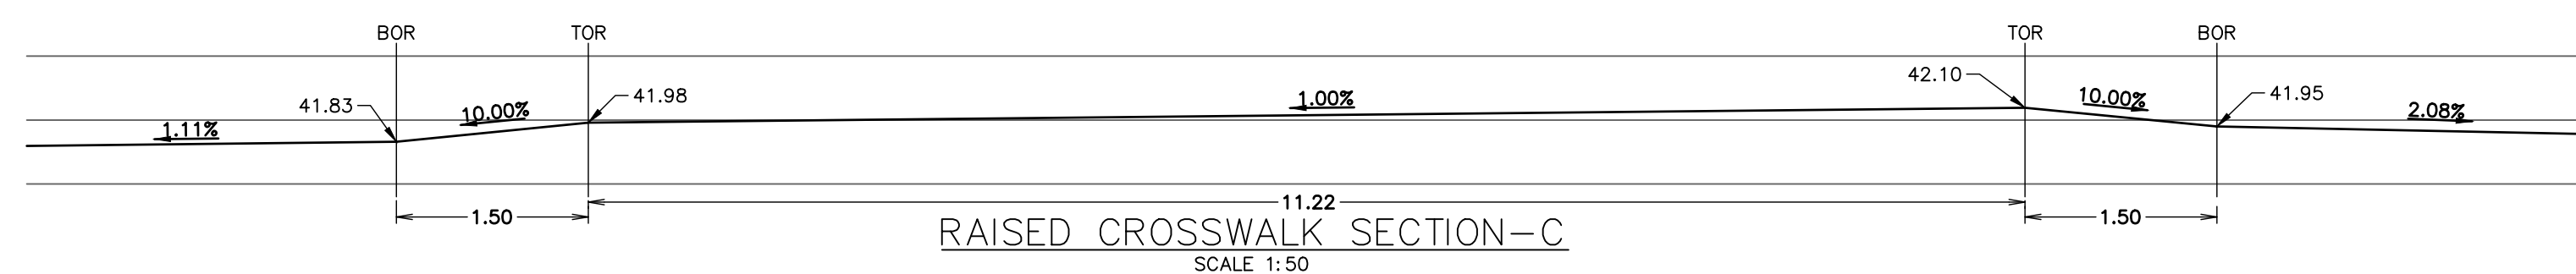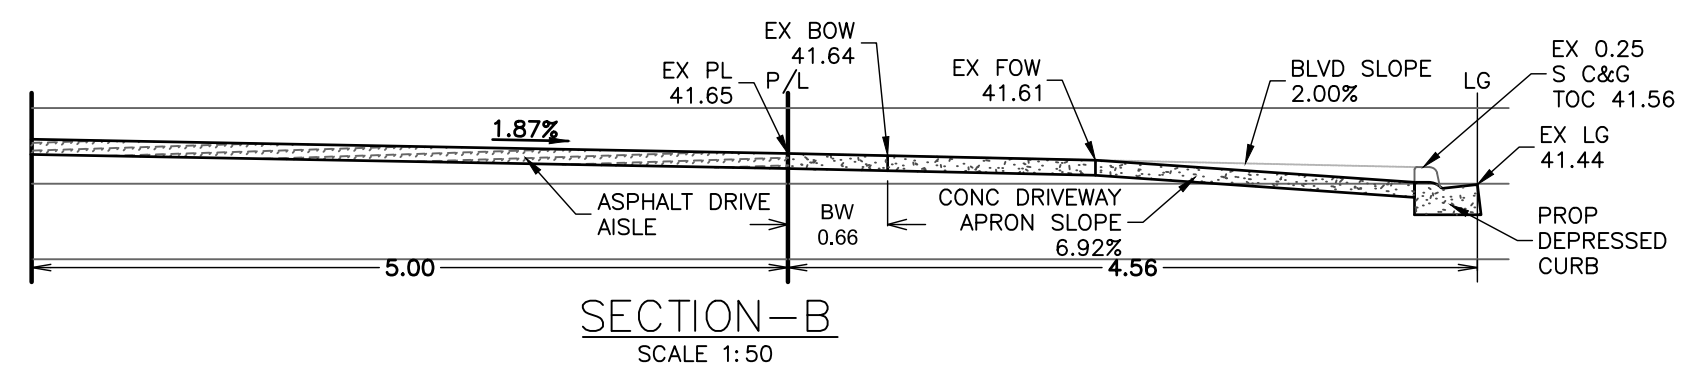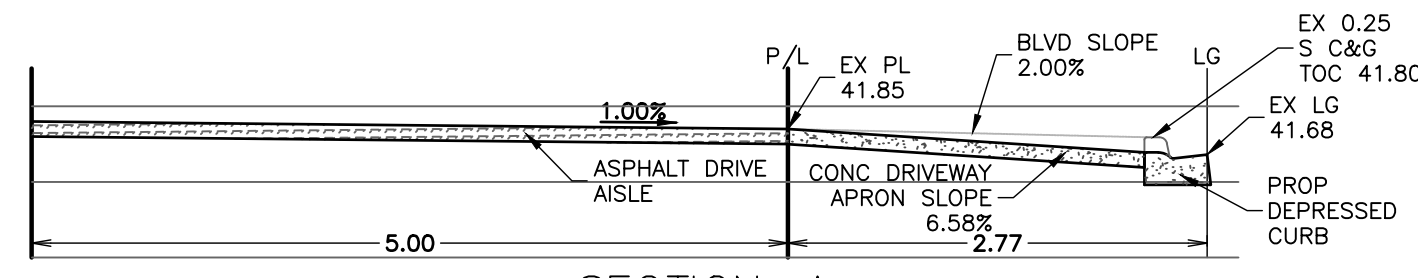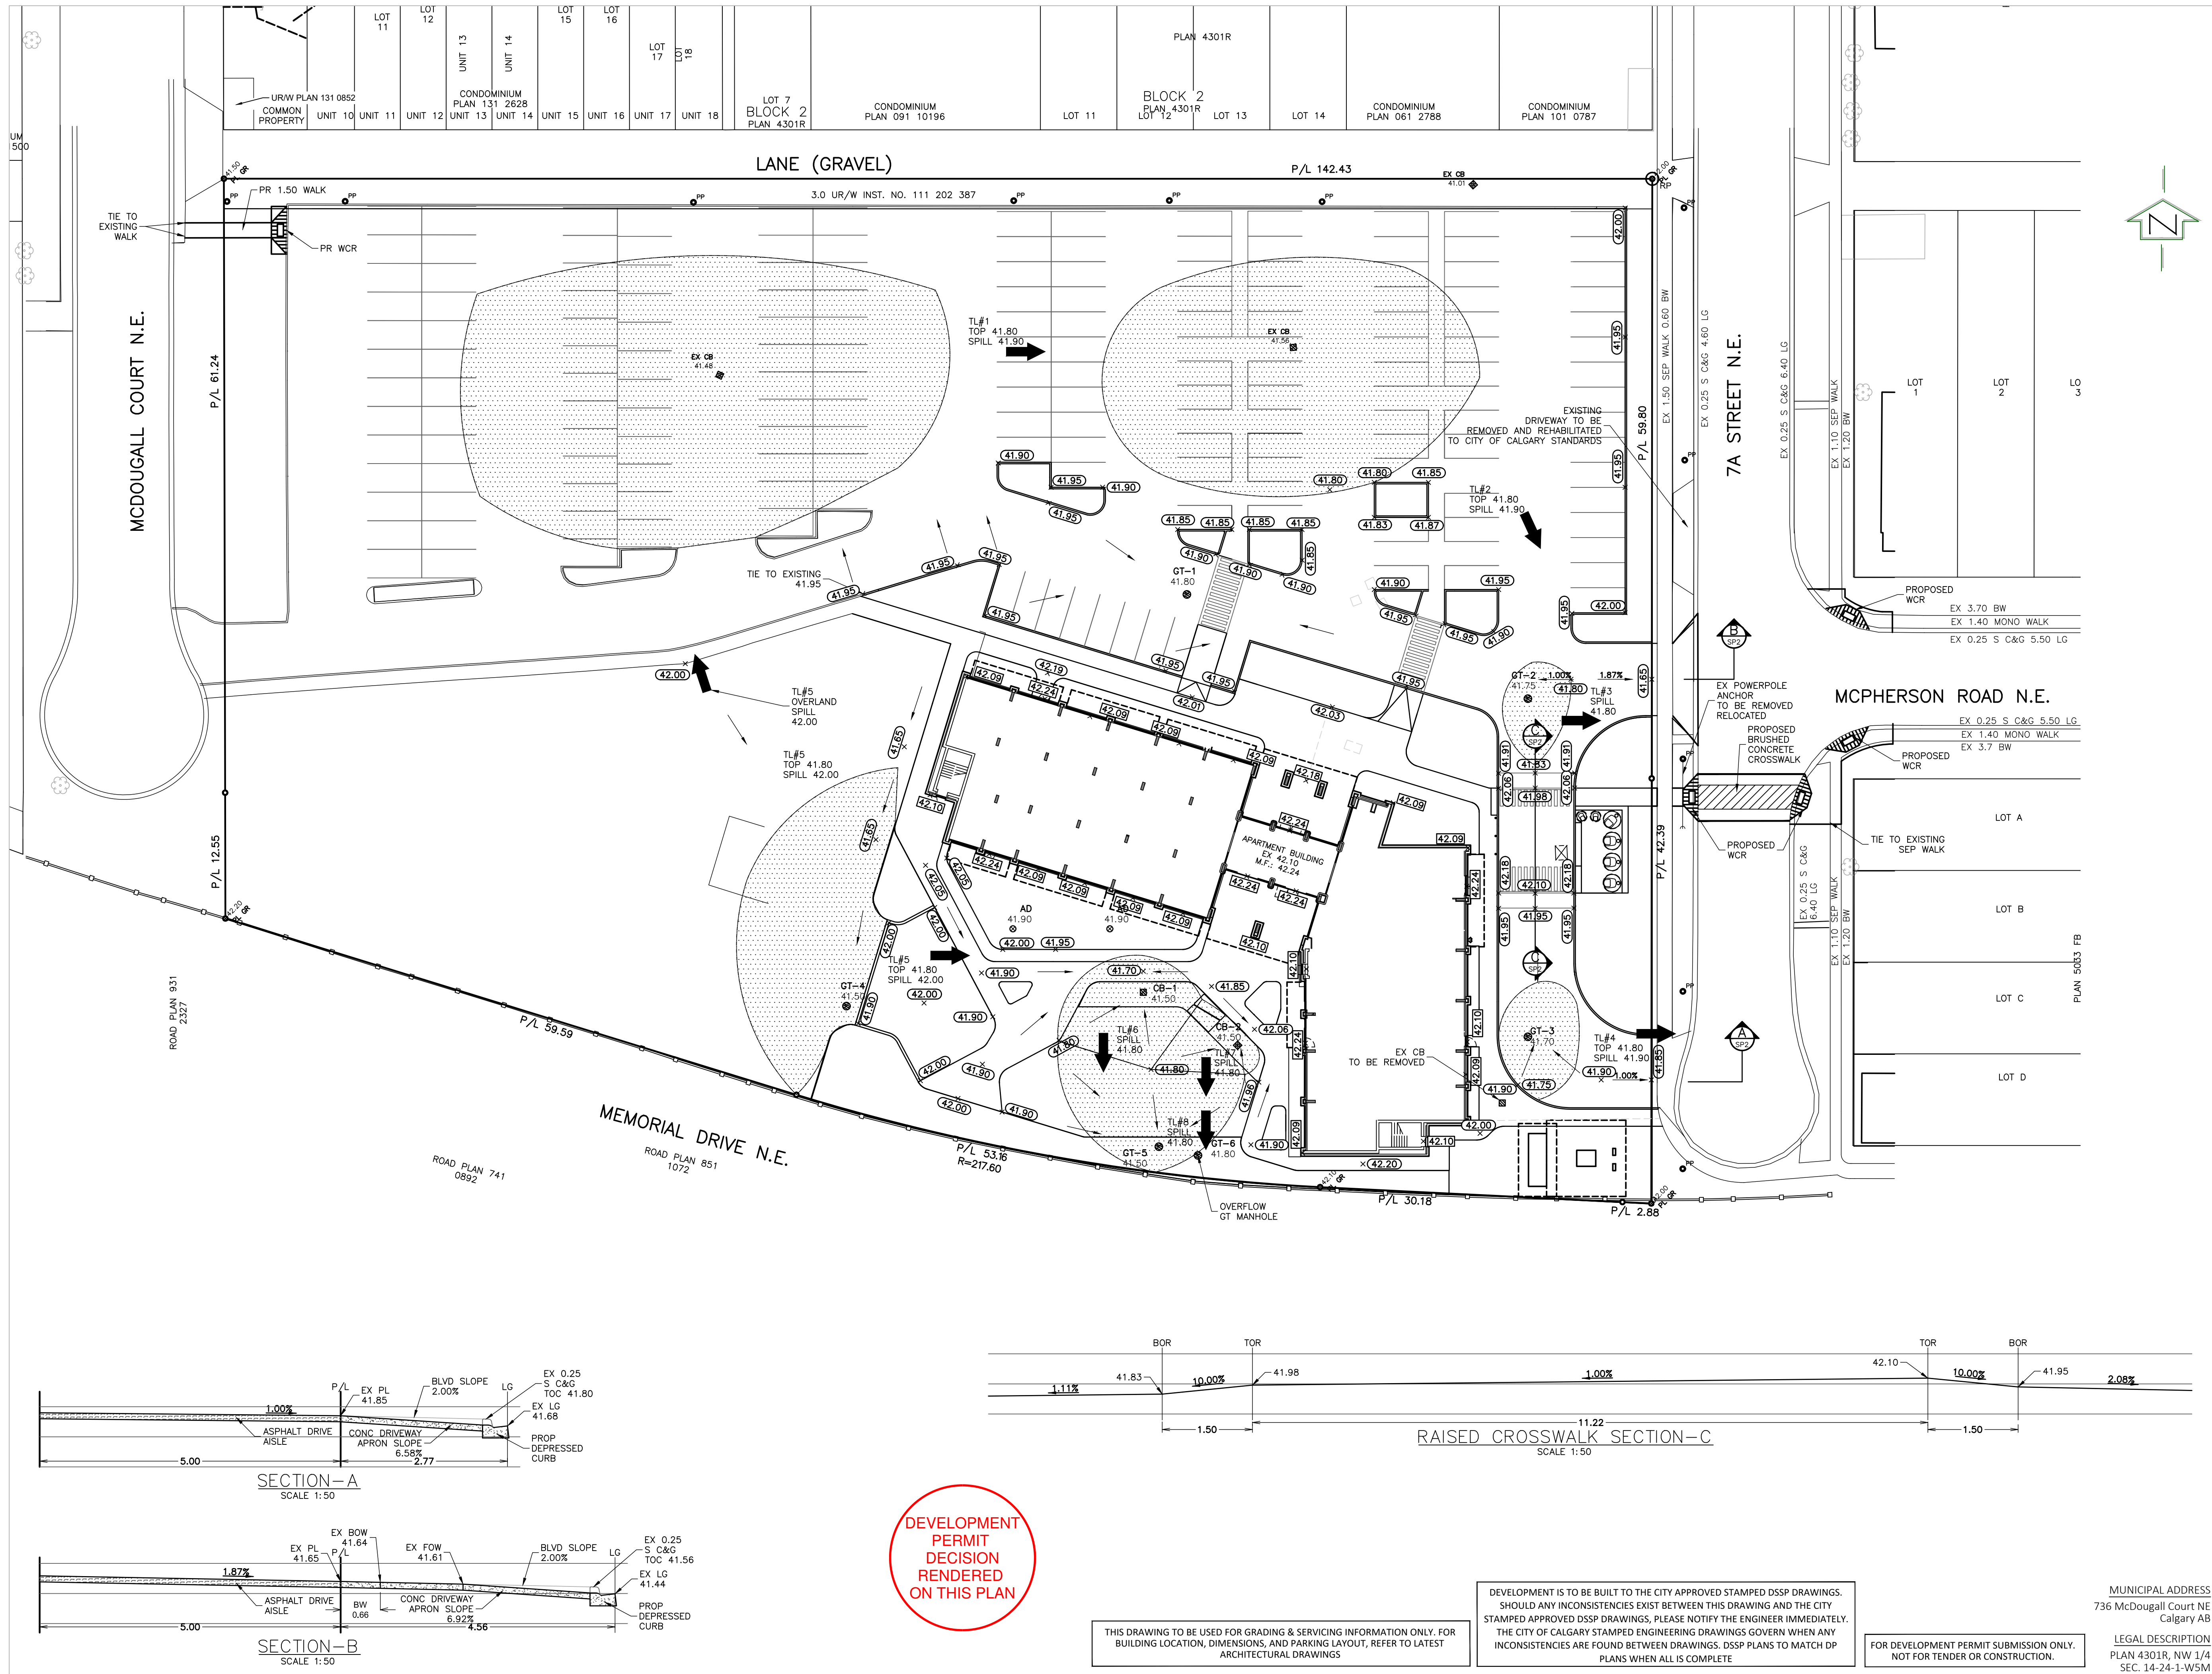

DEVELOPMENT
PERMIT
DECISION
RENDERED
ON THIS PLAN

THIS DRAWING TO BE USED FOR GRADING & SERVICING INFORMATION ONLY. FOR BUILDING LOCATION, DIMENSIONS, AND PARKING LAYOUT, REFER TO LATEST ARCHITECTURAL DRAWINGS

DEVELOPMENT IS TO BE BUILT TO THE CITY APPROVED STAMPED DSSP DRAWINGS. SHOULD ANY INCONSISTENCIES EXIST BETWEEN THIS DRAWING AND THE CITY STAMPED APPROVED DSSP DRAWINGS, PLEASE NOTIFY THE ENGINEER IMMEDIATELY. THE CITY OF CALGARY STAMPED ENGINEERING DRAWINGS GOVERN WHEN ANY INCONSISTENCIES ARE FOUND BETWEEN DRAWINGS. DSSP PLANS TO MATCH DP PLANS WHEN ALL IS COMPLETE

FOR DEVELOPMENT PERMIT SUBMISSION ONLY. NOT FOR TENDER OR CONSTRUCTION.

MUNICIPAL ADDRESS
736 McDougall Court NE
Calgary AB

LEGAL DESCRIPTION
PLAN 4301R, NW 1/4
SEC. 14-24-1-W5M

PERMIT _____ STAMP _____

NOTES
1. All elevations referenced to 1000m Geodetic Datum.

LEGEND	
	Existing hydrant
	Proposed hydrant
	Existing valve
	Valve
	Watermain
	Sanitary sewer
	Storm sewer
	Existing manhole
	Proposed manhole
	Manhole with plastic inserts
	Grated top manhole
	Catch basin
	Proposed swale
	Overland flow
	Overland escape route
	Proposed design elevation
	Proposed building grades
	Existing elevation
	Proposed road grade
	Sanitary manhole number & elevation
	CB/GT/Storm manhole number & elevation
	Traplow
	Main floor elevation
	Top of footing elevation
	Sanitary sewer invert at bldg

DEVELOPMENT PERMIT 2025-07446

REVISIONS		
No.	DATE	DESCRIPTION
5		
4		
3		
2		
1		

ISSUED FOR		
No.	DATE	DESCRIPTION
4		AS-BUILT
3		FOR CONSTRUCTION
2		FOR TENDER
1		DEVELOPMENT PERMIT
No.	DATE	DRAWING STATUS

CLIENT
HINDLE ARCHITECTS LTD.

PROJECT
BRIDGELAND PLACE - CALGARY HOUSING CORP
NUMBER OF UNITS
736 MCDUGALL COURT NE

TITLE
SITE GRADING PLAN

DESIGN BY: DV	SCALE: 1:300	JOB NUMBER: 24-208
DRAWN BY: WB	REV NO.: -	DRAWING NUMBER: SP2
CHECKED BY: DV		
DATE: 19-Jun-26		

CALGARY HOUSING BRIDGELAND PLACE

736 McDougall Court NE, Calgary, Alberta

ISSUED FOR DR 2 RESPONSE
26/06/26121 15th Avenue SE, Calgary, AB, T2G 1G1
403-460-2277 | info@embeconsulting.ca

DO NOT SCALE DRAWINGS. THE CONTRACTOR SHALL CHECK AND VERIFY ALL DIMENSIONS AND REPORT ANY DISCREPANCIES BEFORE PROCEEDING WITH THE WORKS.

NO.	ISSUED	DATE
1.	DRAFT DP	2025-09-19
2.	DEVELOPMENT PERMIT	2025-10-31
3.	DEVELOPMENT PERMIT	2025-12-25
4.	DEVELOPMENT PERMIT	2025-12-18
5.	DR 1 RESPONSE	2026-03-16
6.	DR 2 RESPONSE	2026-06-26

ELECTRICAL SHEET LIST

SHEET NUMBER	SHEET NAME
E000S	ELECTRICAL COVER PAGE
E101S	SITE PLAN - ELECTRICAL
E201S	SITE LIGHTING - POINT-BY-POINT
E202S	SITE LIGHTING RENDERINGS



SYMBOL LEGEND

SYMBOL	DESCRIPTION	SPECIFICATIONS	MOUNTING
LIGHTING LEGEND			
	RECESSED DOWNLIGHT LUMINAIRE, TYPE XX	SEE SCHEDULE	CEILING RECESSED
	SURFACE MOUNTED DOWNLIGHT LUMINAIRE, TYPE XX	SEE SCHEDULE	CEILING SURFACE MOUNT
	PENDANT LUMINAIRE, TYPE XX	SEE SCHEDULE	CEILING SUSPENDED
	WALL SCONCE LUMINAIRE, TYPE XX	SEE SCHEDULE	WALL
	TRACK LUMINAIRE C/W TRACK HEADS INDICATED	SEE SCHEDULE	CEILING
	LINEAR WALL MOUNT LUMINAIRE, TYPE XX	SEE SCHEDULE	WALL
	SURFACE MOUNTED WRAP LUMINAIRE, LUMINAIRE TYPE XX	SEE SCHEDULE	CEILING SURFACE
	SURFACE/SUSPENDED LUMINAIRE, TYPE XX	SEE SCHEDULE	CEILING SURFACE /SUSPENDED
	1'x4' LUMINAIRE, TYPE XX	SEE SCHEDULE	RECESSED
	2'x2' LUMINAIRE, TYPE XX	SEE SCHEDULE	RECESSED
	2'x4' LUMINAIRE, TYPE XX	SEE SCHEDULE	RECESSED
	STRIP LUMINAIRE, TYPE XX (SEE SCHEDULE FOR LENGTH)	SEE SCHEDULE	CEILING SURFACE /SUSPENDED
	IN GROUND LUMINAIRE, TYPE XX	SEE SCHEDULE	SEE LUMINAIRE SCHEDULE
	EXTERIOR POLE LUMINAIRE (SINGLE HEAD), TYPE XX	SEE SCHEDULE	SEE LUMINAIRE SCHEDULE
	EXTERIOR POLE LUMINAIRE (DOUBLE HEAD), TYPE XX	SEE SCHEDULE	SEE LUMINAIRE SCHEDULE
	EXTERIOR POLE LUMINAIRE (FOUR HEAD), TYPE XX	SEE SCHEDULE	SEE LUMINAIRE SCHEDULE
	BOLLARD, TYPE XX	SEE SCHEDULE	SEE LUMINAIRE SCHEDULE
EMERGENCY LIGHTING LEGEND			
	EXIT LIGHT, SEE FLOOR PLAN FOR DIRECTIONAL ARROWS WHERE APPLICABLE	SEE SCHEDULE	WALL 84in/2134mm
	EXIT LIGHT, SEE FLOOR PLAN FOR DIRECTIONAL ARROWS WHERE APPLICABLE	SEE SCHEDULE	CEILING 144" AFF
	EXIT LIGHT C/W BATTERY PACK & REMOTE HEADS, SEE FLOOR PLAN FOR DIRECTIONAL ARROWS WHERE APPLICABLE	SEE SCHEDULE	WALL, 84in/2134mm
	EMERGENCY DOUBLE REMOTE HEADS	SEE SCHEDULE	6" BELOW CEILING OR WALL 84in/2134mm
	EMERGENCY DOUBLE REMOTE HEADS	SEE SCHEDULE	6" BELOW CEILING
	VANDAL PROOF EMER. DOUBLE REMOTE HEADS	SEE SCHEDULE	6" BELOW CEILING OR WALL 84in/2134mm
	VANDAL PROOF EMER. DOUBLE REMOTE HEADS	SEE SCHEDULE	6" BELOW CEILING
	BATTERY PACK C/W REMOTE HEADS	SEE SCHEDULE	WALL, 84in/2134mm
LIGHTING CONTROLS LEGEND			
	SINGLE POLE SWITCH, 15A		WALL, 45in/1150mm
	3-WAY SWITCH, 15A		WALL, 45in/1150mm
	SINGLE POLE SWITCH 'a' - SEE CIRCUIT FOR CONTROL		WALL, 45in/1150mm
	DIMMER SWITCH - SEE CIRCUIT FOR CONTROLS		WALL, 45in/1150mm
	VACANCY SWITCH		WALL, 45in/1150mm
	VARIABLE SPEED SWITCH		WALL, 45in/1150mm
	MASTER SWITCH - SEE LIGHTING CONTROL DETAILS.		WALL, 45in/1150mm
	OCCUPANCY SENSOR		CEILING
	DIMMING OCCUPANCY SENSOR		CEILING
	OCCUPANCY SENSOR		WALL, 45in/1150mm
	DIMMING OCCUPANCY SENSOR		WALL, 45in/1150mm
	DAYLIGHT SENSOR		CEILING
	WALL MOUNTED PHOTO CELL		SEE DRAWING
* HATCHED LUMINAIRE WITH /NL INDICATES LIGHTING TO BE ON NIGHT LIGHT CIRCUIT			

POWER LEGEND			
	DUPLX RECEPTACLE - 120V/15A (5-15R)	LEVITON SERIES - WHITE	12in/305mm OR AS NOTED
	FOURPLEX RECEPTACLE - 120V/15A (5-15R)	LEVITON SERIES - WHITE	12in/305mm OR AS NOTED
	FOURPLEX RECEPTACLE - 120V/20A (5-20R)	LEVITON SERIES - WHITE	12in/305mm OR AS NOTED
	GFCI DUPLX RECEPTACLE - 120V/15A (5-15RA)	LEVITON SMARTLOCK SERIES, WHITE	12in/305mm OR AS NOTED
	DUPLX RECEPTACLE - 120V/20A (5-20R)	LEVITON SERIES - WHITE	12in/305mm OR AS NOTED
	GFCI DUPLX RECEPTACLE - 120V/20A (5-20RA)	LEVITON SMARTLOCK SERIES, WHITE	12in/305mm OR AS NOTED
	GFCI FOURPLEX RECEPTACLE - 120V/15A (5-15RA)	LEVITON SMARTLOCK SERIES, WHITE	12in/305mm OR AS NOTED
	GFCI FOURPLEX RECEPTACLE - 120V/20A (5-20RA)	LEVITON SMARTLOCK SERIES, WHITE	12in/305mm OR AS NOTED
	GFCI FOURPLEX RECEPTACLE - SWITCHED	LEVITON SMARTLOCK SERIES, WHITE	12in/305mm OR AS NOTED
	TAMPER PROOF RECEPTACLE - 120V/15A	LEVITON AFTR1 SERIES	12in/305mm OR AS NOTED
	TAMPER PROOF RECEPTACLE - 120V/20A	LEVITON AFTR1 SERIES	12in/305mm OR AS NOTED
	USB DUPLX RECEPTACLE - 120V/15A	LEVITON T5632, WHITE	12in/305mm OR AS NOTED
	USB DUPLX RECEPTACLE - 120V/20A	LEVITON T5632, WHITE	12in/305mm OR AS NOTED
	HOSPITAL GRADE DUPLX RECEPTACLE	LEVITON HOSPITAL GRADE SMARTLOCK SLIM	12in/305mm OR AS NOTED
	HOSPITAL GRADE FOURPLEX RECEPTACLE	LEVITON HOSPITAL GRADE SMARTLOCK SLIM	12in/305mm OR AS NOTED
	HOSPITAL GRADE GFCI DUPLX RECEPTACLE	LEVITON HOSPITAL GRADE SMARTLOCK SLIM	12in/305mm OR AS NOTED
	HOSPITAL GRADE GFCI FOURPLEX RECEPTACLE	LEVITON HOSPITAL GRADE SMARTLOCK SLIM	12in/305mm OR AS NOTED
	HOSPITAL GRADE DUPLX RECEPTACLE - 120V/20A	LEVITON HOSPITAL GRADE SMARTLOCK SLIM	12in/305mm OR AS NOTED
	HOSPITAL GRADE GFCI DUPLX RECEPTACLE - 120V-20A	LEVITON HOSPITAL GRADE SMARTLOCK SLIM	12in/305mm OR AS NOTED
	DUPLX RECEPTACLE - SWITCHED		12in/305mm OR AS NOTED
	PARKING LOT DUPLX RECEPTACLE IN POST		SEE DETAIL
	PARKING LOT SINGLE RECEPTACLE IN POST		SEE DETAIL
	ISOLATED GROUND RECEPTACLE		12in/305mm OR AS NOTED
	FLOOR BOX C/W RECEPTACLE & DATA OUTLET (SEE DRAWING FOR QUANTITY AND RECEPTACLE TYPES)		FLOOR MOUNTED
	POWER PAC POLE		FLOOR MOUNTED
	VACUUM OUTLET		
	SPECIAL RECEPTACLE	LEVITON SPEC GRADE, WHITE	12in/305mm OR AS NOTED
	HARDWIRED CONNECTION		12in/305mm OR AS NOTED
	DISCONNECT SWITCH		60in/1525mm OR AS NOTED
	JUNCTION BOX		
	MOTOR		
	MAGNETIC STARTER		WALL, 45in/1150mm
	SPEAKER		CEILING
	SPEAKER		
	THERMOSTAT		WALL MOUNTED
	CEILING FAN		CEILING
	RADIANT HEATER		WALL MOUNTED
	BASEBOARD HEATER	OULLET SERIES	WALL MOUNTED
	FORCE FLOW HEATER	OULLET SERIES	WALL MOUNTED
	ELECTRICAL PANEL - SEE PANEL SCHEDULE		WALL MOUNTED
	TELEPHONE TERMINAL BOARD		WALL MOUNTED
	TRANSFORMER		

FIRE ALARM LEGEND			
	FIRE ALARM CONTROL PANEL	SIMPLEX OR APPROVED EQUIVALENT	2400mm MAX AT TOP OF PANEL
	FIRE ALARM ANNUNCIATOR PANEL	SIMPLEX OR APPROVED EQUIVALENT	600mm MIN-1800mm MAX
	FIRE ALARM SMOKE DETECTOR	SIMPLEX OR APPROVED EQUIVALENT	CEILING
	FIRE ALARM HEAT DETECTOR	SIMPLEX OR APPROVED EQUIVALENT	CEILING
	FIRE ALARM COMBINATION HEAT/SMOKE DETECTOR	SIMPLEX OR APPROVED EQUIVALENT	CEILING
	FIRE ALARM RELAY DEVICE	SIMPLEX OR APPROVED EQUIVALENT	WALL
	FIRE ALARM MANUAL PULL STATION	SIMPLEX OR APPROVED EQUIVALENT	45in/1150mm
	FIRE ALARM COMBINATION HORN-STROBE 15cd UNLESS OTHERWISE INDICATED	SIMPLEX OR APPROVED EQUIVALENT	84in/2134mm
	FIRE ALARM STROBE 15cd UNLESS OTHERWISE INDICATED	SIMPLEX OR APPROVED EQUIVALENT	84in/2134mm
	FIRE ALARM HORN	SIMPLEX OR APPROVED EQUIVALENT	94in/2400mm
	LOW TEMPERATURE SENSOR	HONEYWELL T-1000	WALL
	FIRE ALARM SPEAKER 1W UNLESS OTHERWISE INDICATED	SIMPLEX OR APPROVED EQUIVALENT	CEILING
	FIRE ALARM COMBINATION SPEAKER STROBE 1W/15cd UNLESS OTHERWISE INDICATED	SIMPLEX OR APPROVED EQUIVALENT	84in/2134mm
	FIRE ALARM SPRINKLER TAMPER SWITCH	SIMPLEX OR APPROVED EQUIVALENT	
	FIRE ALARM SPRINKLER FLOW SWITCH	SIMPLEX OR APPROVED EQUIVALENT	
	FIRE ALARM COMBINATION BELL-STROBE 15cd UNLESS OTHERWISE INDICATED	SIMPLEX OR APPROVED EQUIVALENT	84in/2134mm
	FIRE ALARM BELL	SIMPLEX OR APPROVED EQUIVALENT	84in/2134mm
	SUITE LOW FREQUENCY HORN	SIMPLEX OR APPROVED EQUIVALENT	84in/2134mm
	SMOKE ALARM C/W INTEGRAL CO ALARM	SIMPLEX OR APPROVED EQUIVALENT	CEILING
	FIRE ALARM ISOLATION MODULE (SEE FLOOR PLAN FOR NUMBERINGS)	SIMPLEX OR APPROVED EQUIVALENT	
	EMERGENCY FIRE PHONE	SIMPLEX OR APPROVED EQUIVALENT	57in/1450mm
	CO ALARM	SIMPLEX OR APPROVED EQUIVALENT	18in/457mm
	FIRE ALARM END OF LINE RESISTOR	SIMPLEX OR APPROVED EQUIVALENT	47in/1200mm
SECURITY			
	CARD READER		WALL, 45in/1150mm
	KEY PAD		WALL, 45in/1150mm
	MAGNETIC DOOR HOLD OPEN DEVICE		WALL, 45in/1150mm
	HANDICAP PUSH BUTTON		WALL, 45in/1150mm
	BUZZER		WALL, 45in/1150mm
	DOOR RELEASE		WALL, 45in/1150mm
	MAGNETIC LOCK		WALL, 45in/1150mm
	ALARM CONTACT		WALL, 45in/1150mm
	SECURITY MOTION SENSOR		SEE DRAWING
	SECURITY CAMERA		SEE DRAWING
	PUSH BUTTON		43in/1100mm MAX
	ELECTRIC STRIKE		WALL, 45in/1150mm
	MOTION DETECTOR		WALL, 45in/1150mm
	MOTION DETECTOR		CEILING
COMMUNICATIONS			
	WIRELESS ACCESS POINT		CEILING
	SECURITY CONTROL PANEL		SEE DRAWING
	DATA OUTLET (4PORT WITH 4 DATA LINE). NUMBER(n) INDICATES NUMBER OF PORTS(4) AND NUMBER OF DATA LINE(4)		12in/305mm OR AS NOTED

	VOICE AND DATA COMM. OUTLET (2PORT WITH 2 DATA LINE)		12in/305mm OR AS NOTED
	2 VOICE AND 2 DATA COMM. OUTLET (4PORT WITH 4 DATA LINE)		12in/305mm OR AS NOTED
	TELEPHONE OUTLET (2 PORT WITH 2 DATA LINE)		12in/305mm OR AS NOTED
	DATA OUTLET (2PORT WITH 2 DATA LINE)		12in/305mm OR AS NOTED
	TELEVISION OUTLET (HDMI AND COAX)		60in/1524mm OR AS NOTED
TAGS/OTHER			
	LUMINAIRE TAG - SEE LUMINAIRE SCHEDULE		
	KITCHEN/ELECTRICAL EQUIPMENT TAG		
	MECHANICAL EQUIPMENT TAG		
	A.F.F.		ABOVE FINISHED FLOOR
	A.C.		ABOVE COUNTER
	NL		NIGHT LIGHT - CIRCUIT TO NIGHT LIGHT BREAKER
	ER		EXISTING TO REMAIN
	WP		WEATHERPROOF
	RL'D		RELOCATED
	R		REMOVE
	RL		RELOCATE
	A-XX		PANEL 'A', CIRCUIT XX
			CONDUIT HOME RUN
			CIRCLE DENOTES CEILING MOUNTED DEVICE
			SQUARE DENOTES FLOOR MOUNTED DEVICE
	EF1		EQUIPMENT TAG - SEE SCHEDULES
NOTE: MOUNTING IS INDICATED FROM FINISHED FLOOR TO CENTER OF DEVICE. MOUNTING HEIGHTS INDICATED ON DRAWINGS OR SPECIFICATIONS HAVE PRECEDENCE OVER THIS LEGEND. ANY UNLISTED MOUNTING HEIGHTS TO BE CONFIRMED PRIOR TO INSTALLATION.			
NOTE: APPROVED ALTERNATIVE MANUFACTURERS MAY BE ACCEPTED.			

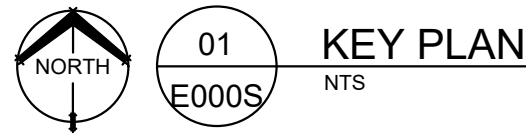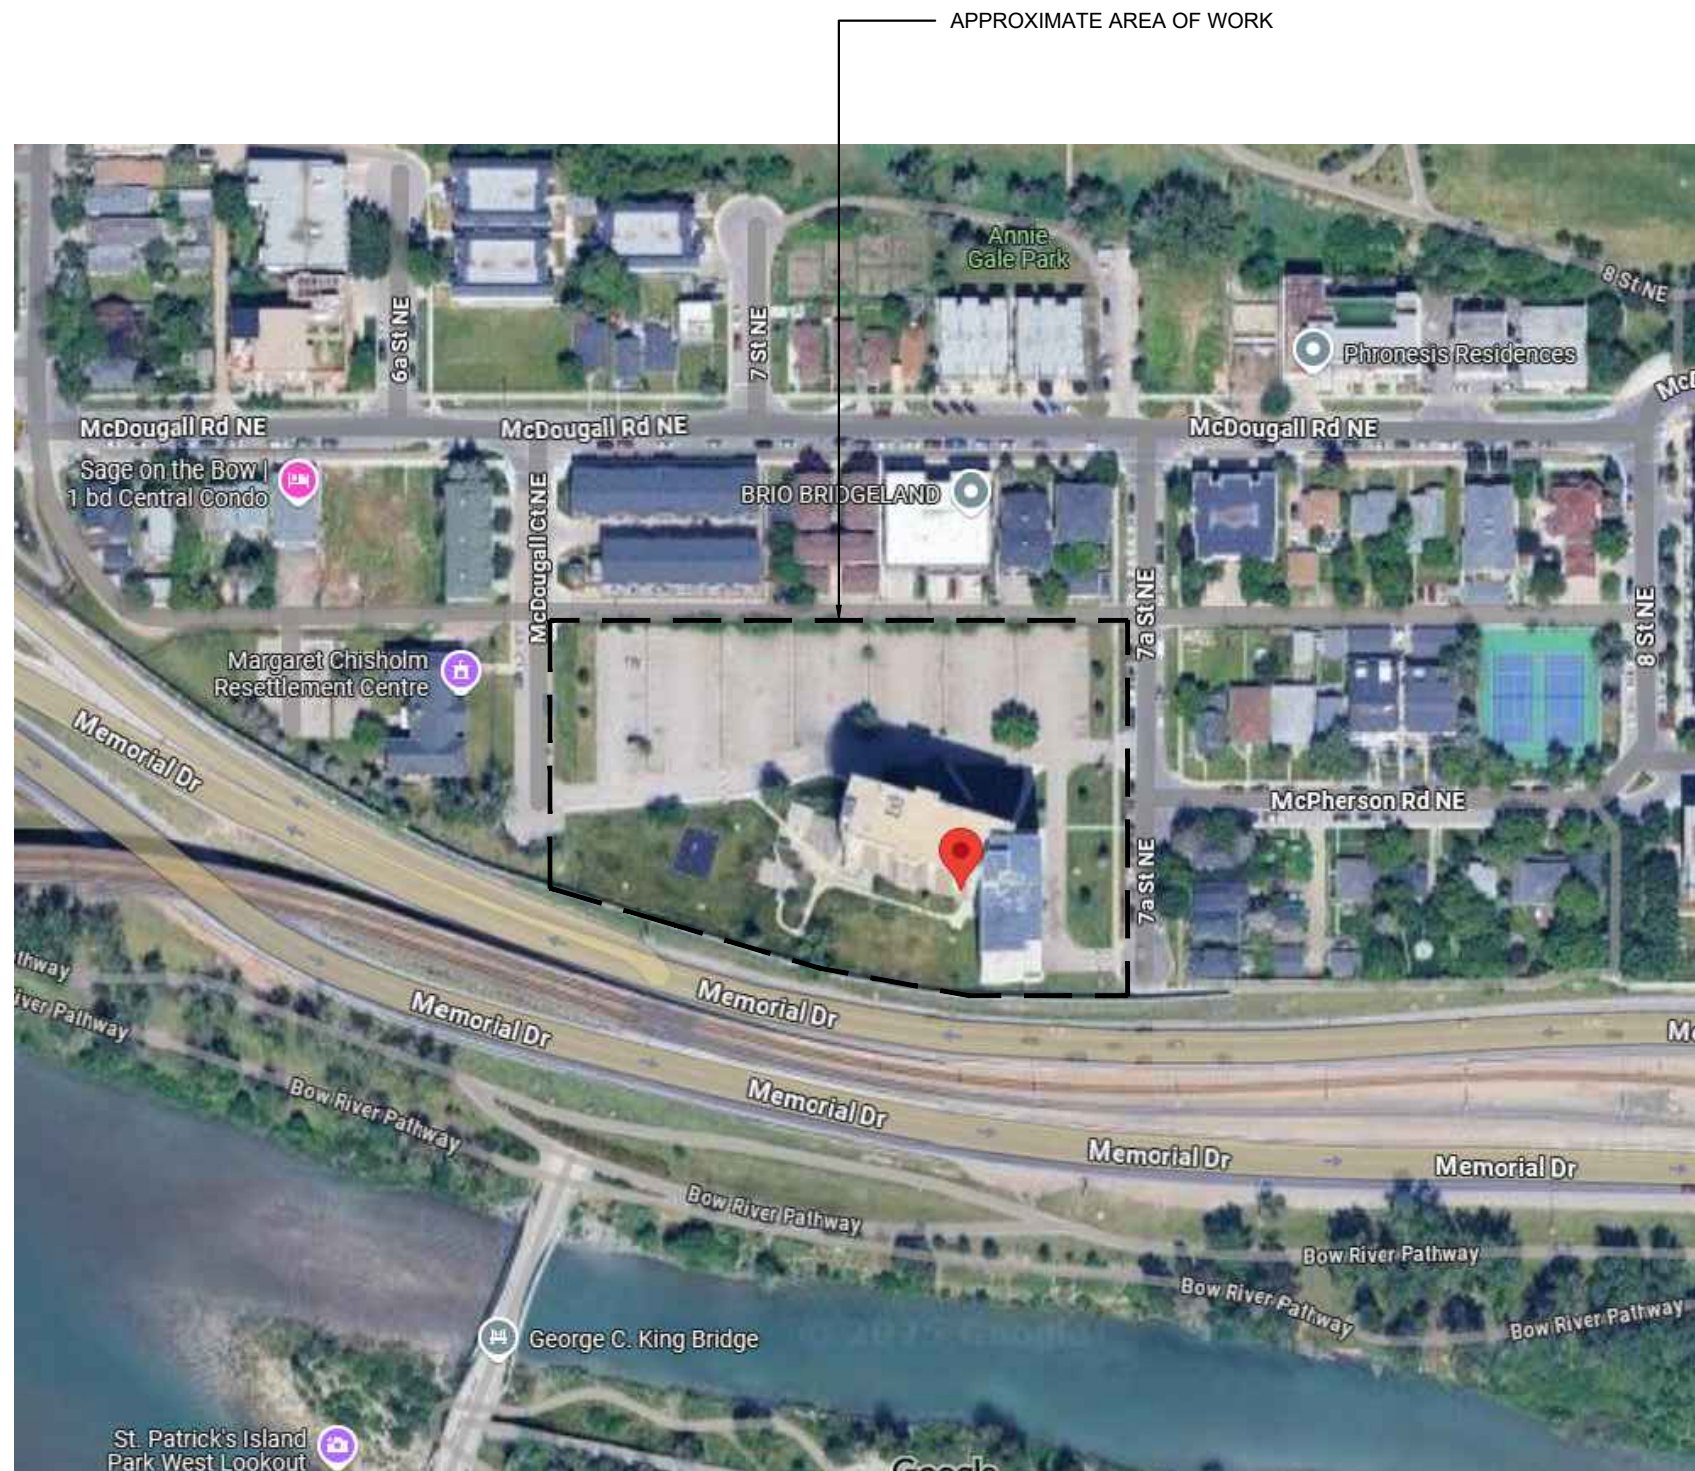DEVELOPMENT
PERMIT
DECISION
RENDERED
ON THIS PLAN

STAMP & SEAL

CLIENT

HINDLE ARCHITECTS

PROJECT

CALGARY HOUSING
BRIDGELAND PLACE

736 McDougall Court NE, Calgary AB

TITLE

ELECTRICAL
COVER PAGE

PROJECT NUMBER

25001

DRAWING NUMBER

HA/DK

E000S