


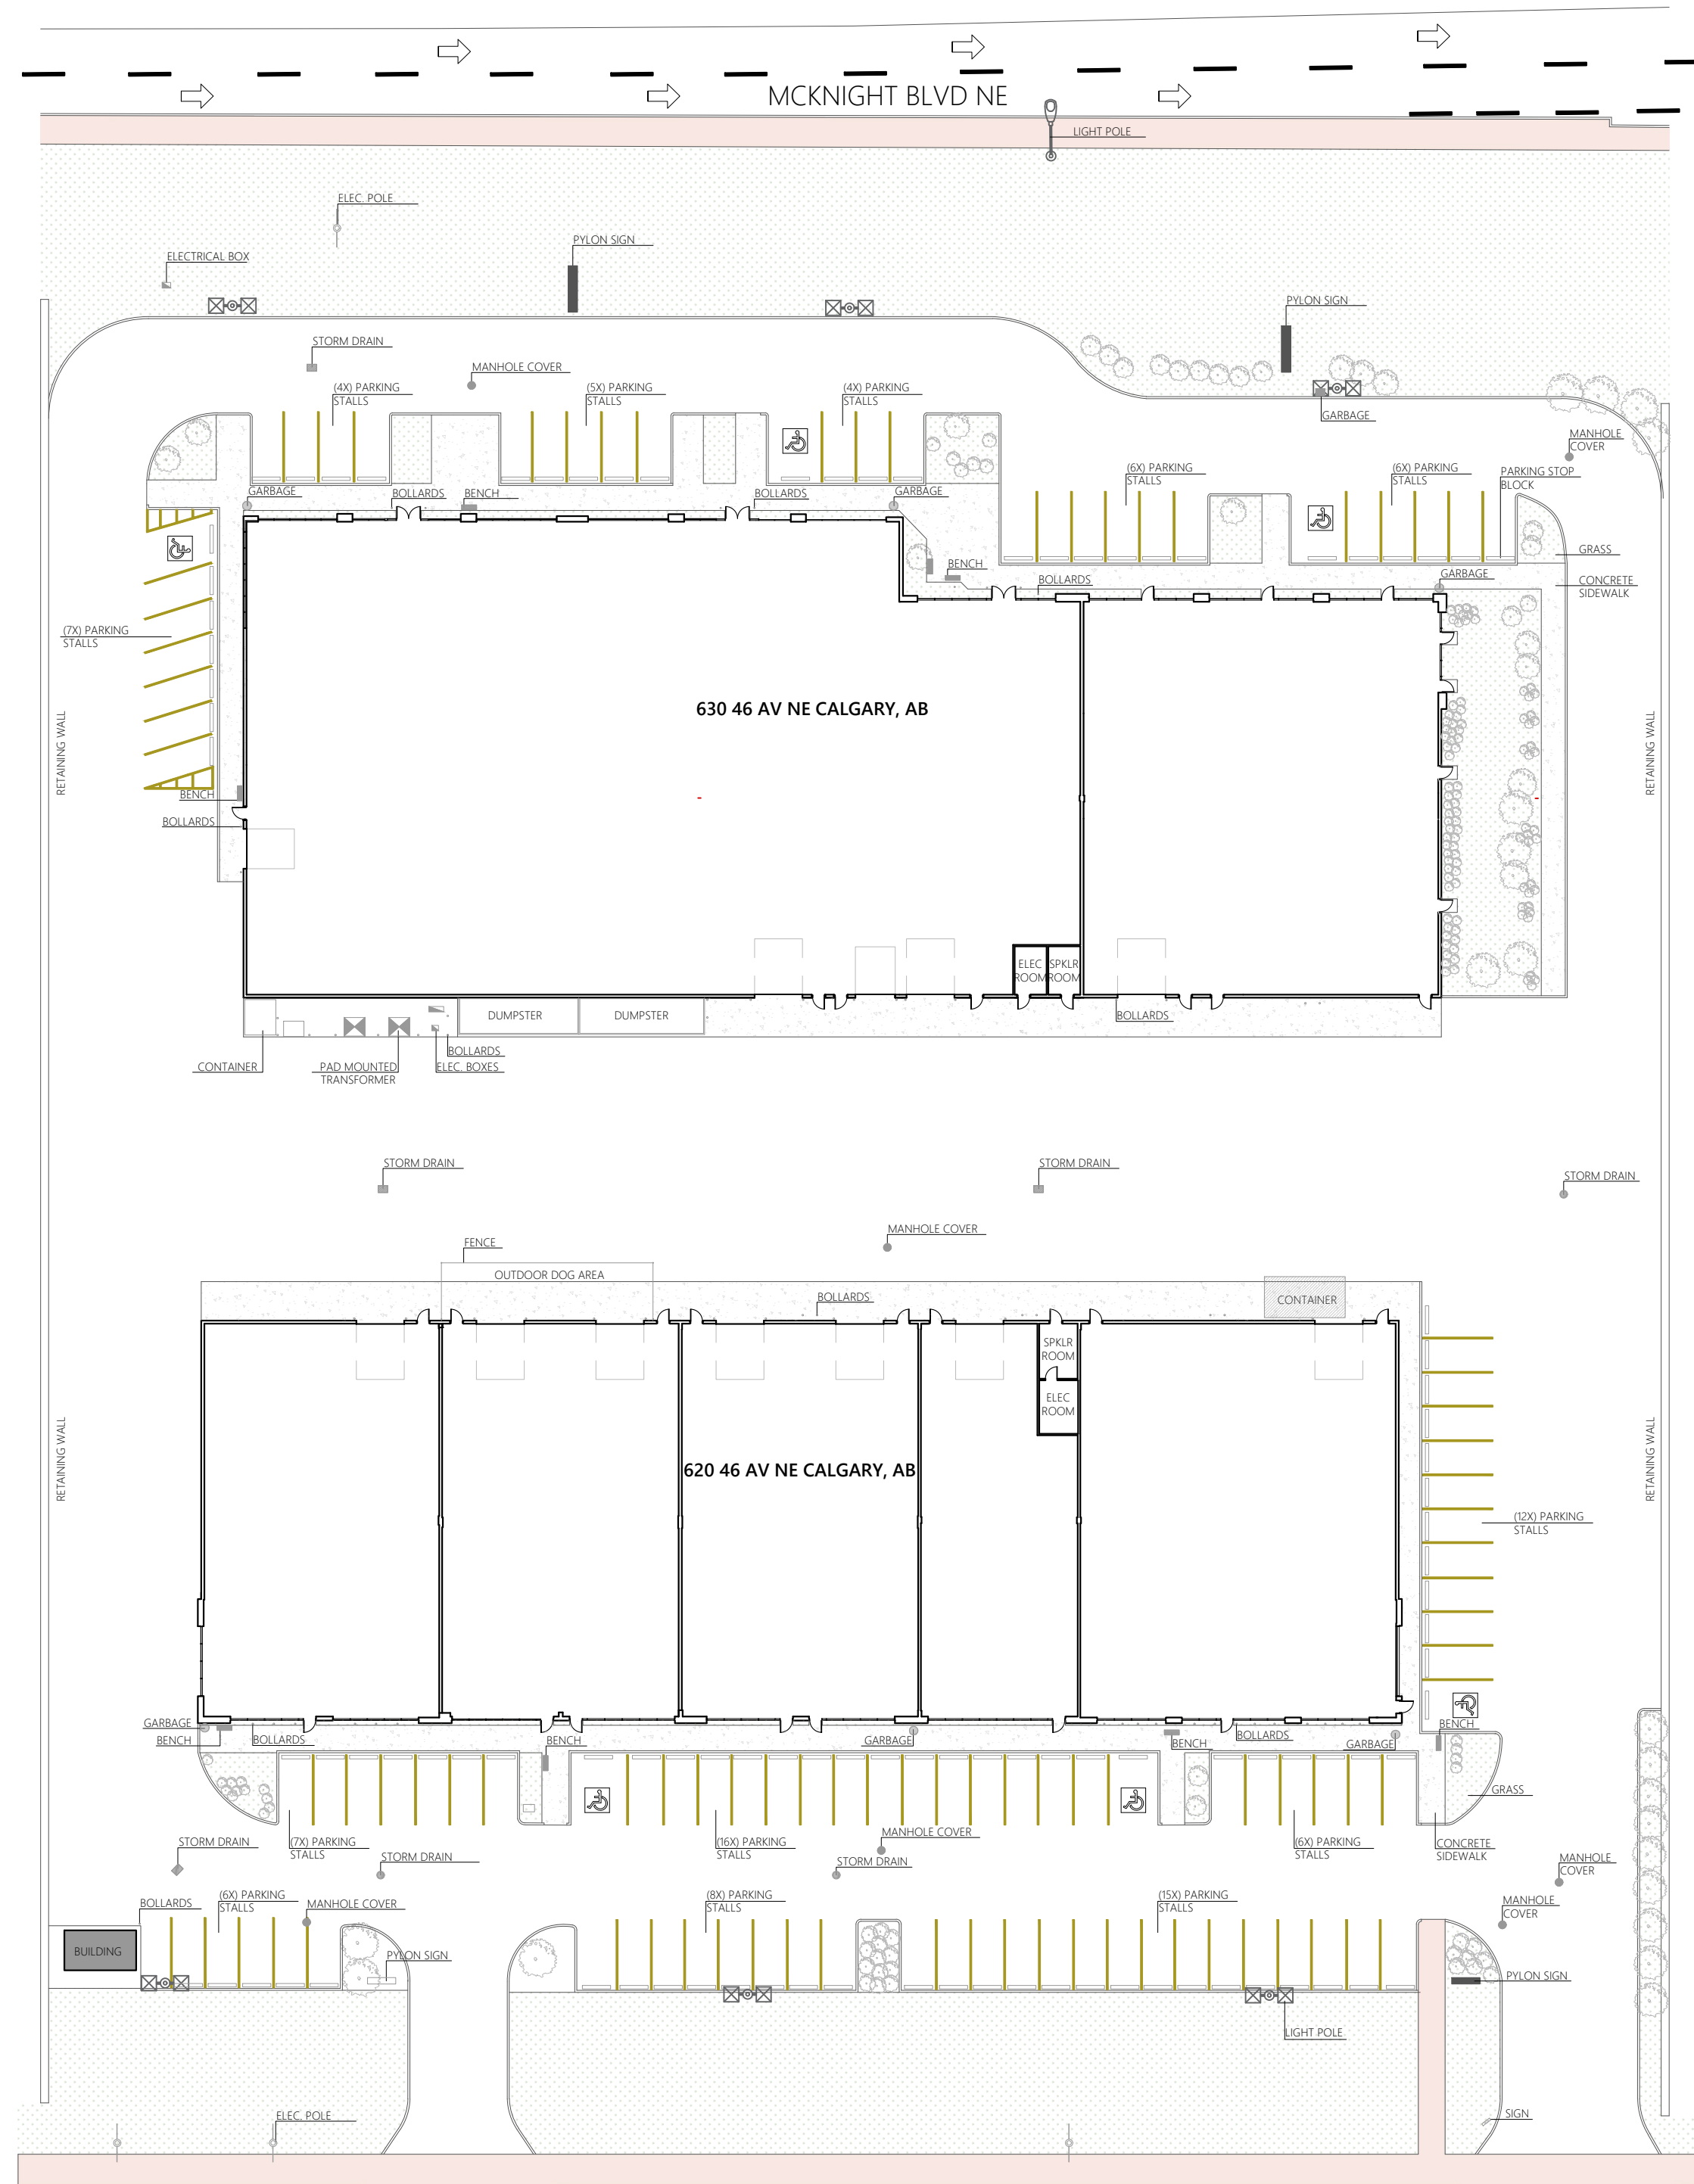

46 AVE NE

0' 20' 40' 80'

N/A

SITE PLAN

620 & 630
46 AV NE
CALGARY, AB

PREPARED FOR:



MEASUREMENT STANDARD:

ANSI/BOMA Z65.2-2019

LAND USE:

DC

RENTABLE AREA:

63,823 SQ FT.

NOTES:

SURVEYED BY:
RV

PREPARED BY:
TI

DRAWING TITLE:
SITE PLAN

SURVEY DATE:
21/05/24-
23/05/24

SHEET:
AB-A01

PROJECT NUMBER: 4525



+1 (403) 830-5591

asbuilt.ca