
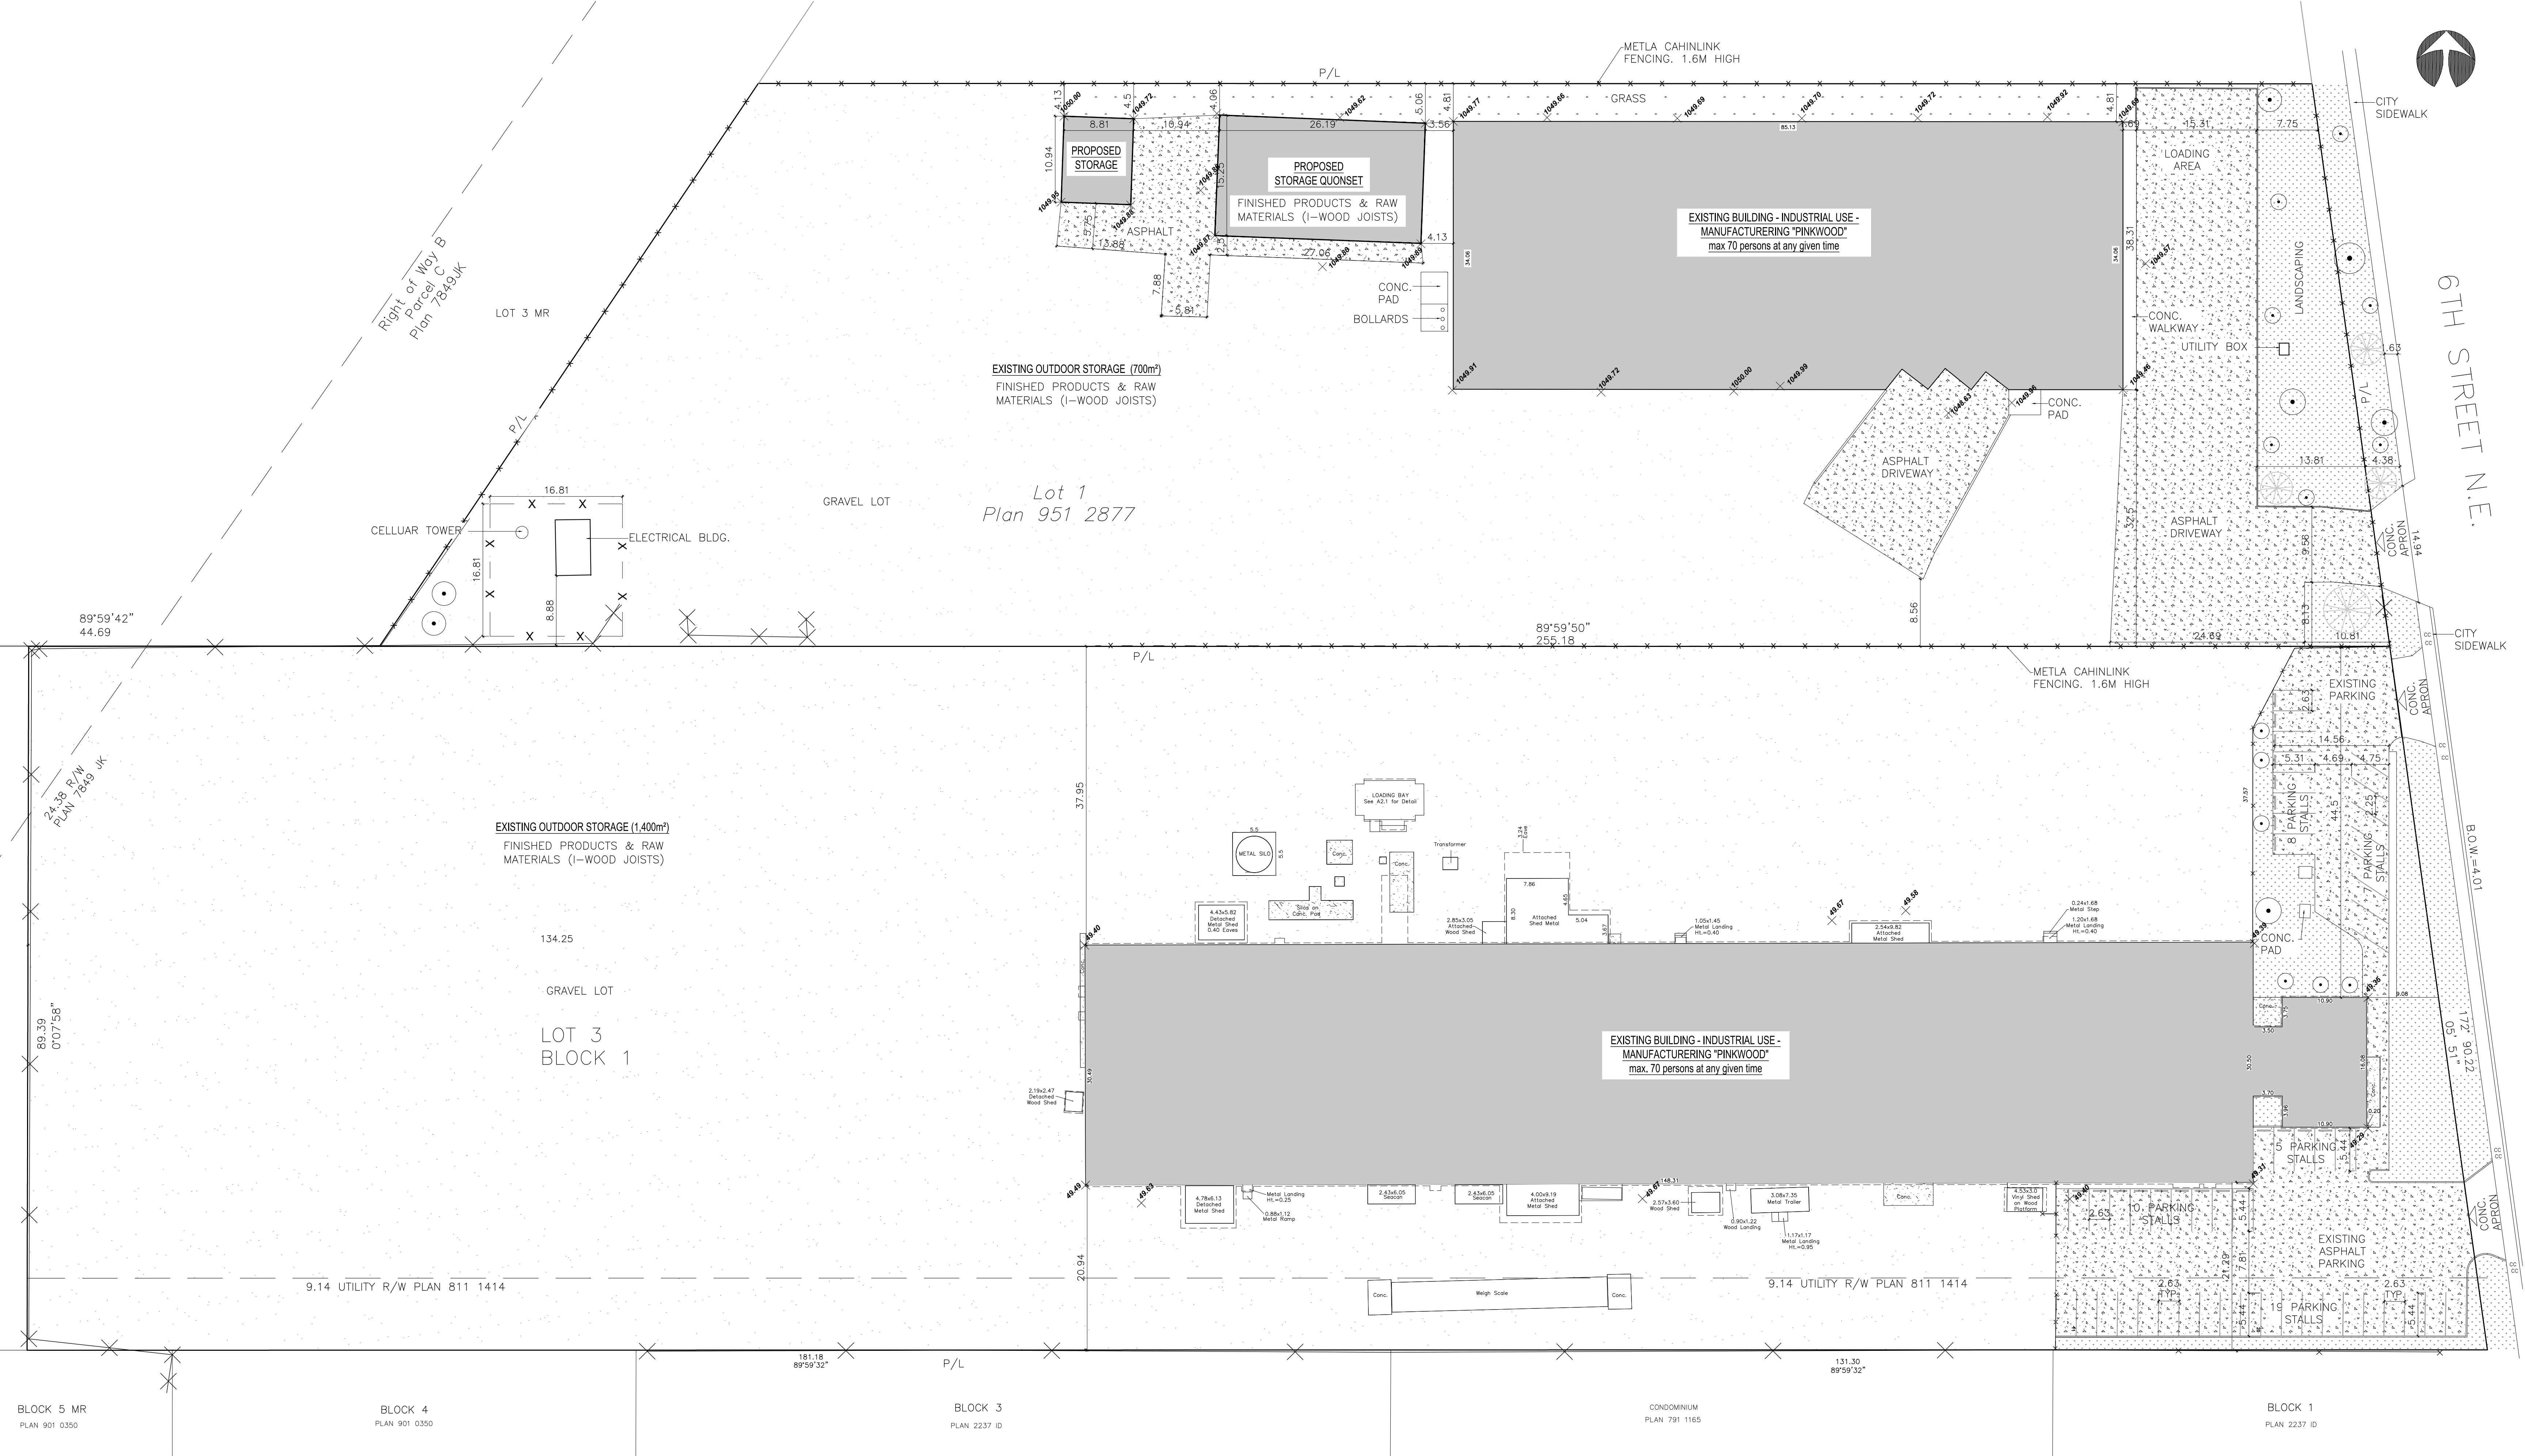


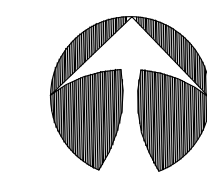

# DEVELOPMENT PERMIT FOR AS-BUILT OUTDOOR STRUCTURES

**5929 & 5935 6 ST NE, CALGARY, AB**  
**Lot 1&3, BLOCK 1, Plan 951 2877**


 
**SCOPE OF WORK:**  
EXISTING OUTDOOR STRUCTURES. UPDATING RECORDS & COMPLIANCE.

NO PROPOSED CHANGES TO THE DRIVEWAY, PARKING, OR LANDSCAPING. EXISTING TO REMAIN AS IS.


**STATEMENT OF USE:**  
EXISTING USE OF MANUFACTURING & STORAGE. OUTDOOR AREA, QUONSET & GARAGE USED AS STORAGE FOR ENGINEERED WOOD PRODUCTS. NO PROPOSED CHANGES.

**OUTDOOR STORAGE USE:**  
PER DIRECT CONTROL Bylaw No. 50Z93. MAXIMUM PERMITTED OUTDOOR STORAGE SHALL NOT EXCEED 5% OF THE TOTAL SITE AREA.  
SITE AREA= ±43,358 m<sup>2</sup>  
MAX PERMITTED STORAGE= 2,168m<sup>2</sup>


| SYMBOL | DESCRIPTION              |
|--------|--------------------------|
|        | EXISTING BUILDING        |
|        | ASPHALT                  |
|        | PROPERTY LINE            |
|        | UTILITY LINE             |
|        | EXISTING CHAINLINK FENCE |
|        | EXISTING LANDSCAPING     |
|        | EXISTING SHRUB           |
|        | EXISTING TREE            |
|        | EXISTING GRADE           |

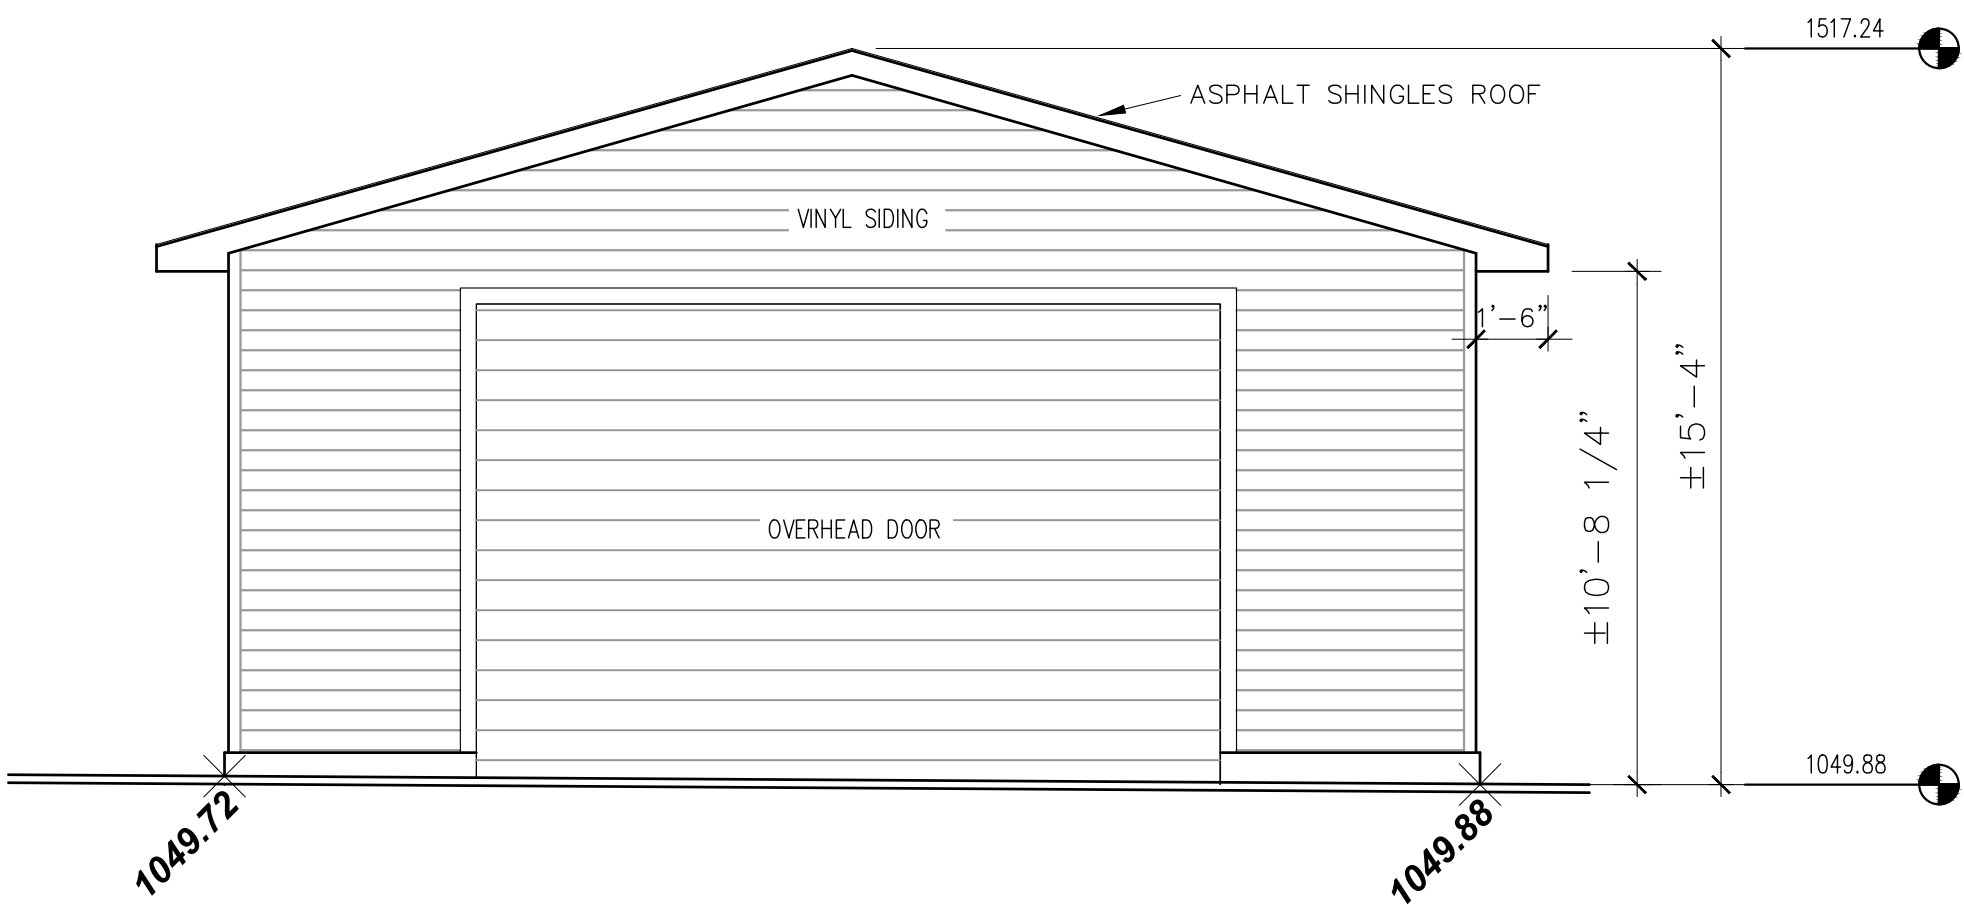


1  
A2.1 **FRONT ELEVATION**  
SCALE: 1/4" = 1'-0"

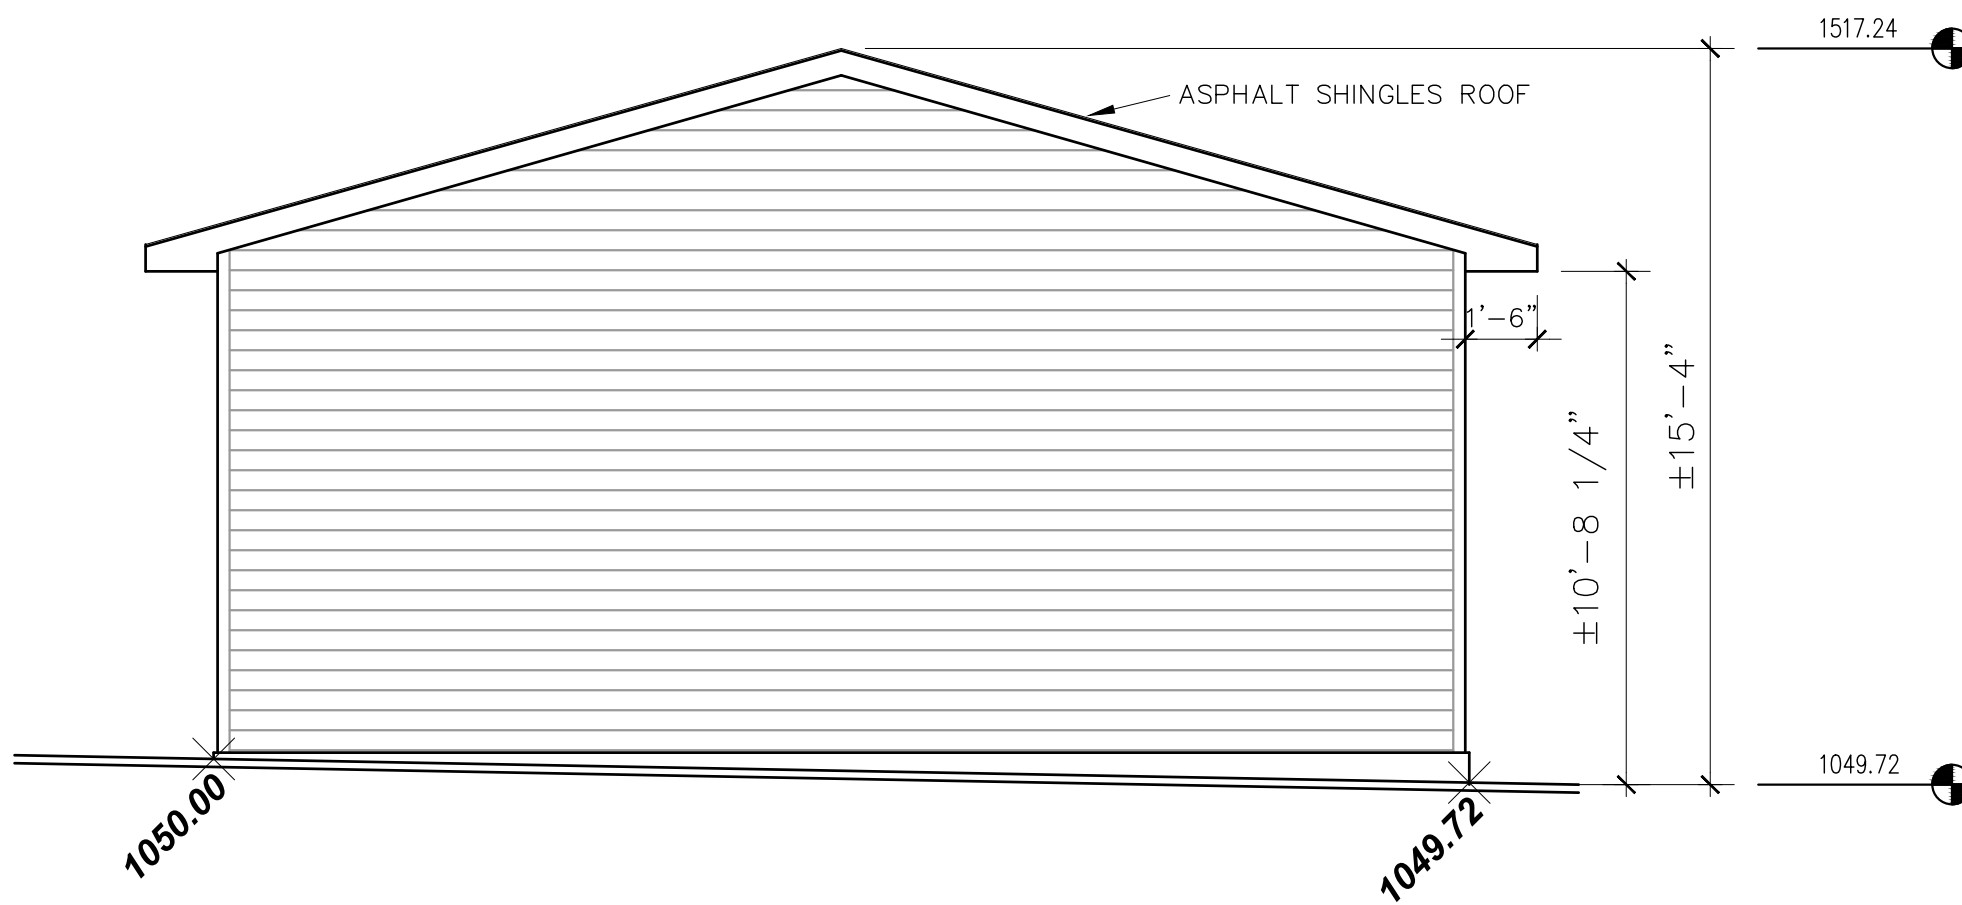

1  
A2.1 **REAR ELEVATION**  
SCALE: 1/4" = 1'-0"

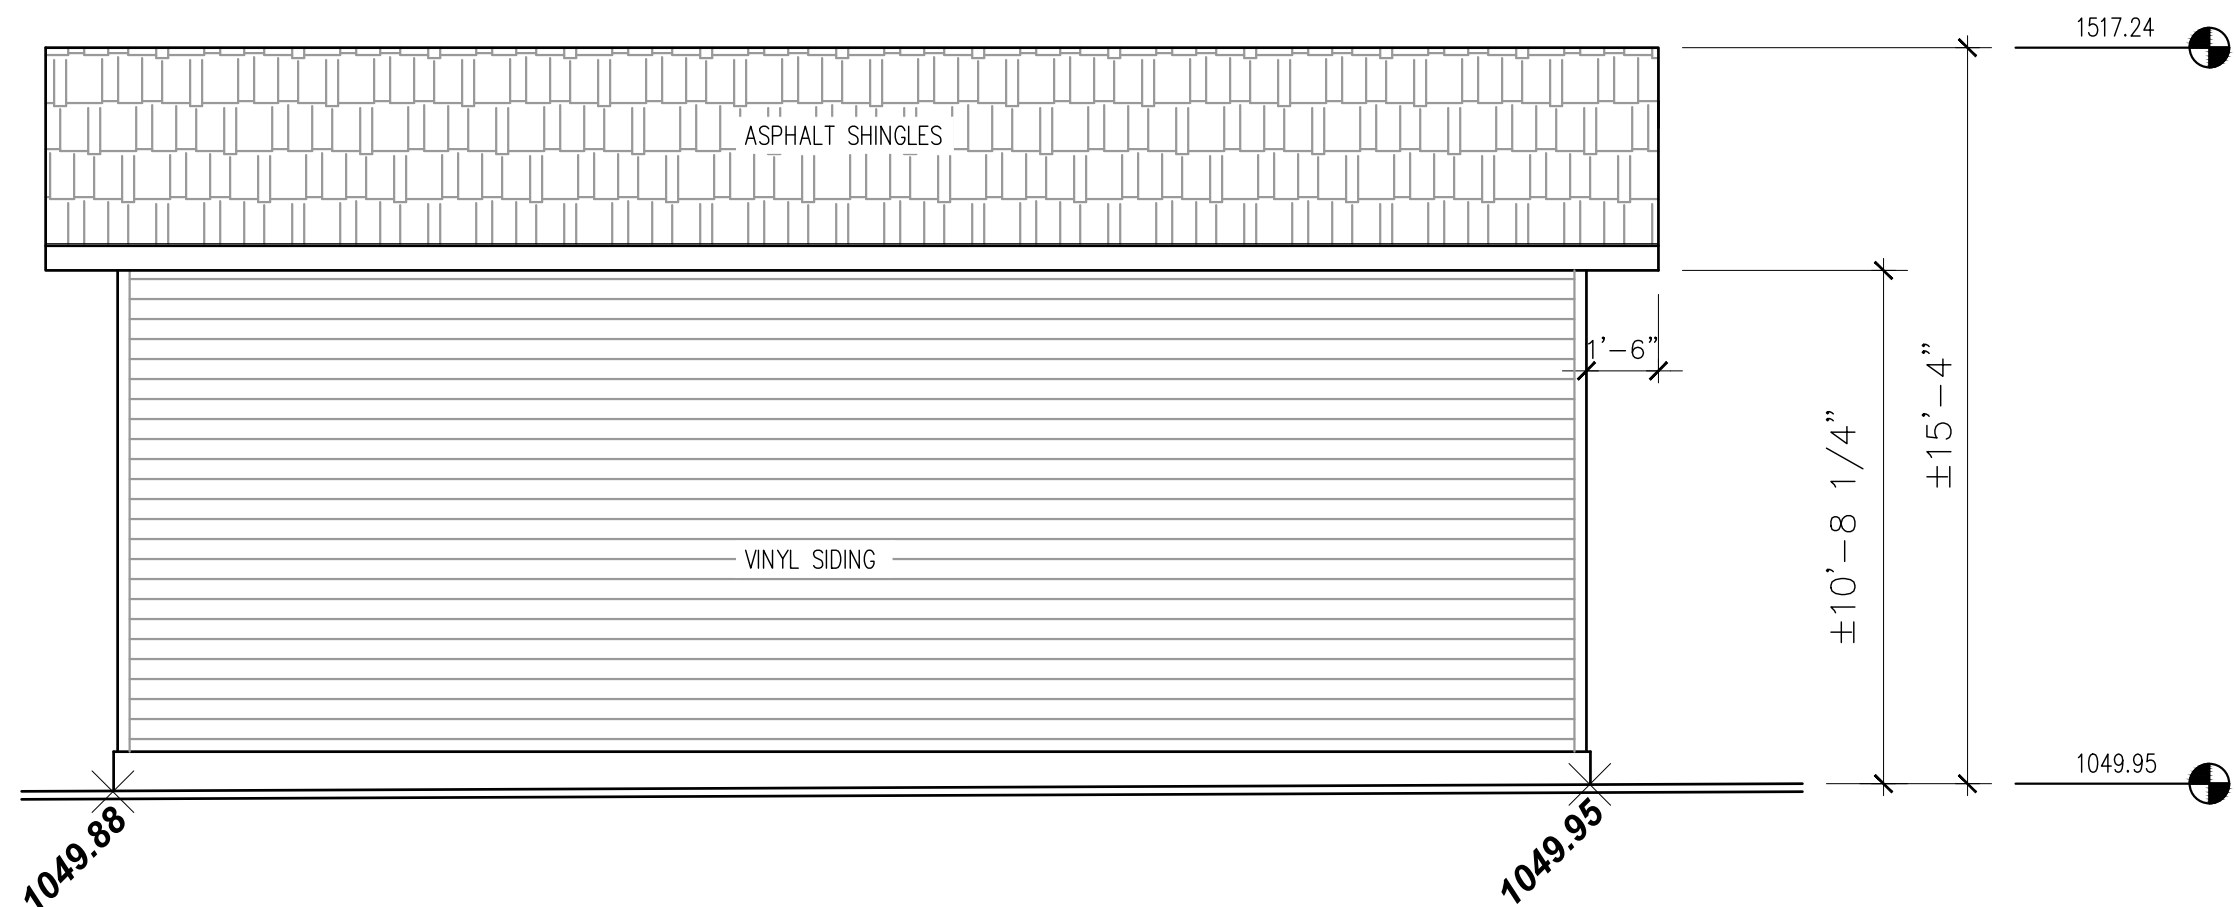

3  
A2.1 **SIDE ELEVATION**  
SCALE: 1/4" = 1'-0"

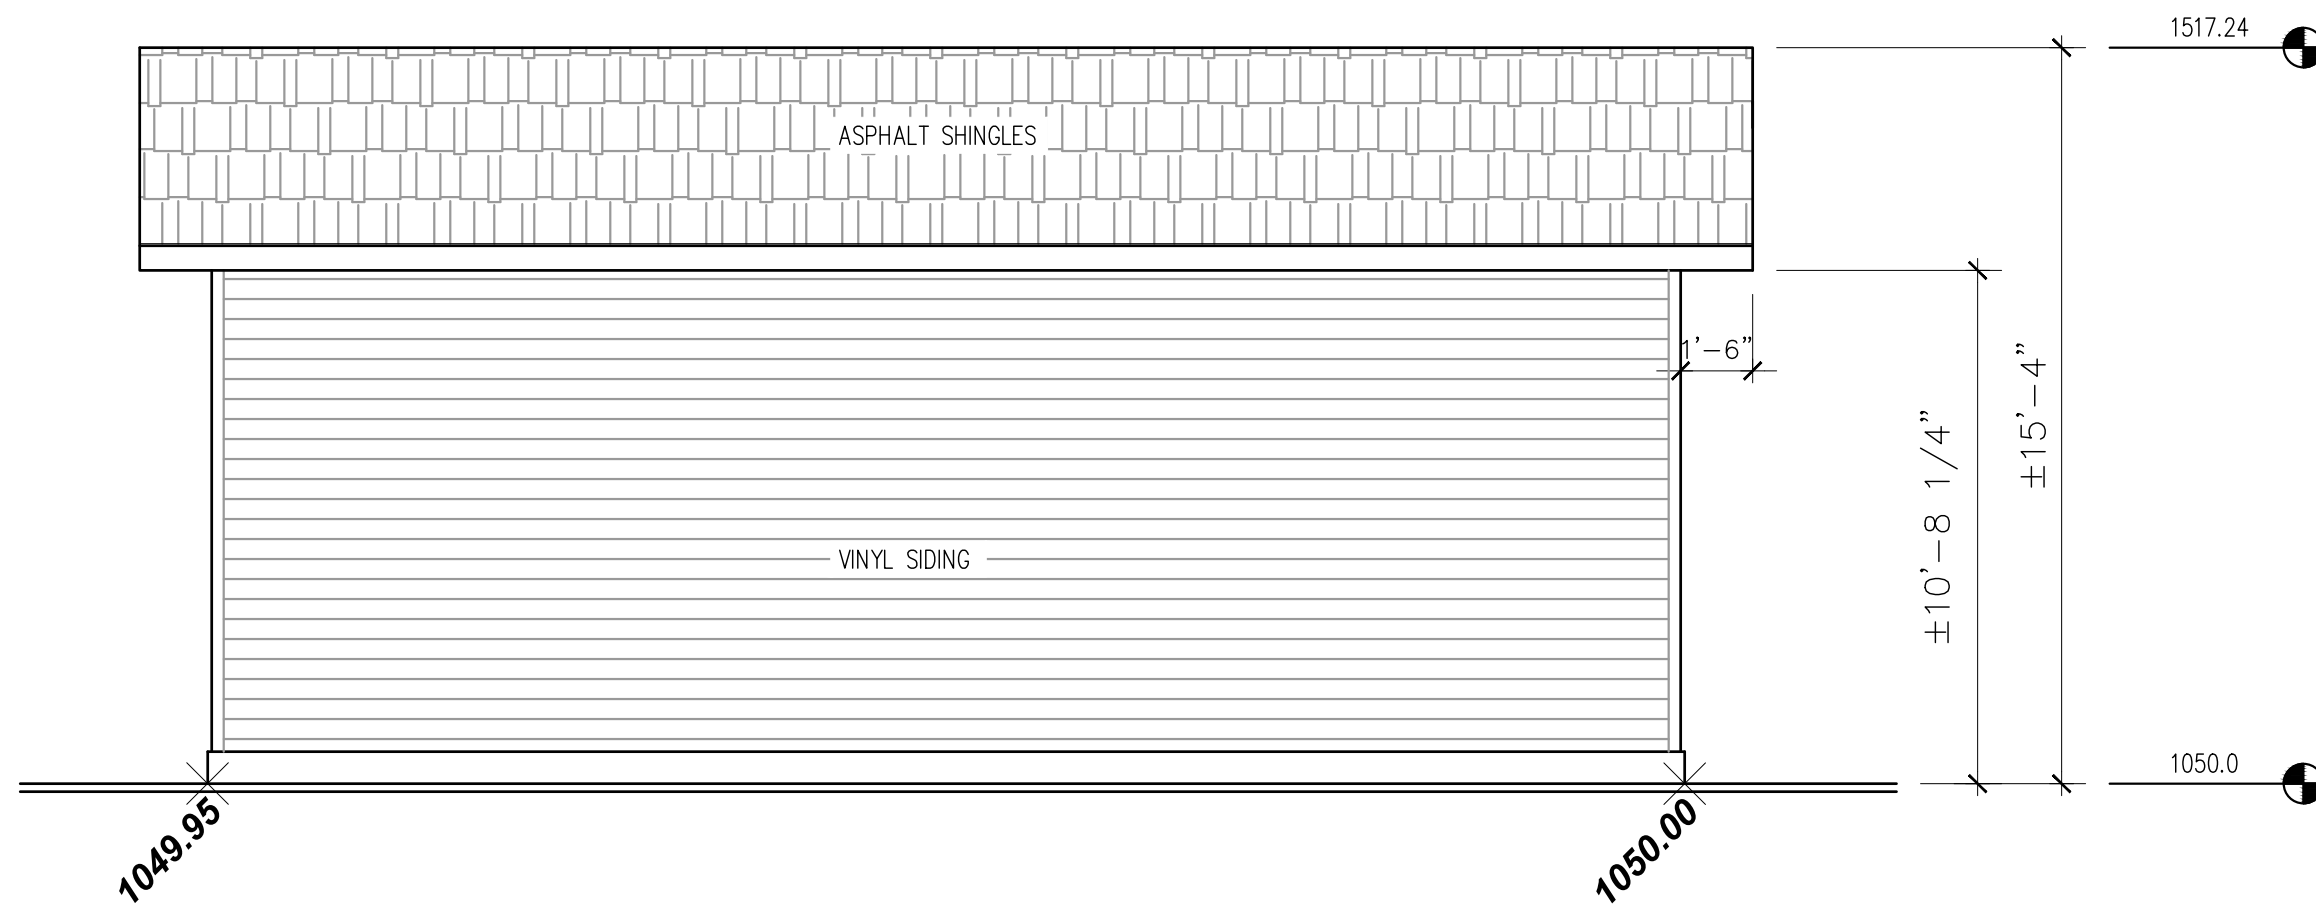

3  
2.1 **SIDE ELEVATION**  
SCALE: 1/4" = 1'-0"

ZAYNZ

SEAL

CONSULTANTS

GENERAL NOTES

|     |                |      |
|-----|----------------|------|
|     |                |      |
|     |                |      |
| NO. | REVISION/ISSUE | DATE |

PROJECT NAME  
**AS BUILT ADDITION  
MANTEI BUILDING**

PROJECT ADDRESS  
**5935 6 STREET NE  
CALGARY, AB**

SHEET TITLE  
**EXISTING QUONSET ELEVATIONS**

DESIGNED BY  
CHECKED BY

|                         |              |
|-------------------------|--------------|
| PROJECT NUMBER          | SHEET NUMBER |
| ISSUE DATE<br>7/17/2026 | <b>A2.2</b>  |
| SCALE<br>As Noted       |              |



SEAL

CONSULTANTS

GENERAL NOTES

|     |                |      |
|-----|----------------|------|
|     |                |      |
|     |                |      |
| NO. | REVISION/ISSUE | DATE |


PROJECT NAME  
**AS BUILT ADDITION  
MANTEI BUILDING**

PROJECT ADDRESS  
**5935 6 STREET NE  
CALGARY, AB**


SHEET TITLE  
**EXISTING QUONSET ELEVATIONS**

DESIGNED BY  
CHECKED BY

|                         |              |
|-------------------------|--------------|
| PROJECT NUMBER          | SHEET NUMBER |
| ISSUE DATE<br>7/17/2026 | <b>A2.2</b>  |
| SCALE<br>As Noted       |              |

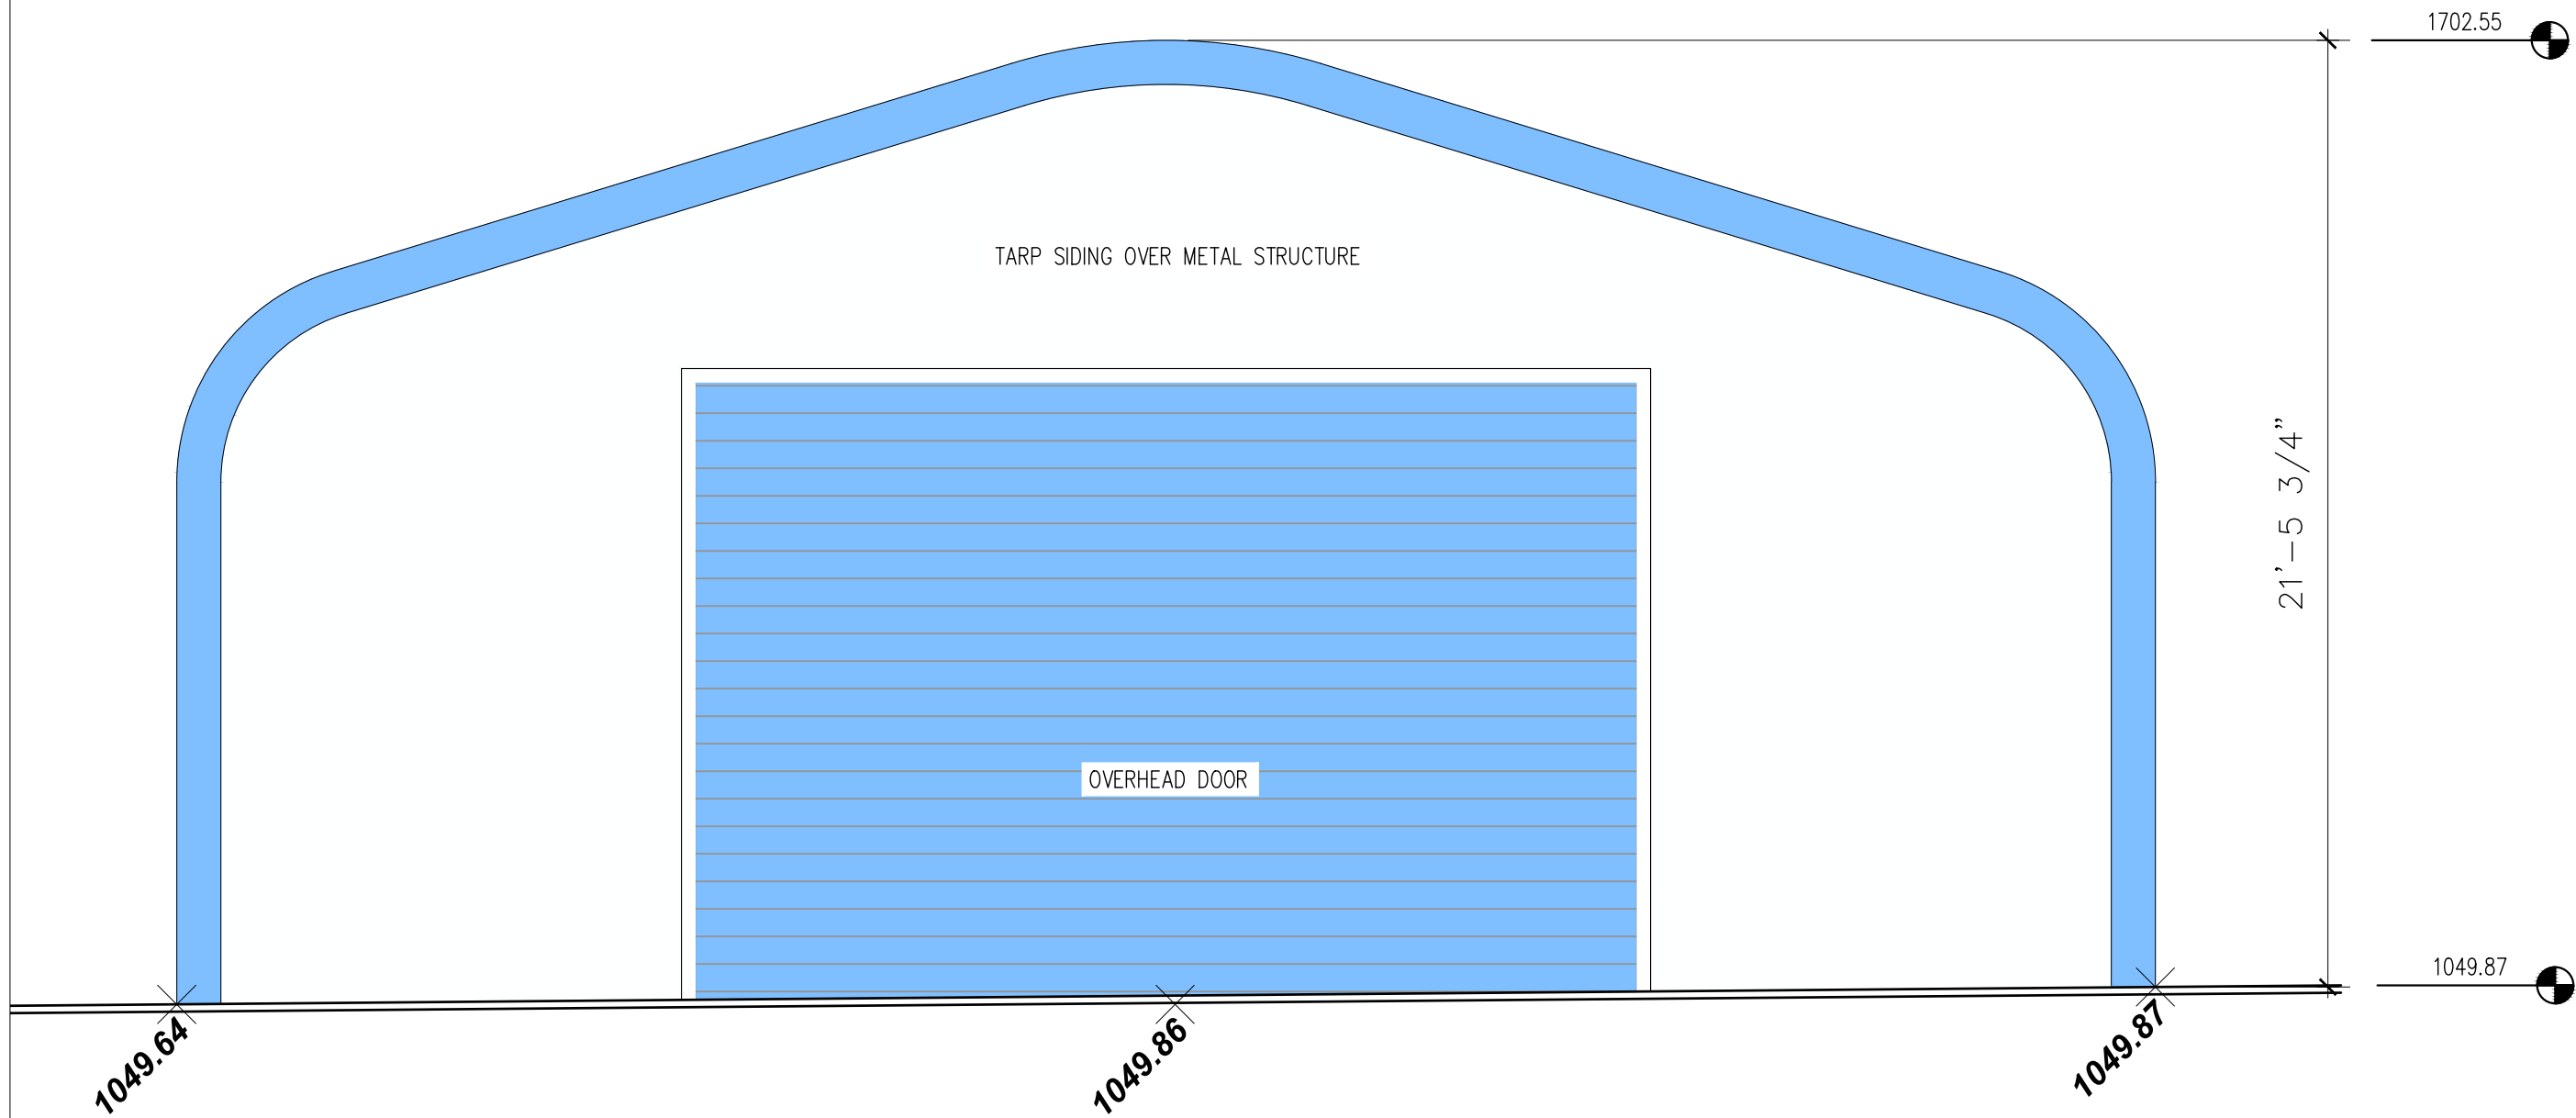

1  
A2.2 **FRONT ELEVATION**  
SCALE: 1/4" = 1'-0"

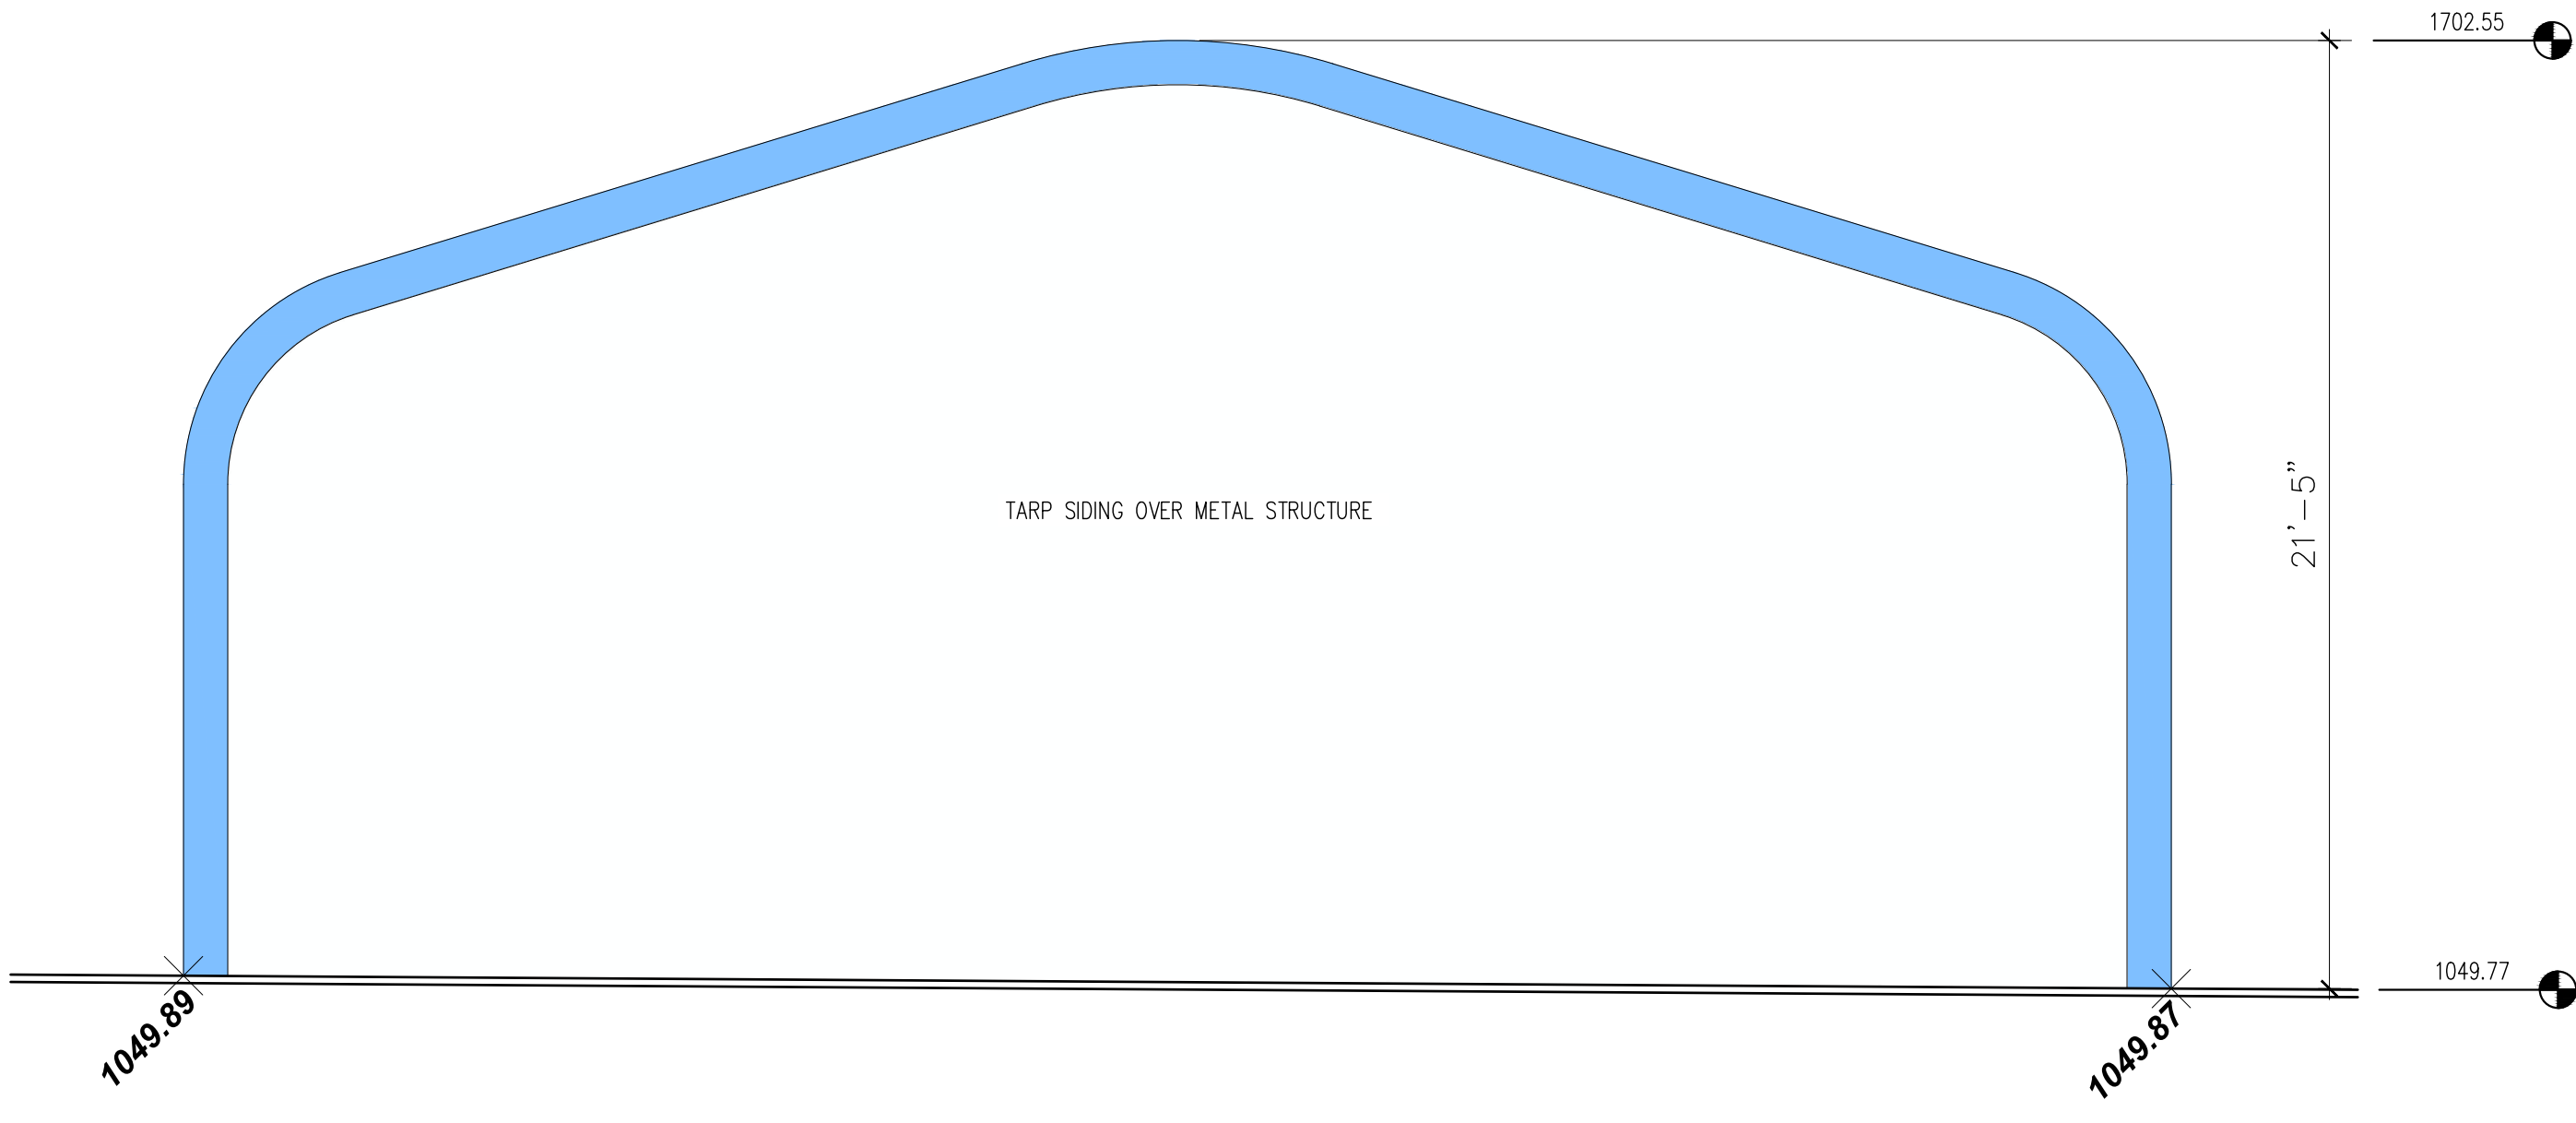

1  
A2.2 **REAR ELEVATION**  
SCALE: 1/4" = 1'-0"



3  
A2.2 **SIDE ELEVATION**  
SCALE: 1/4" = 1'-0"