

# 1112 8 STREET SE

## ARCHITECTURAL

| Layout Page Table |                        |                                                    |            |
|-------------------|------------------------|----------------------------------------------------|------------|
| Label             | Title                  | Description                                        | Scale      |
| A1                | COVER                  |                                                    | NONE       |
| A2                | PLOT PLAN              |                                                    | 1/8" = 1'  |
| A3                | DEMOLITION             |                                                    | 5/16" = 1' |
| A4                | BASEMENT FLOOR PLAN    |                                                    | 5/16" = 1' |
| A5                | MAIN FLOOR PLAN        |                                                    | 5/16" = 1' |
| A6                | 2ND FLOOR PLAN         |                                                    | 5/16" = 1' |
| A7                | MAIN FLOOR ROOF        |                                                    | 5/16" = 1' |
| A8                | 2ND FLOOR ROOF         |                                                    | 5/16" = 1' |
| A9                | NORTH ELEVATION        | Spacial Calculations                               | 3/16" = 1' |
| A10               | SOUTH ELEVATION        | Spacial Calculations, ENMAX Safe Work Zone         | 3/16" = 1' |
| A11               | ELEVATION              | Roof Type, Roof Slopes, Siding Type, Spacial Calcs | 5/16" = 1' |
| A12               | Cross Section 1 & 2    |                                                    | 5/16" = 1' |
| A13               | Cross Section          |                                                    | 5/16" = 1' |
| A14               | Cross Section          | RSI Markup                                         | 3/16" = 1' |
| A15               | CROSS SECTION          |                                                    | 3/16" = 1' |
| A16               | DOOR & WINDOW SCHEDULE |                                                    | NTS        |
| A17               | Typical Sections       | Framing, Insulation, Vapor Details                 | 1" = 1'    |
| A18               | Typical Sections       | Framing, Insulation, Vapor Details                 | 1" = 1'    |

| REVISION TABLE |      |
|----------------|------|
| NUMBER         | DATE |
|                |      |
|                |      |
1112 8 Street SE,  
Calgary, T2G 2Z7

Title:  
COVER

DATE:

7/19/2026

SCALE:

NONE


SHEET:

A1

8 STREET SE

11 AVENUE SE

GRAVEL  
LANE

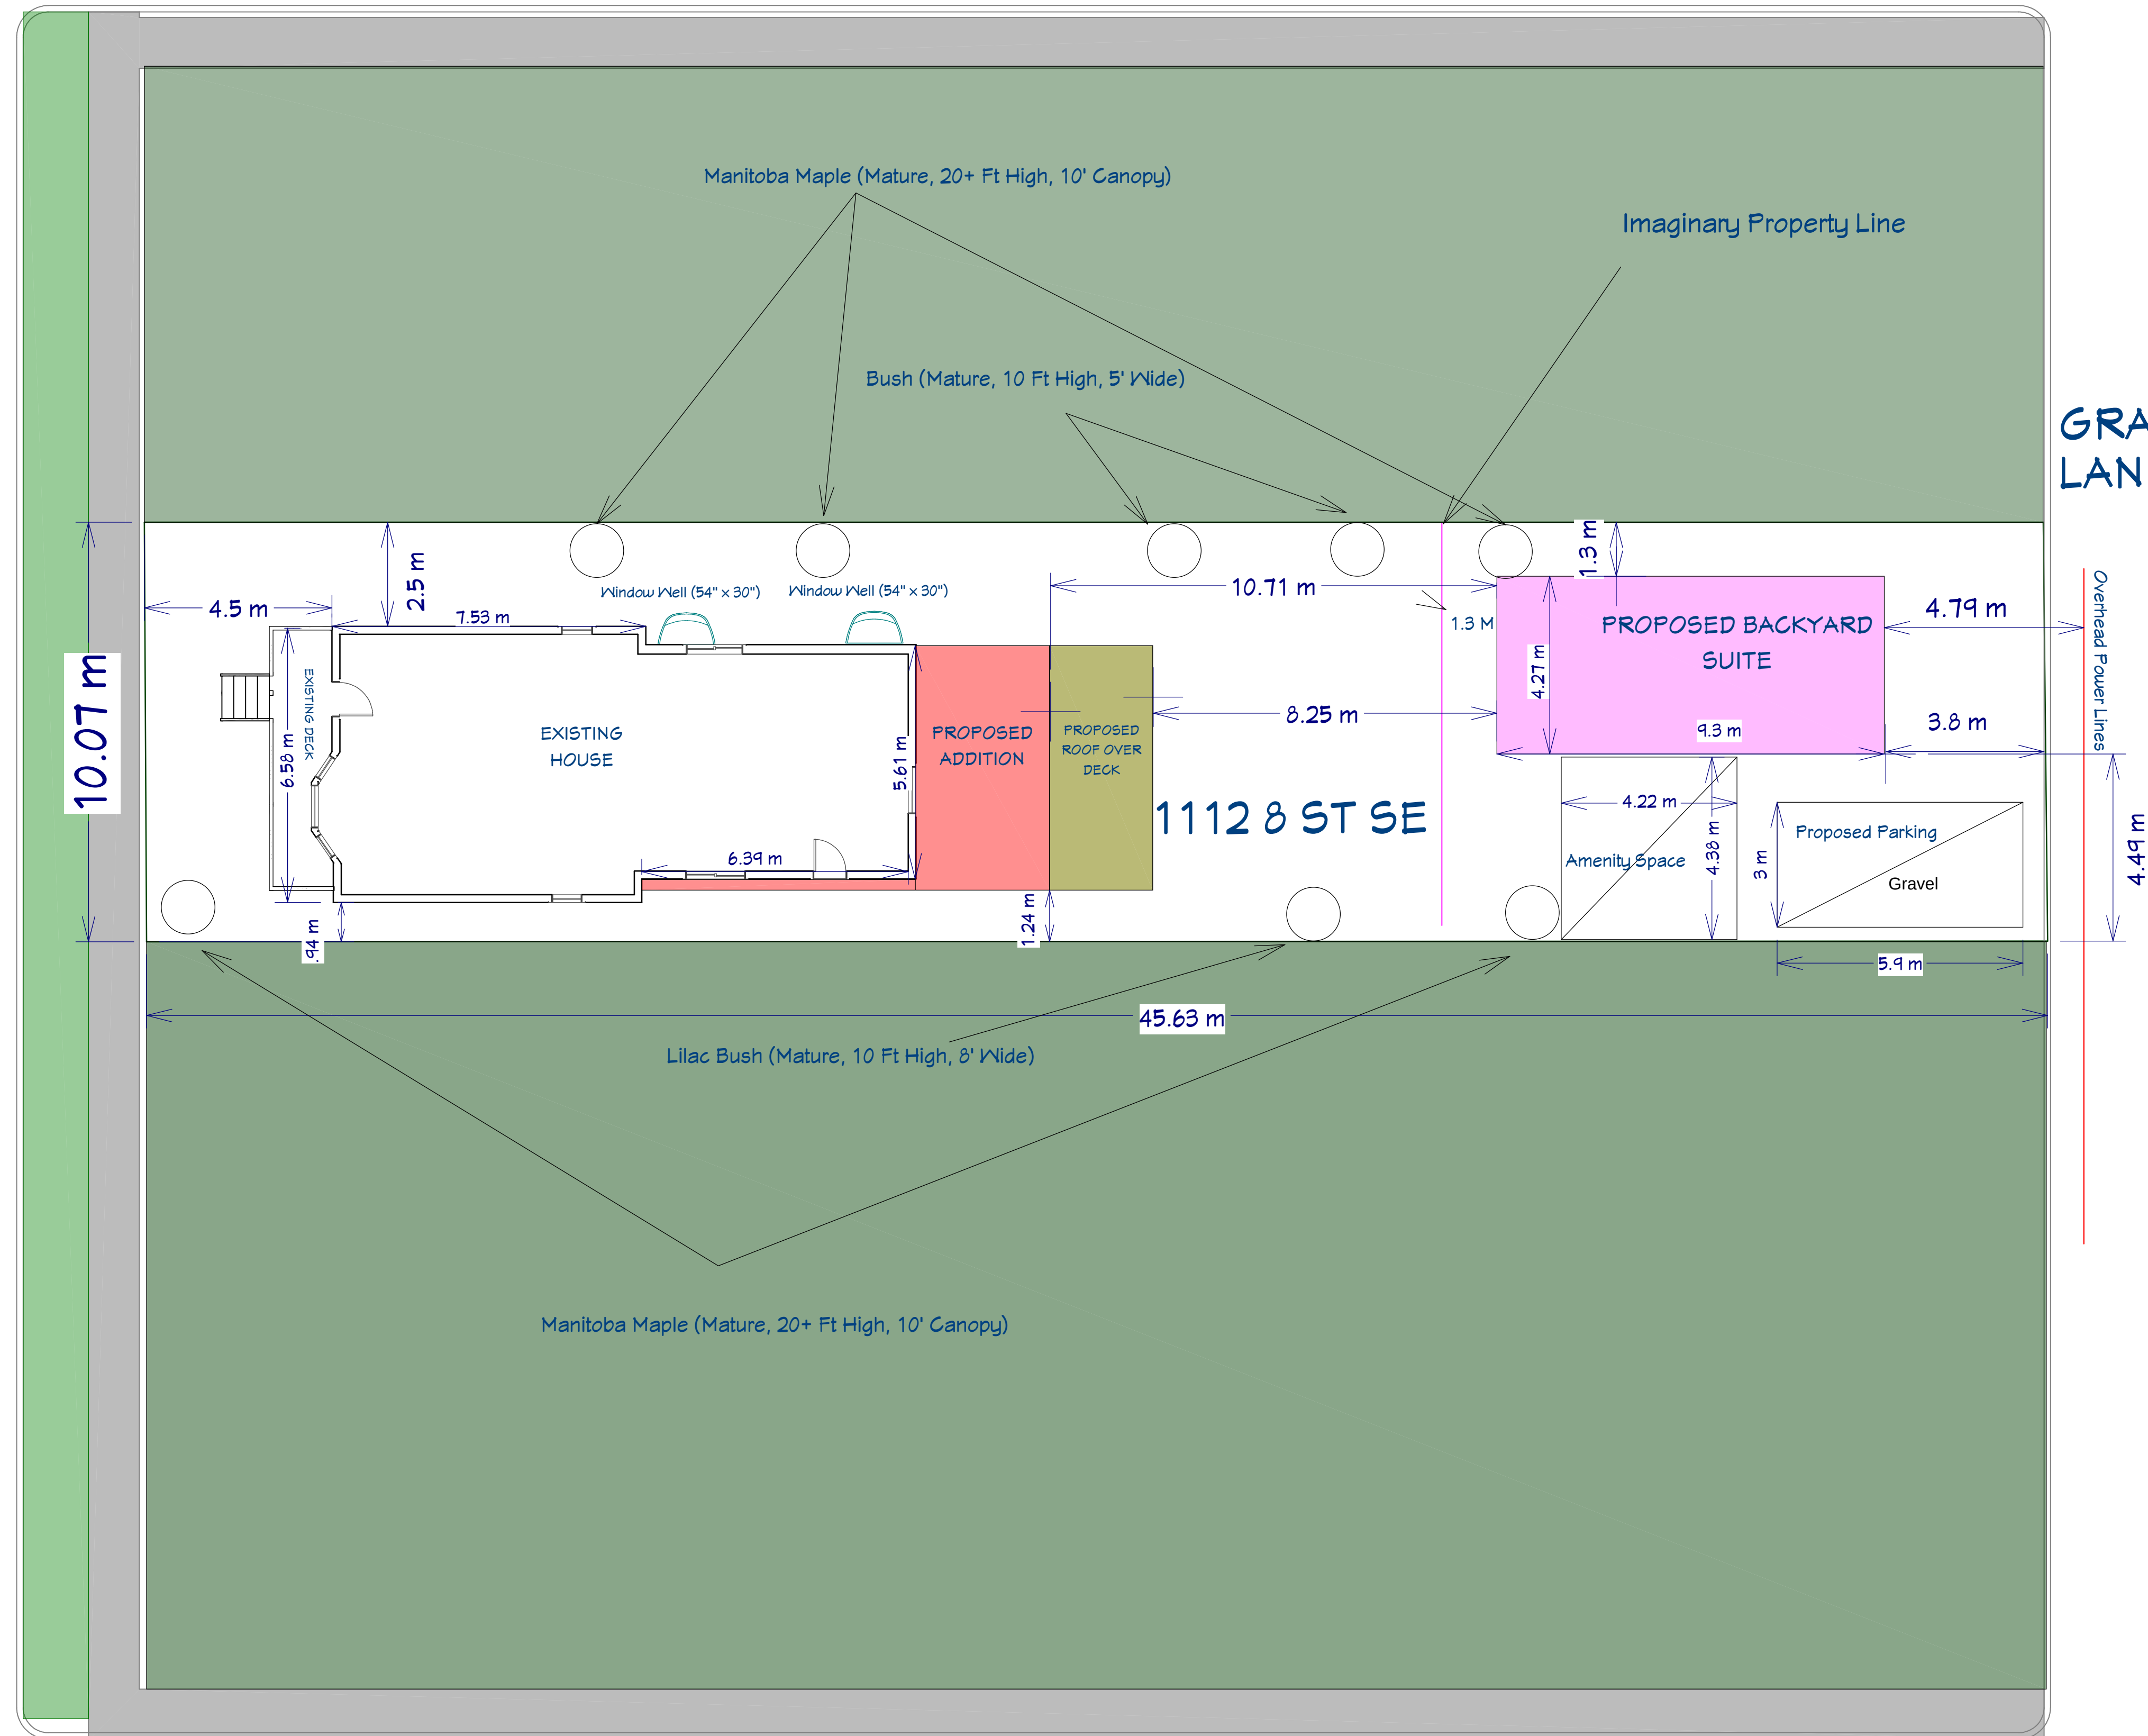

1112 8 ST SE

| REVISION TABLE                             |           |
|--------------------------------------------|-----------|
| NUMBER                                     | DATE      |
| 1                                          | 6/14/2026 |
| DESCRIPTION                                |           |
| REMOVED EXTERIOR STAIRS, ADDED WINDOW WELL |           |

1112 8 Street SE,  
Calgary, T2G 2Z7

PLOT PLAN

Title:

DATE:


7/19/2026

SCALE:

1/8" = 1'

SHEET:

A2

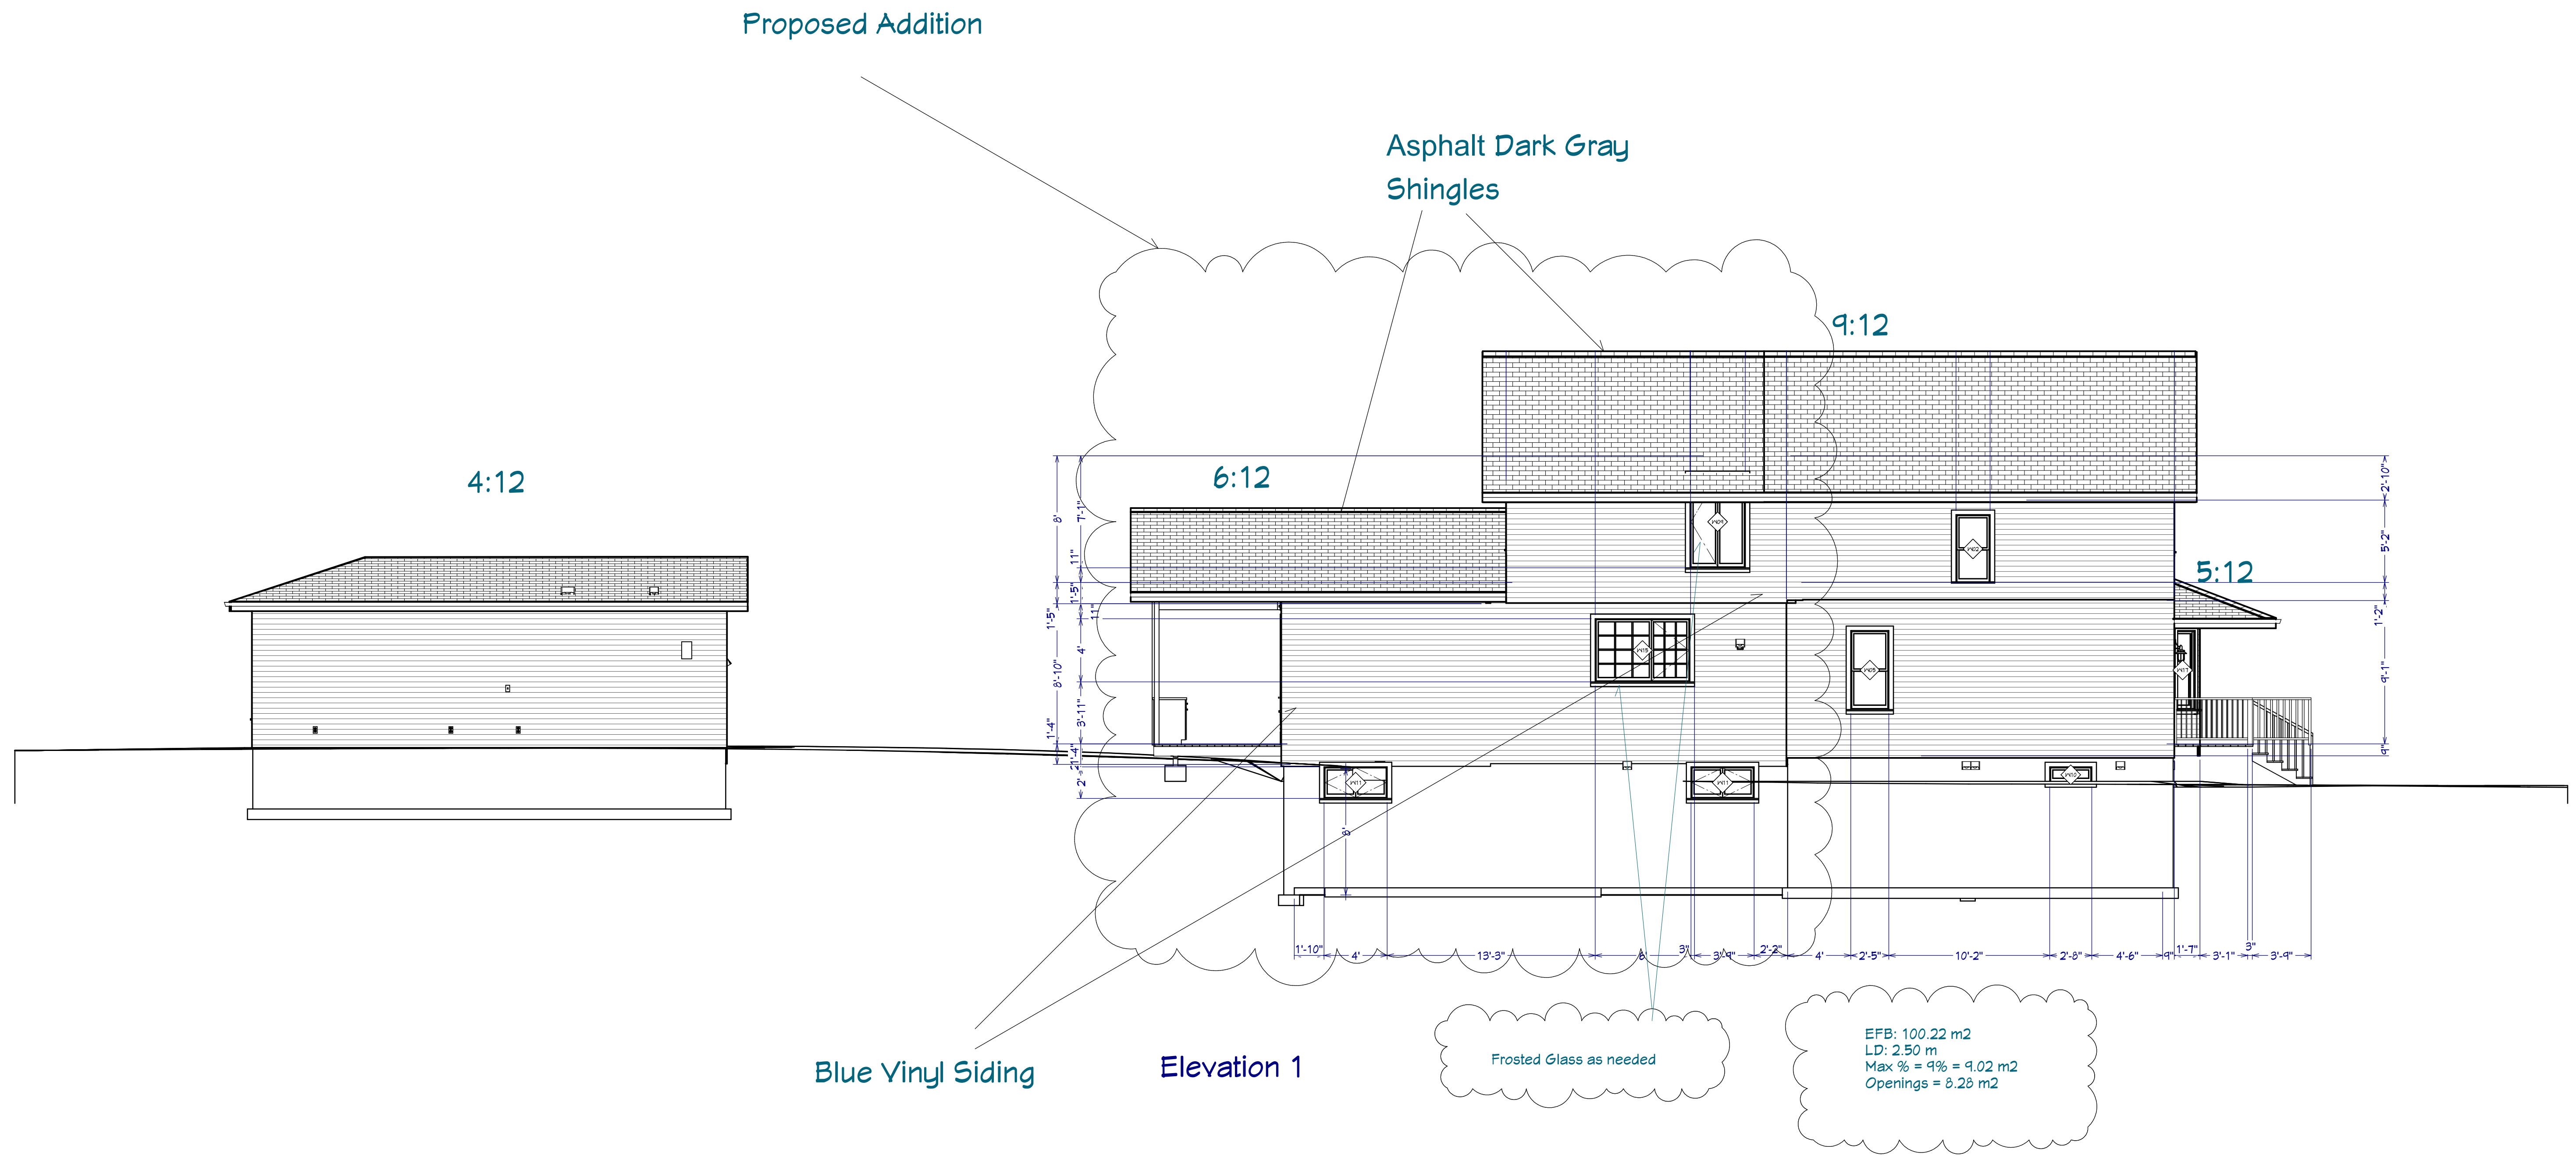

| NUMBER | DATE      | DESCRIPTION            |
|--------|-----------|------------------------|
| 1      | 6/17/2026 | REMOVED BACKYARD SUITE |
| 2      | 7/2/2026  | FROST GLASS ADDED      |
|        |           |                        |
|        |           |                        |
1112 8 Street SE,  
Calgary, T2G 2Z7

Title: NORTH ELEVATION

DATE:


7/19/2026

SCALE:

3/16" = 1'

SHEET:

A9

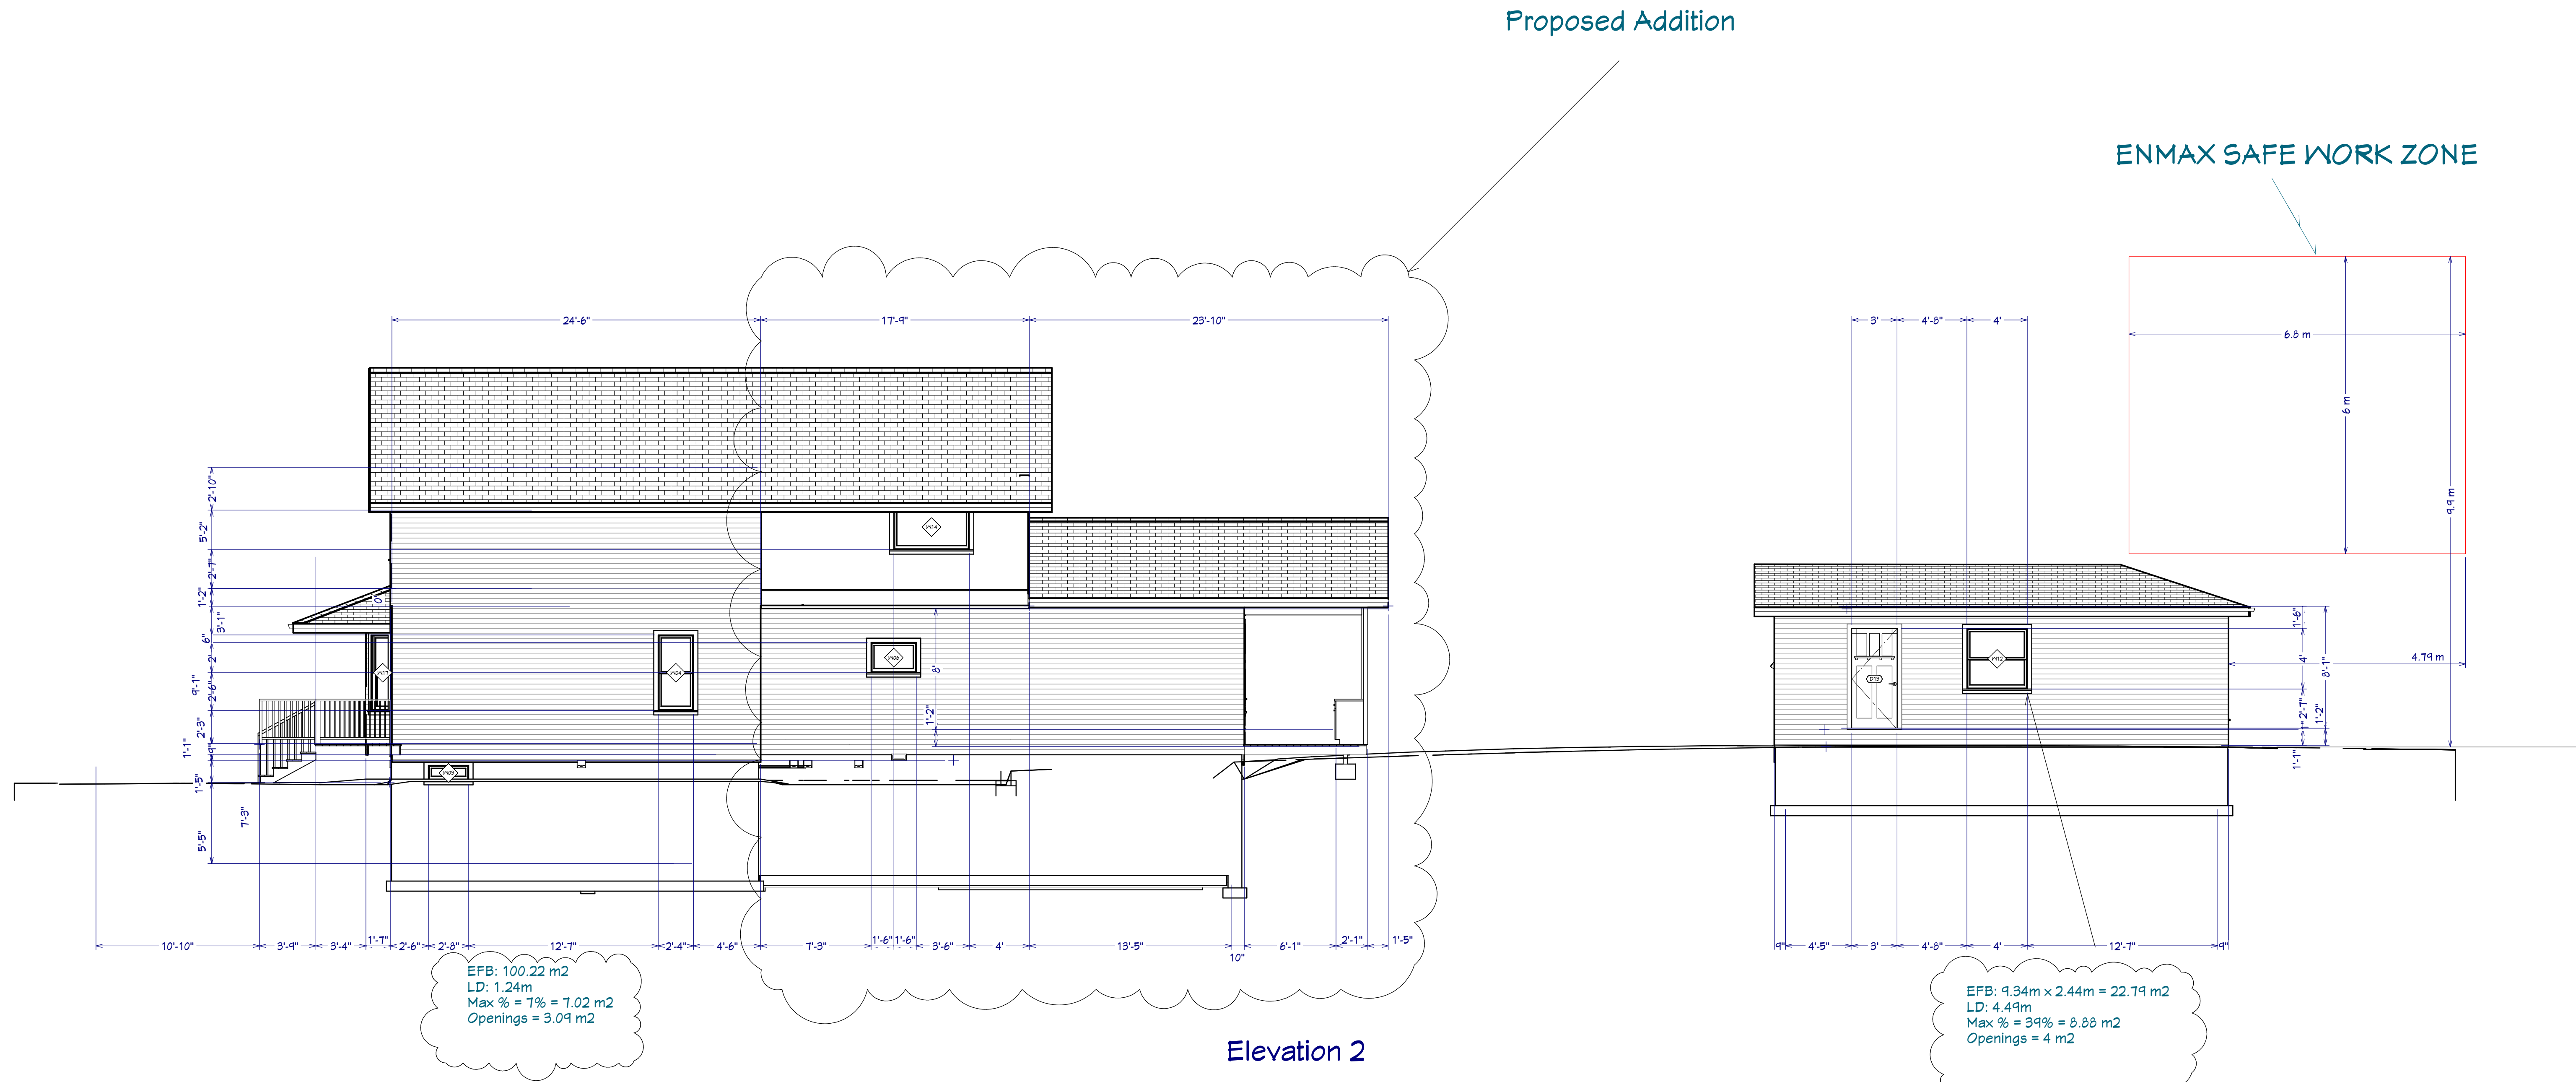

| REVISION TABLE         |           |
|------------------------|-----------|
| NUMBER                 | DATE      |
| 1                      | 6/17/2026 |
| DESCRIPTION            |           |
| REMOVED BACKYARD SUITE |           |
|                        |           |
|                        |           |
1112 8 Street SE,  
Calgary, T2G 2Z7

Title:  
SOUTH ELEVATION

DATE:


7/19/2026

SCALE:


3/16" = 1'

SHEET:

A10

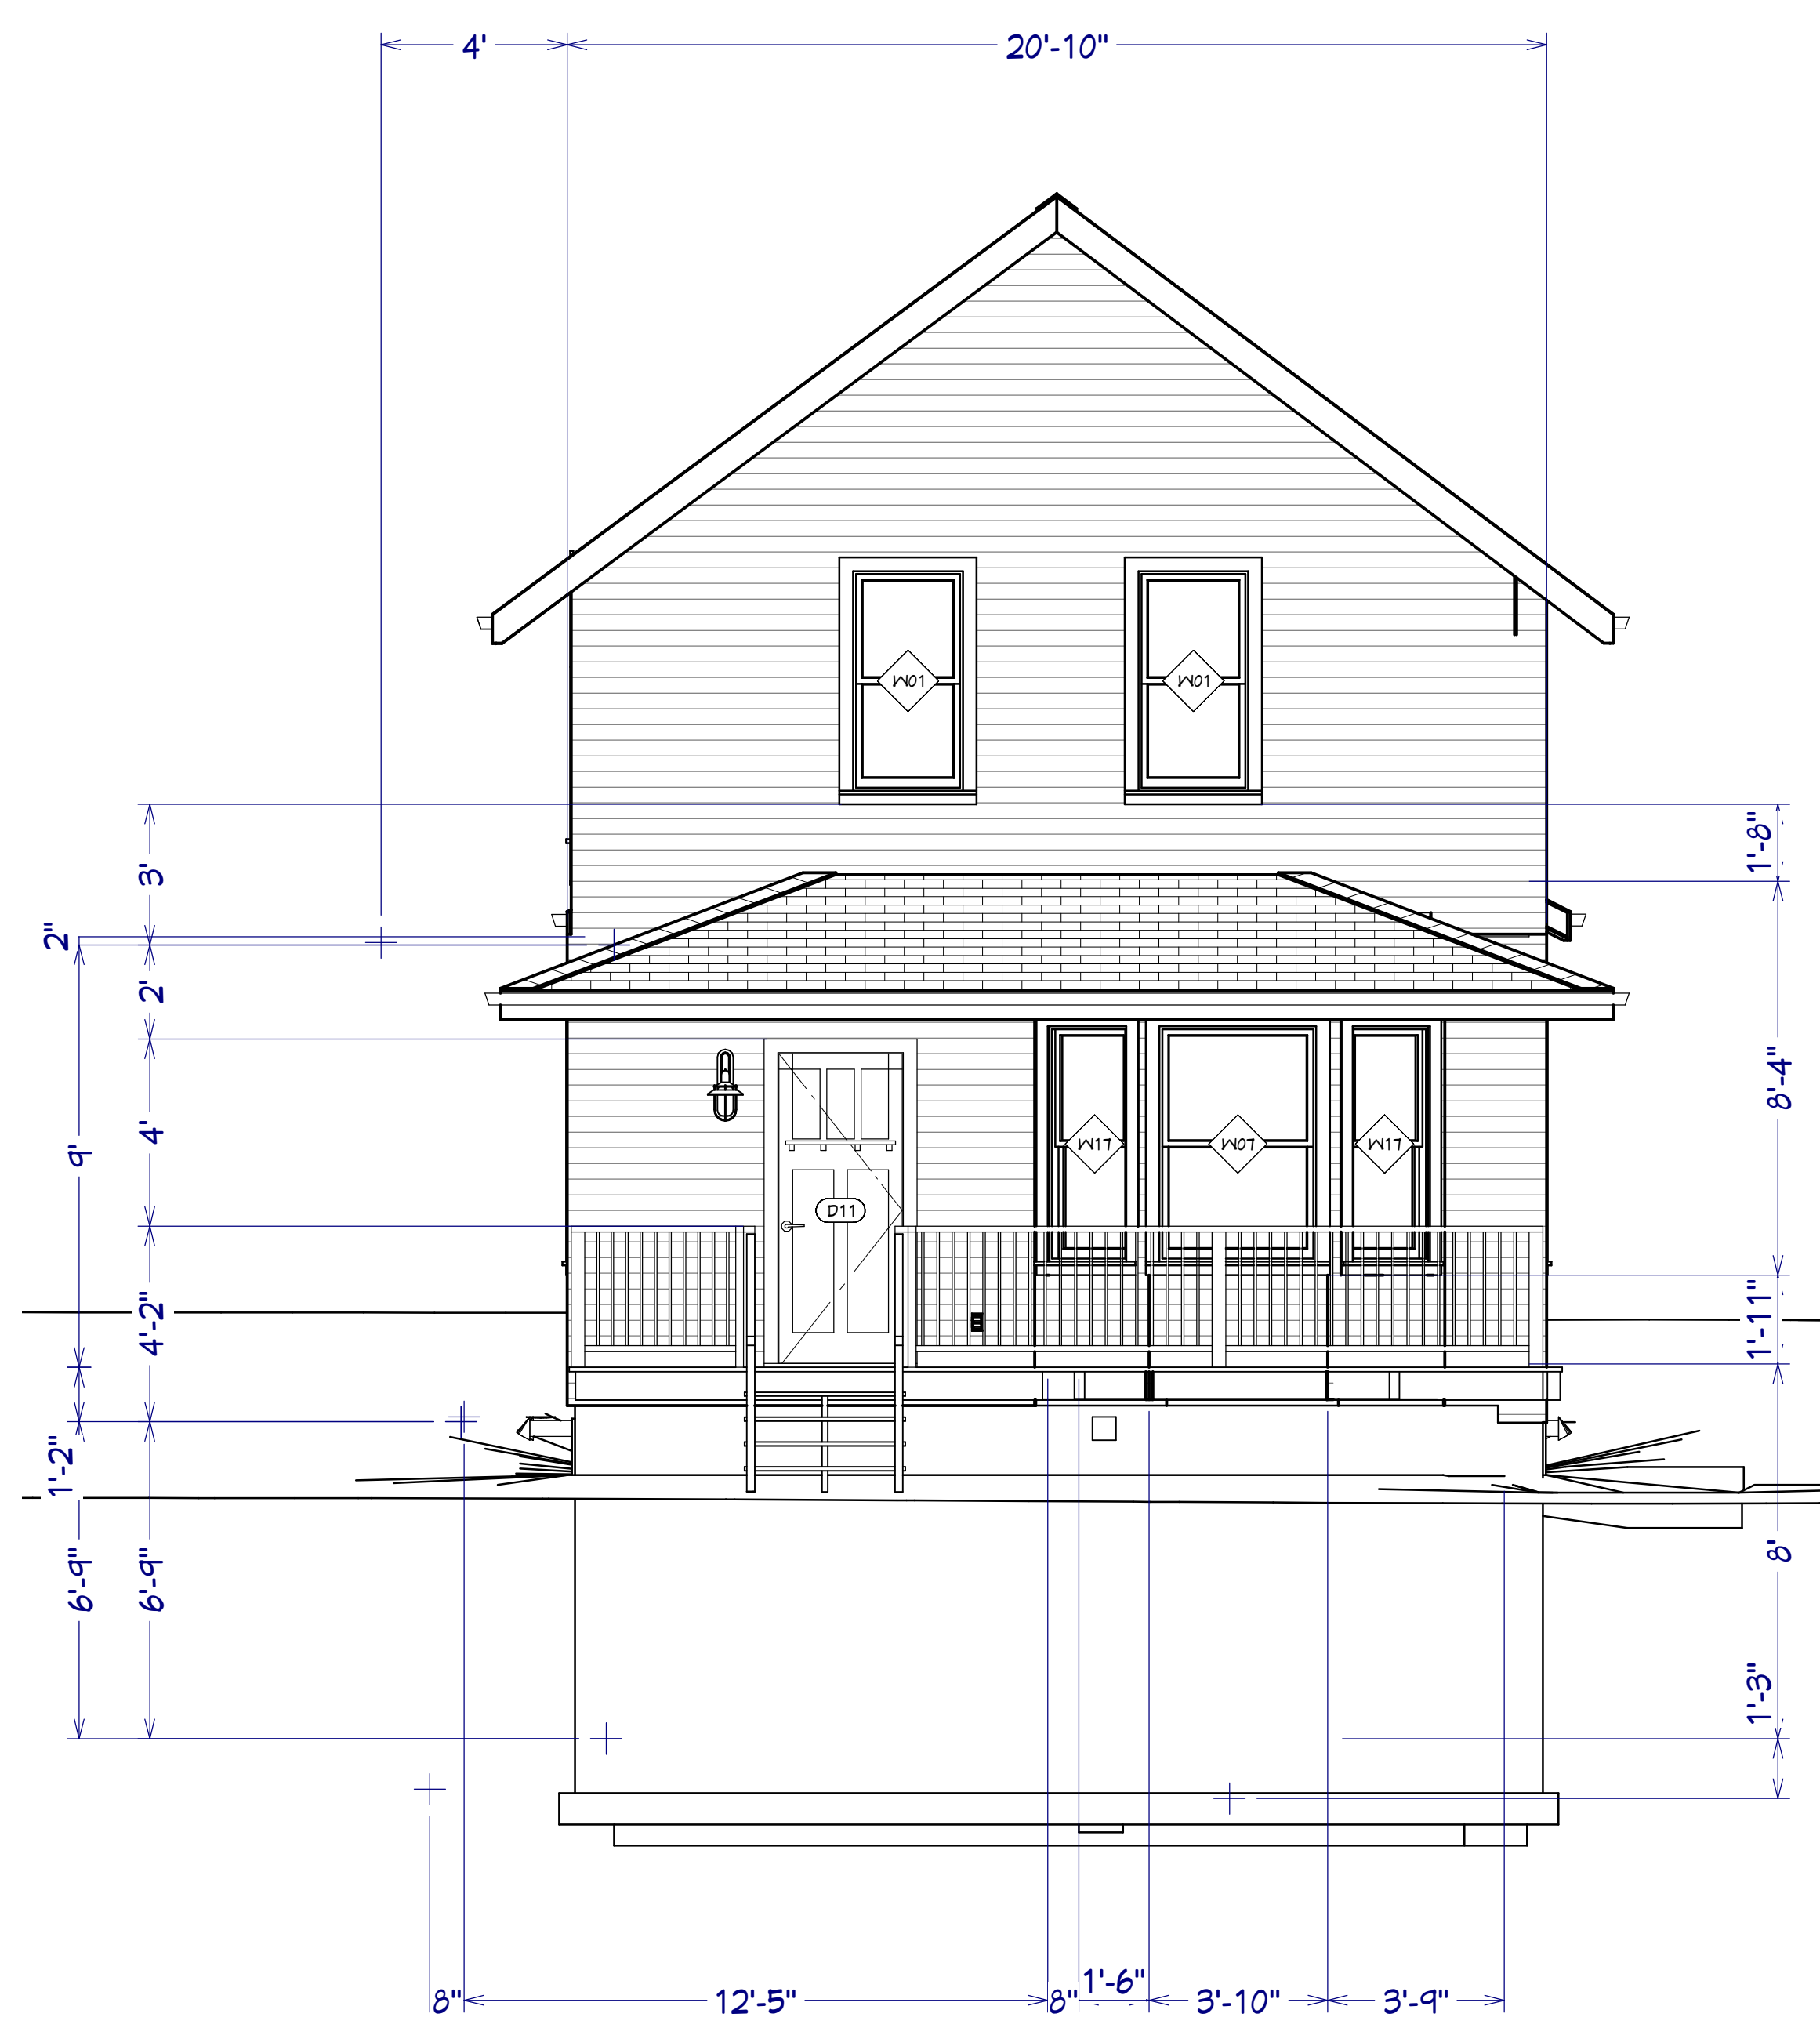

WEST

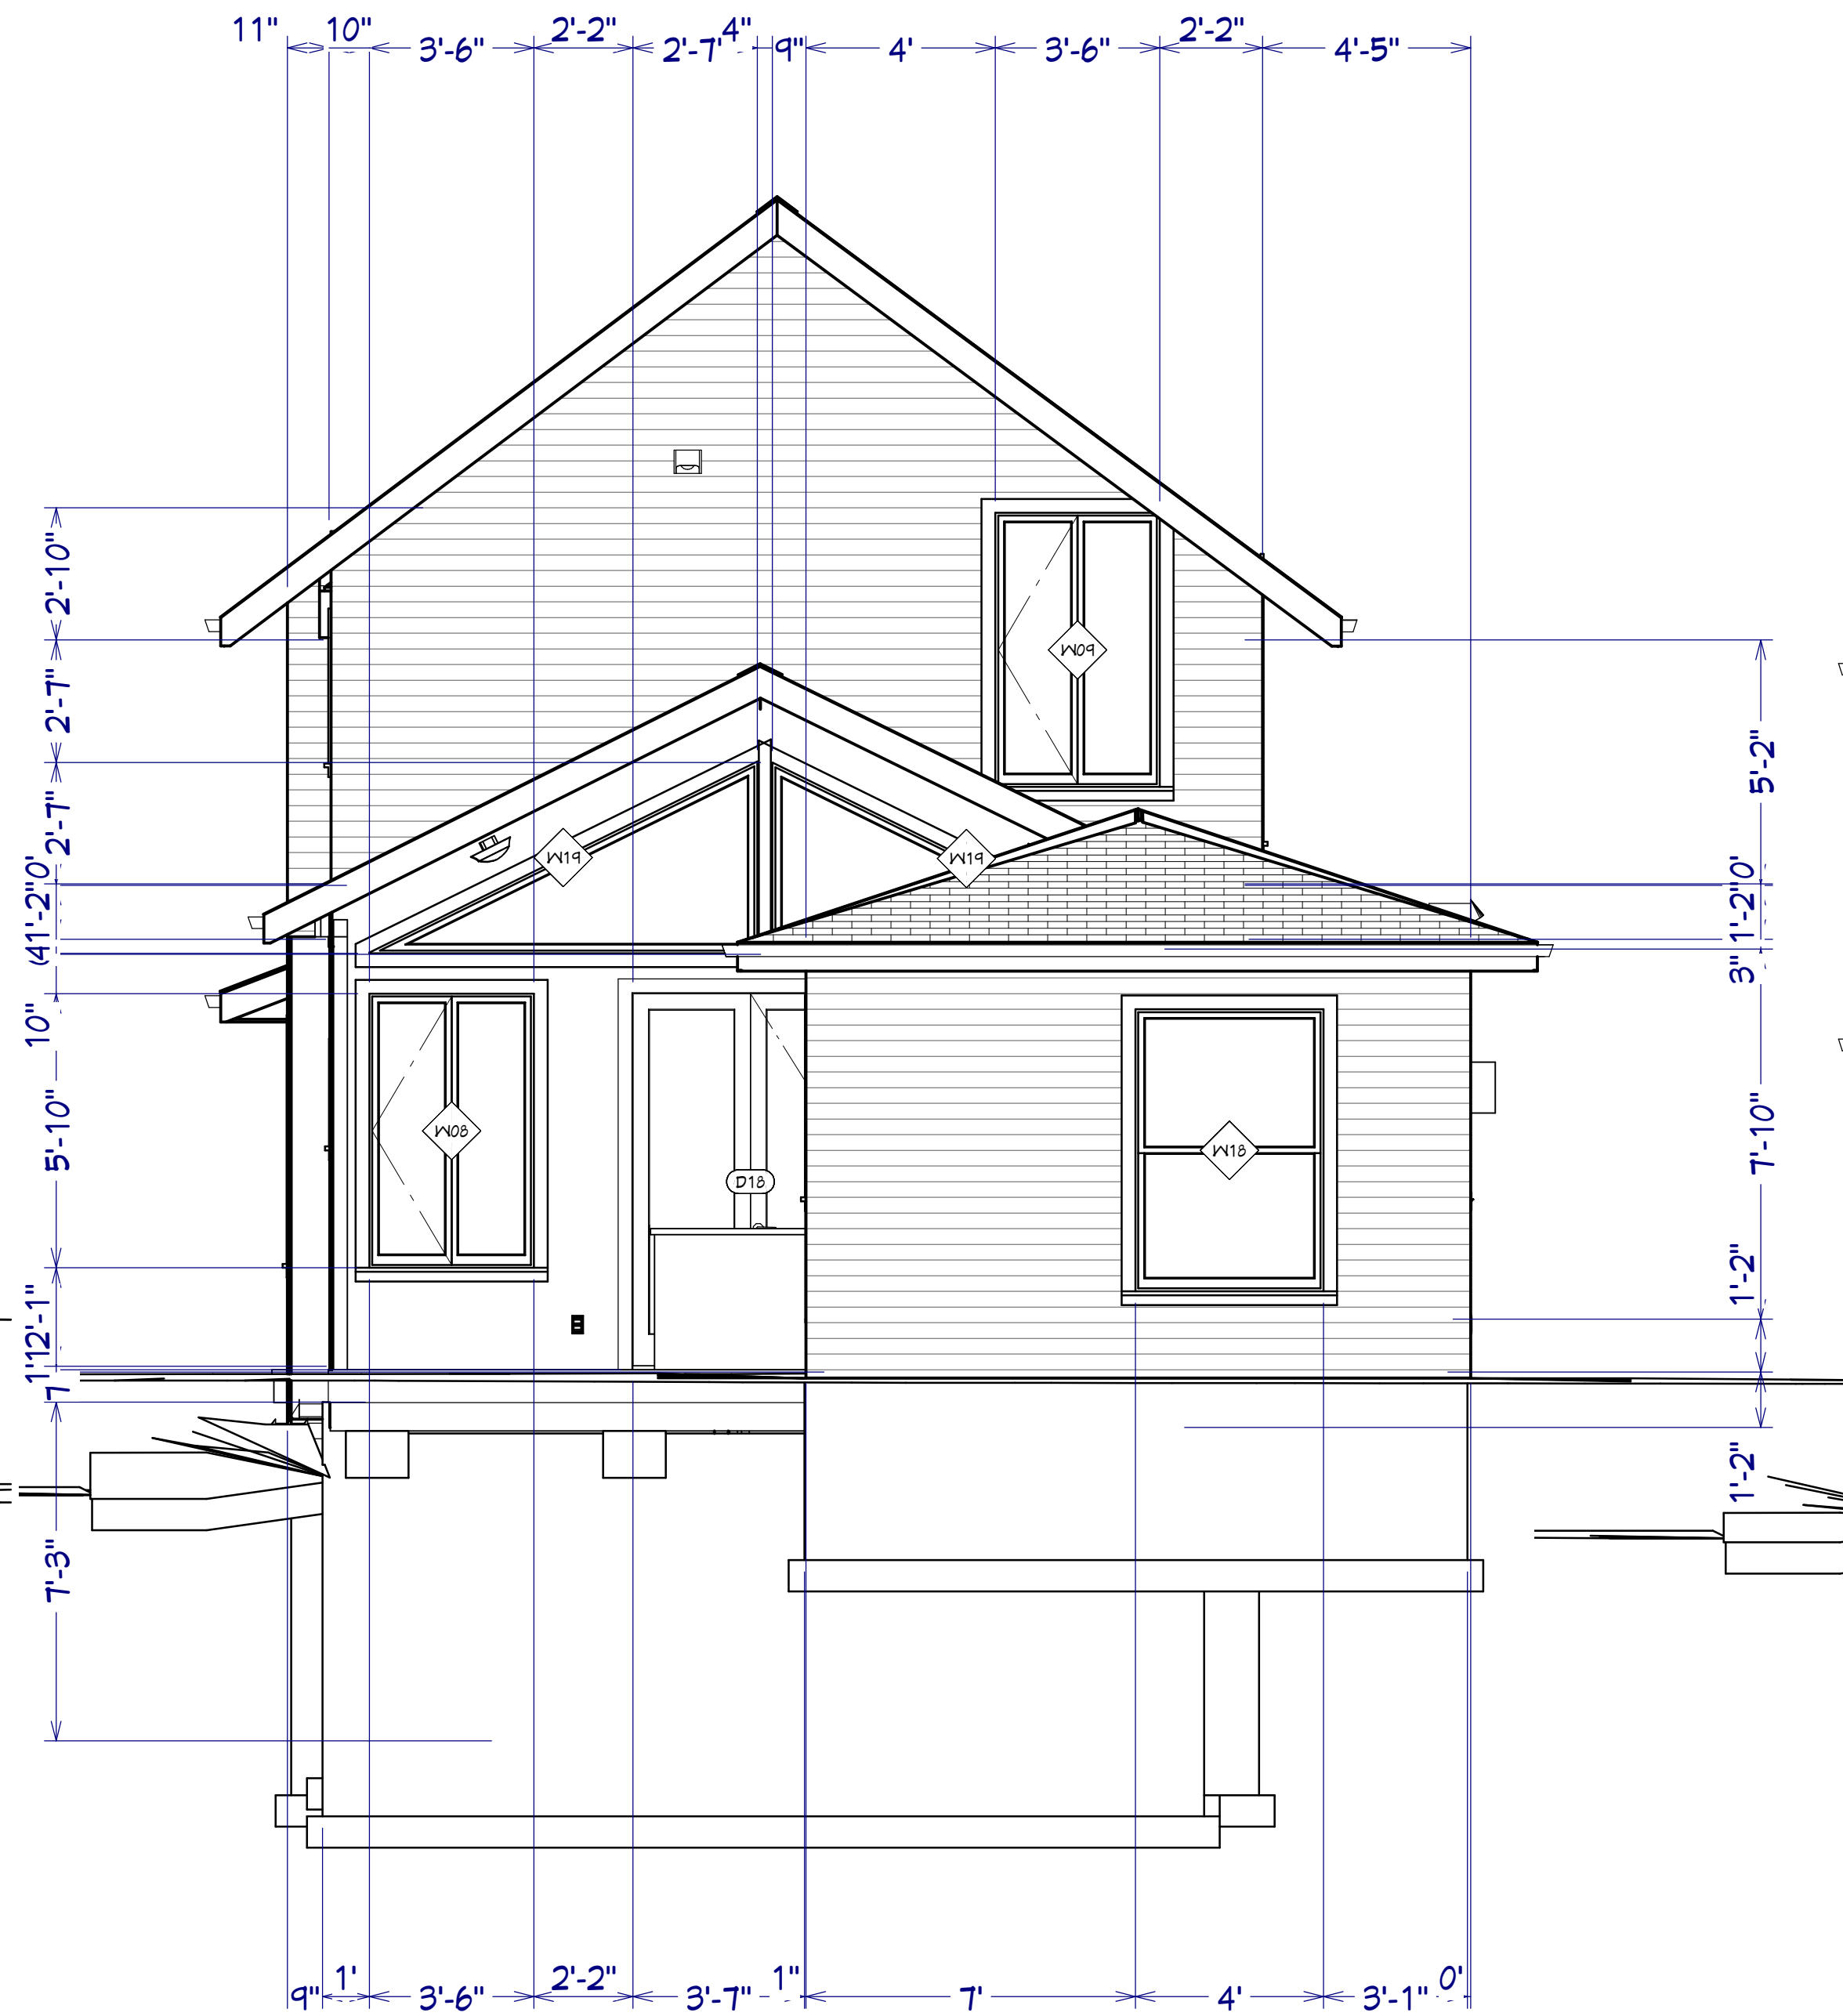

EAST ( BACKYARD SUITE)



EAST

EFB: 4.27m x 2.44m = 10.42 m2  
LD: 6.22 m  
Max % = 88% = 9.17 m2  
Openings = 2 m2

EFB: 5.89m x 2.44m = 14.37 m2  
EFB: 5.89m x 1.60m / 2 = 4.71 m2  
Total: 19.08 m2  
LD: 6.95m  
Max % = 88% : 16.07 m2  
Openings = 10 m2

| REVISION TABLE |      |
|----------------|------|
| NUMBER         | DATE |
|                |      |
|                |      |
1112 8 Street SE,  
Calgary, T2G 2Z7

ELEVATION

Title:

DATE:

7/19/2026

SCALE:

5/16" = 1'

SHEET:

A11