

Notes
COPYRIGHT RESERVED. THIS PLAN AND DESIGN IS AND AT ALL TIMES REMAINS THE EXCLUSIVE PROPERTY OF VISTA DRAFTING & CONSULTING INC. AND CANNOT BE USED WITHOUT WRITTEN CONSENT.

DO NOT SCALE THIS DRAWING
THE CONSTRUCTOR SHALL VERIFY AND BE RESPONSIBLE FOR ALL DIMENSIONS.
ANY ERRORS OR OMISSIONS SHALL BE REPORTED TO VISTA DRAFTING & CONSULTING INC. WITHOUT DELAY.



SUBJECT SITE FIRE FIGHTING ACCESS PUBLIC PARKING AREA

**ISSUED ON
JUN 16, 2026
FOR DP
(EXTERIOR)**

PLAN A1
BLOCK 107
LOT 24-28

Revisions		
No.	Description	Date
0	ISSUED FOR DP (EXTERIOR)	JUN 16, 26

Project
**GOGI KOREAN BBQ
17 AVE**

508 17 AVE SW, CALGARY AB

Drawing Title
SITE MAP

Drawn By:	M. T.	Date:	JUN 2026
Designed By:	A. N.	Scale:	As Shown
Job Number			
Drawing Number	A - 0.1		
Rev. No.	0		


SITE MAP
SCALE: N.T.S.




NORTH

Notes
COPYRIGHT RESERVED. THIS PLAN AND DESIGN IS AND AT ALL TIMES REMAINS THE EXCLUSIVE PROPERTY OF VISTA DRAFTING & CONSULTING INC. AND CANNOT BE USED WITHOUT WRITTEN CONSENT.

DO NOT SCALE THIS DRAWING
THE CONSTRUCTOR SHALL VERIFY AND BE RESPONSIBLE FOR ALL DIMENSIONS.
ANY ERRORS OR OMISSIONS SHALL BE REPORTED TO VISTA DRAFTING & CONSULTING INC. WITHOUT DELAY.

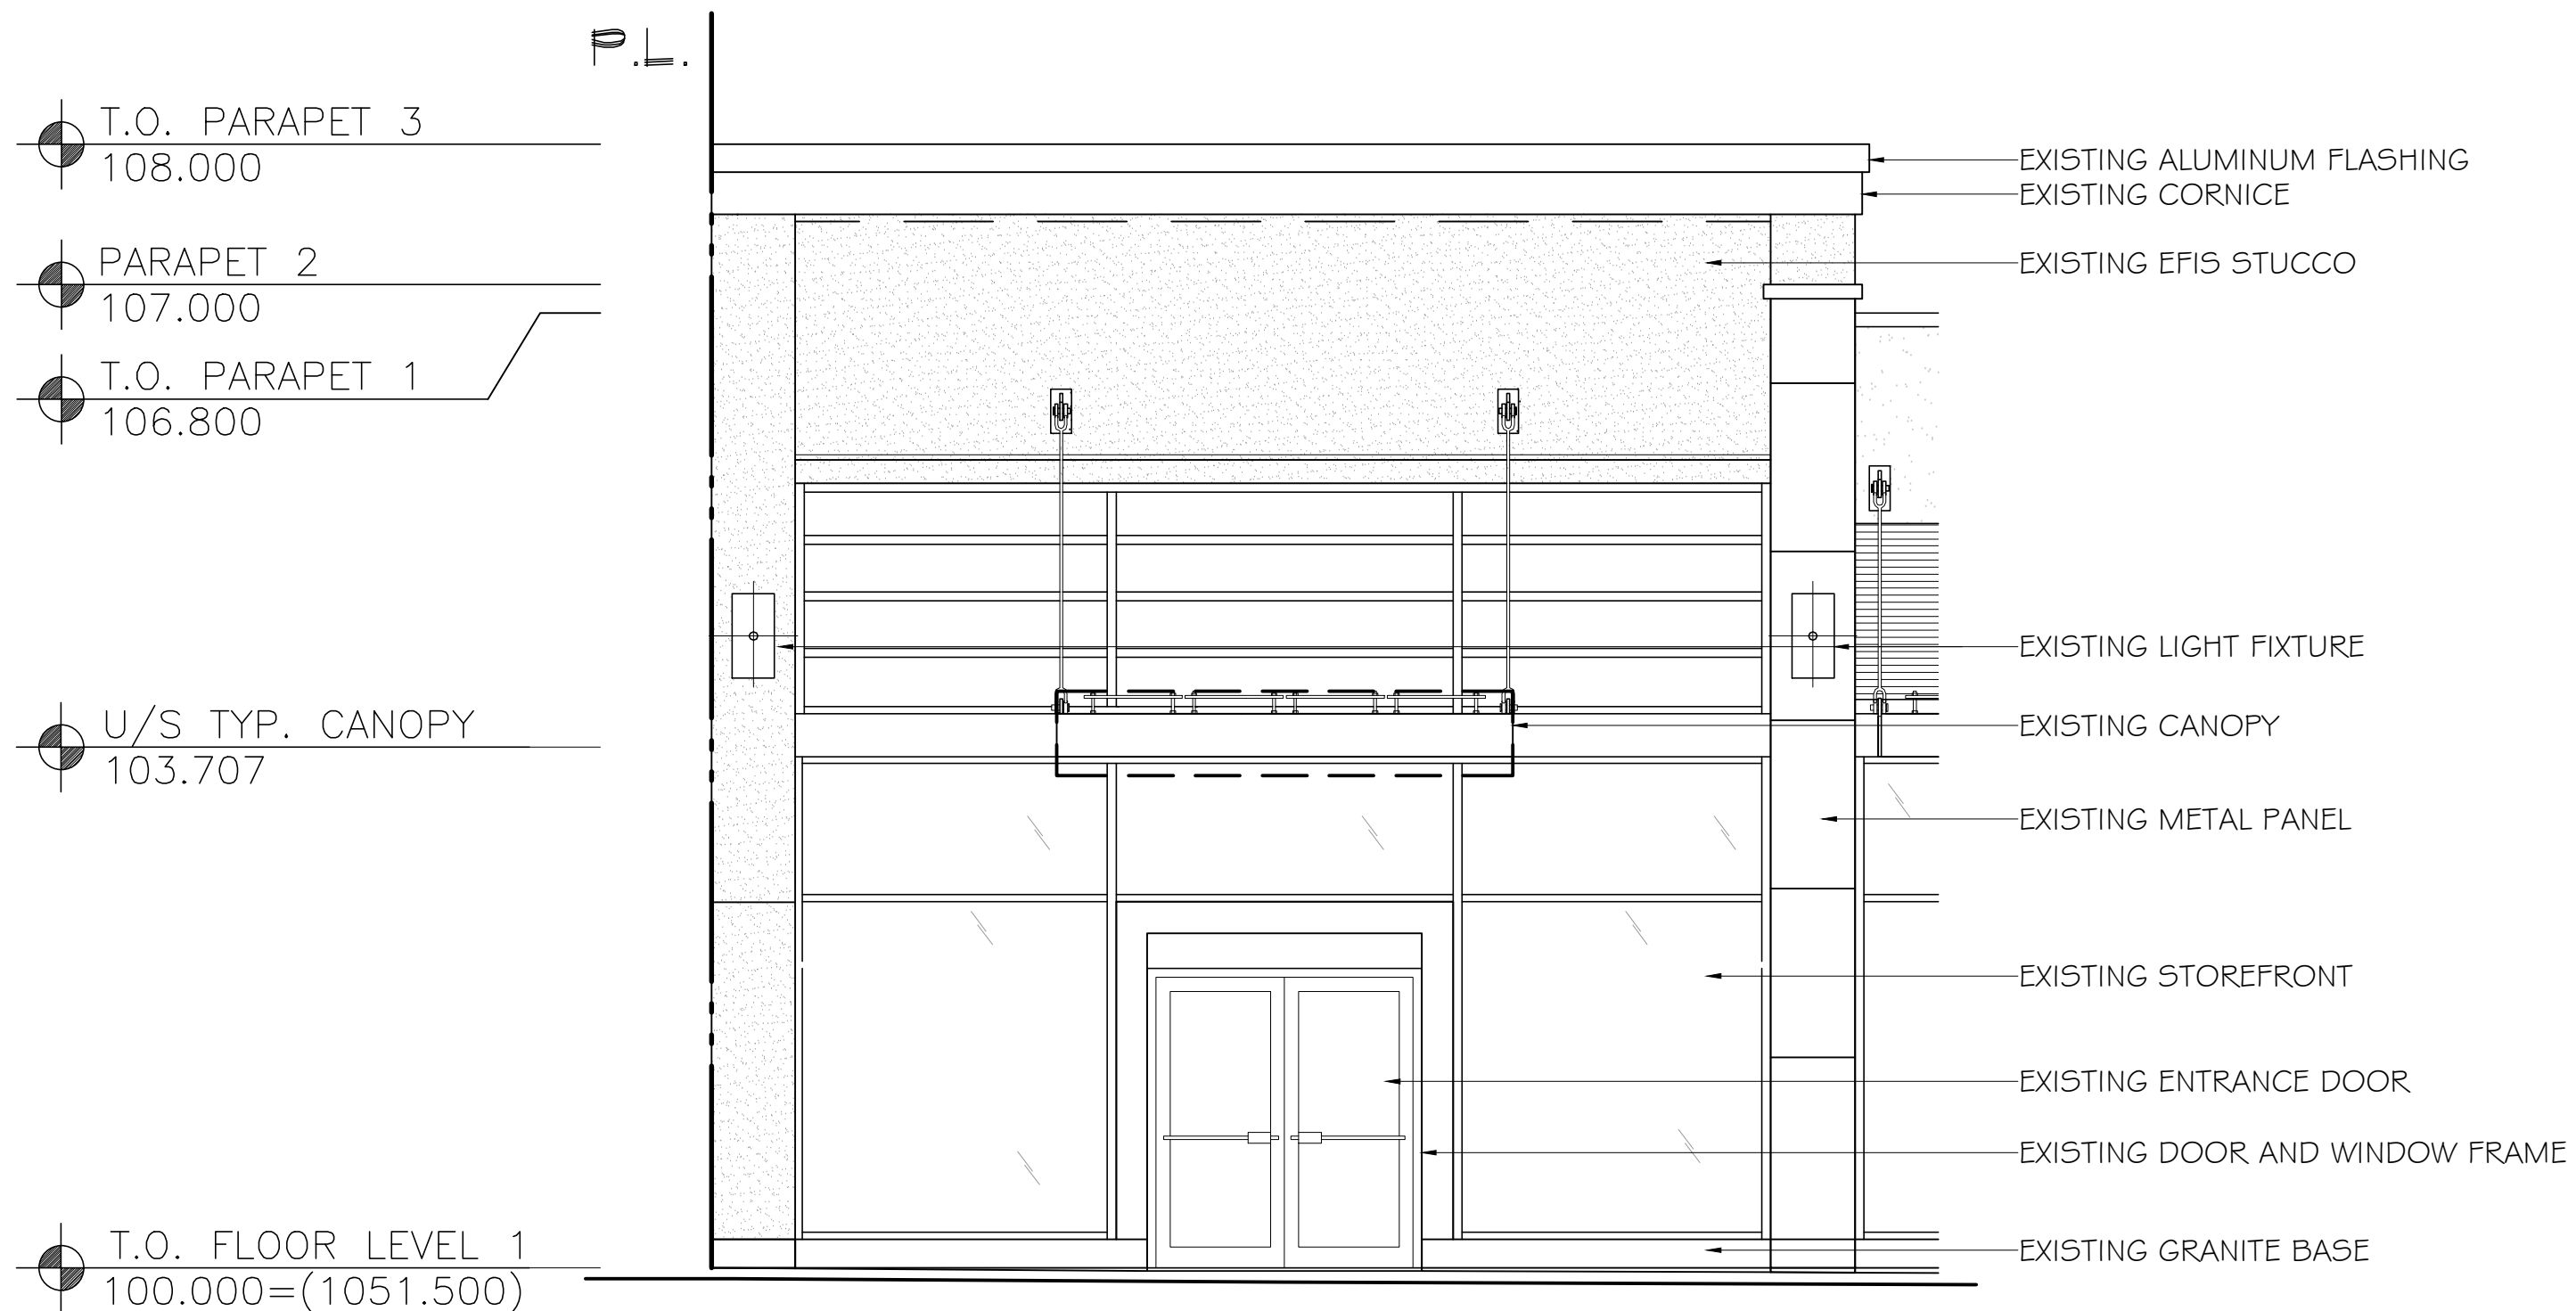

EXISTING SOUTH ELEVATION
SCALE: 1/4" = 1' - 0"

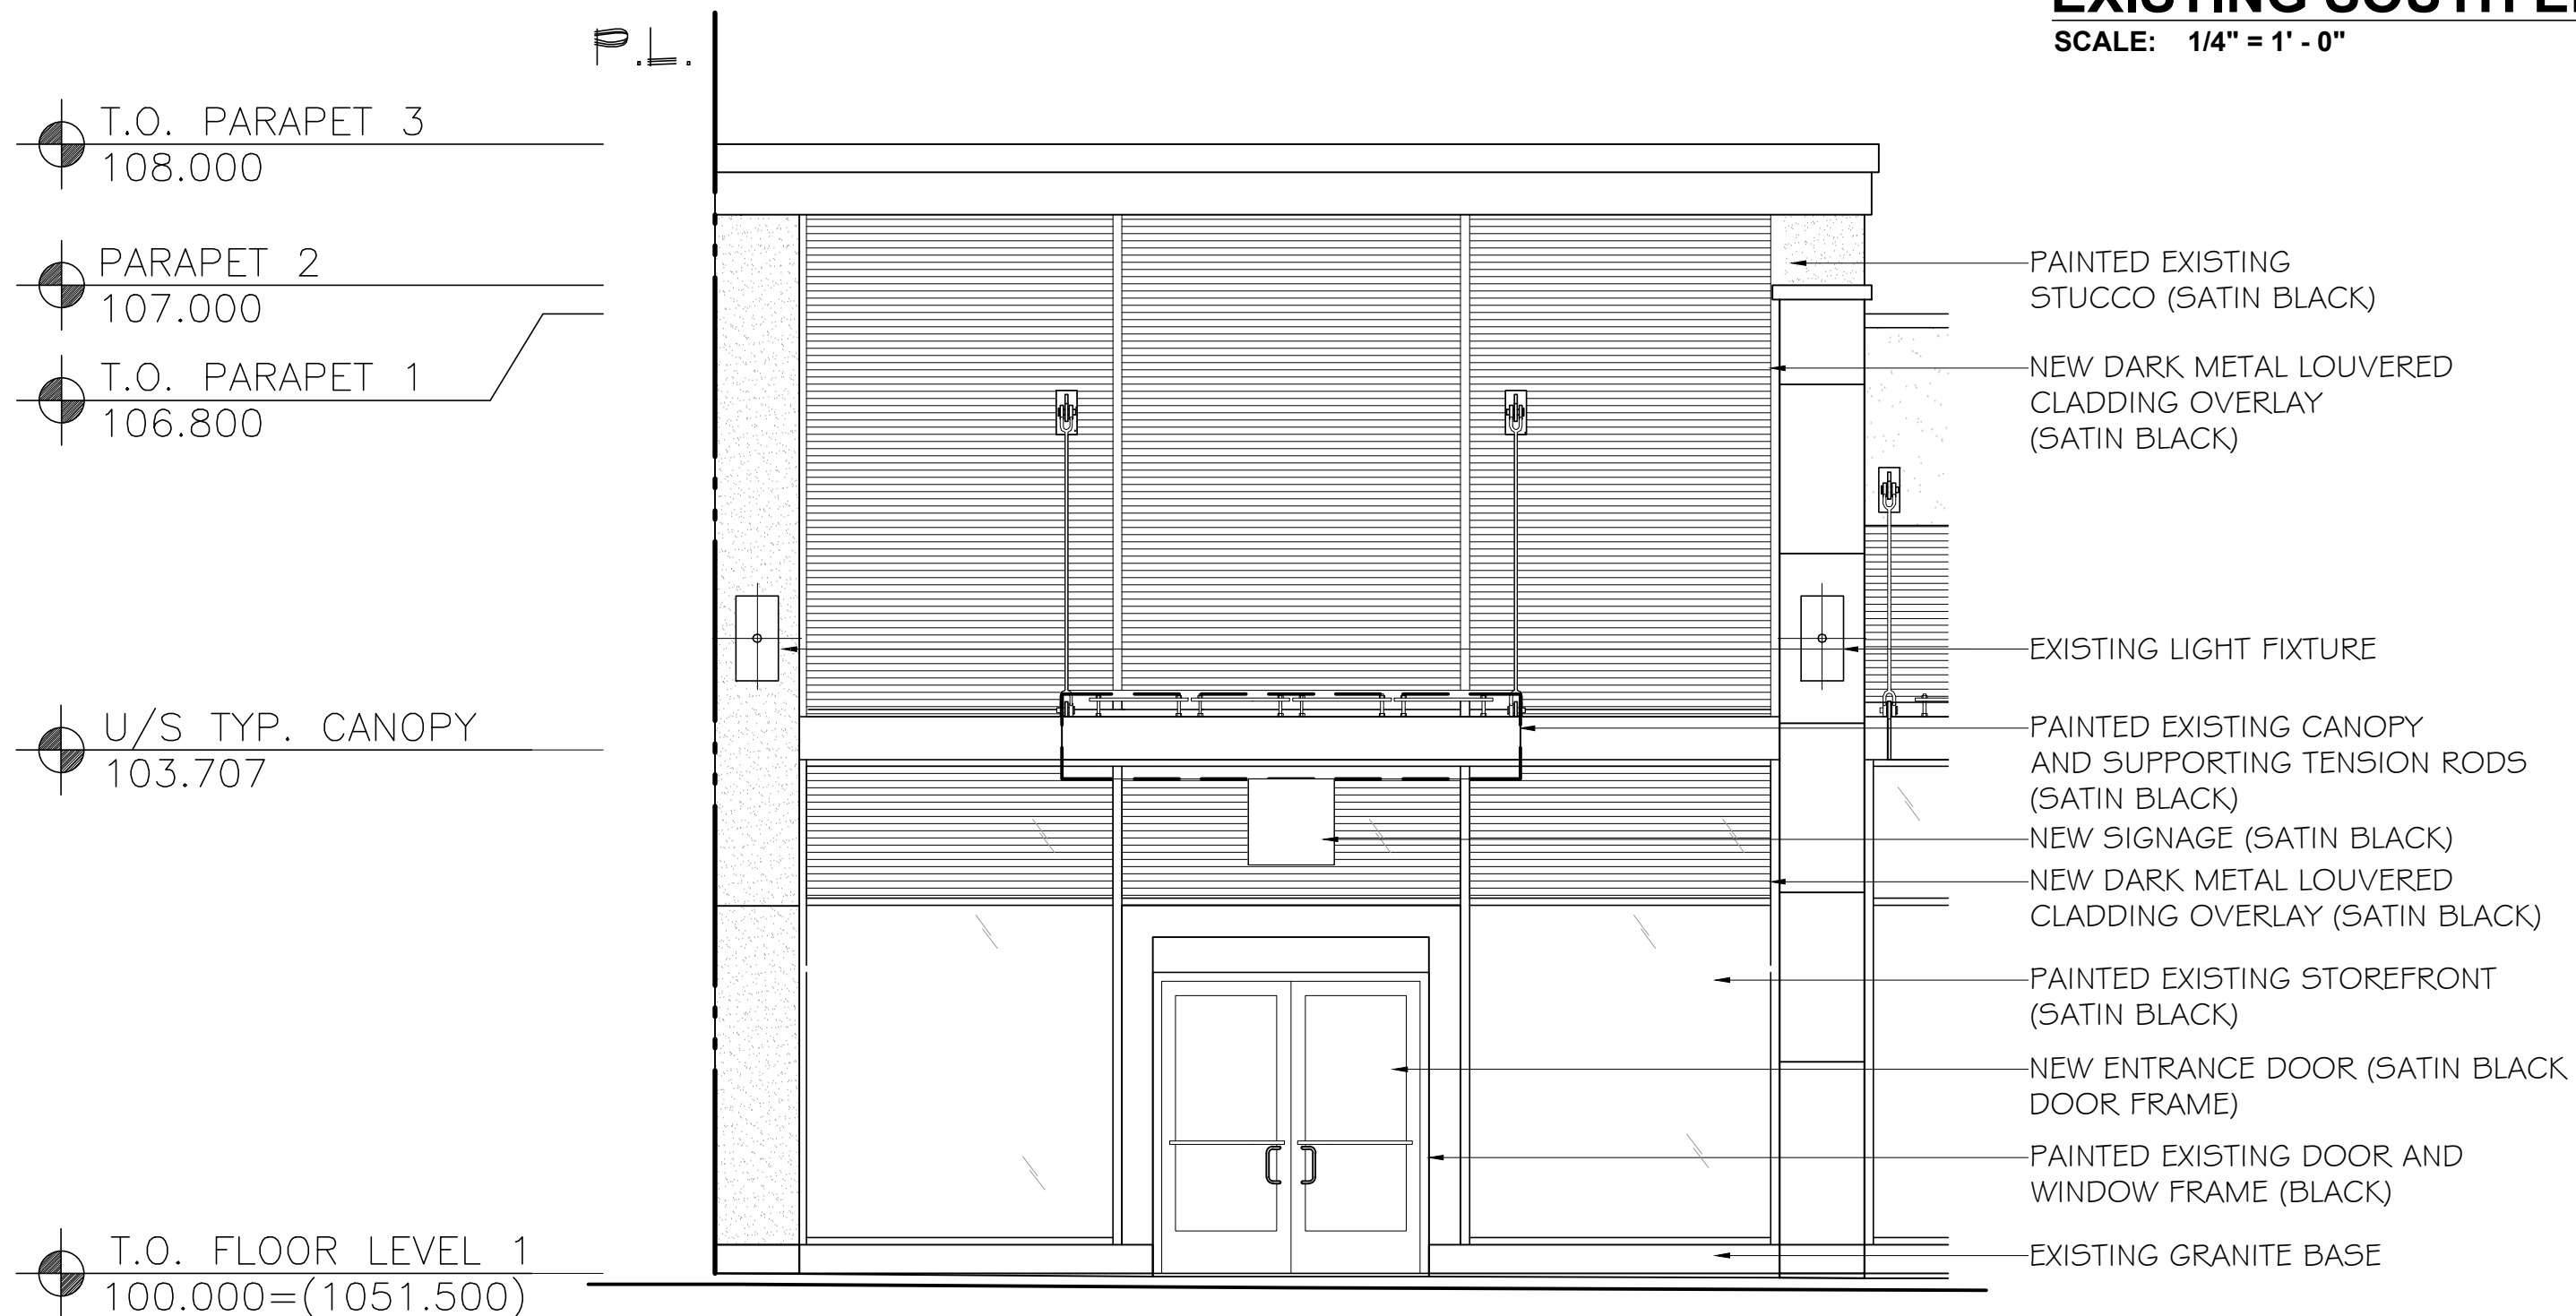

PROPOSED SOUTH ELEVATION
SCALE: 1/4" = 1' - 0"

**ISSUED ON
JUN 16, 2026
FOR DP
(EXTERIOR)**

**PLAN A1
BLOCK 107
LOT 24-28**

Revisions		
No.	Description	Date
0	ISSUED FOR DP (EXTERIOR)	JUN 16, 26

Project
**GOGI KOREAN BBQ
17 AVE**



508 17 AVE SW, CALGARY AB

Drawing Title
**EXISTING & PROPOSED
SOUTH ELEVATION**

Drawn By:	M. T.	Date:	JUN 2026
Designed By:	A. N.	Scale:	As Shown
Job Number	-		
Drawing Number	A - 1		
Rev. No.	0		

KAZU EXTERIOR DETAILED MARK-UP

Panel A: Cross-Section Detail / Panel B: Full Front Elevation

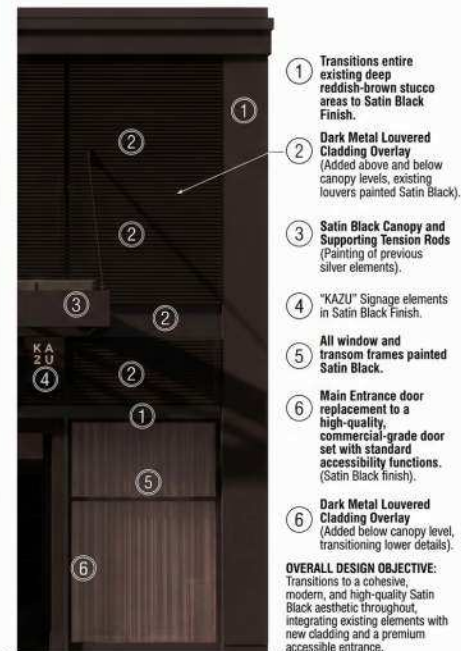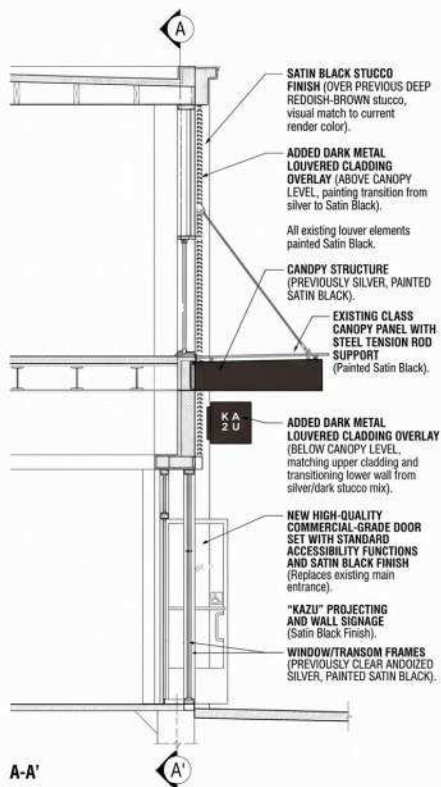

PROPOSED FRONT ELEVATION MARKUP

CURRENT EXTERIOR CONDITION



PROJECT SCOPE SUMMARY

Complete Satin Black painting of existing stucco, louvers, canopy, and frames. Installation of dark metal cladding overlay panels and integrated signage as specified below.

PROPOSED EXTERIOR UPGRADES with Cladding and Signage Overlays

