




MEASURED IN ACCORDANCE WITH EXTERIOR WALL METHODOLOGY

RECORD DRAWING

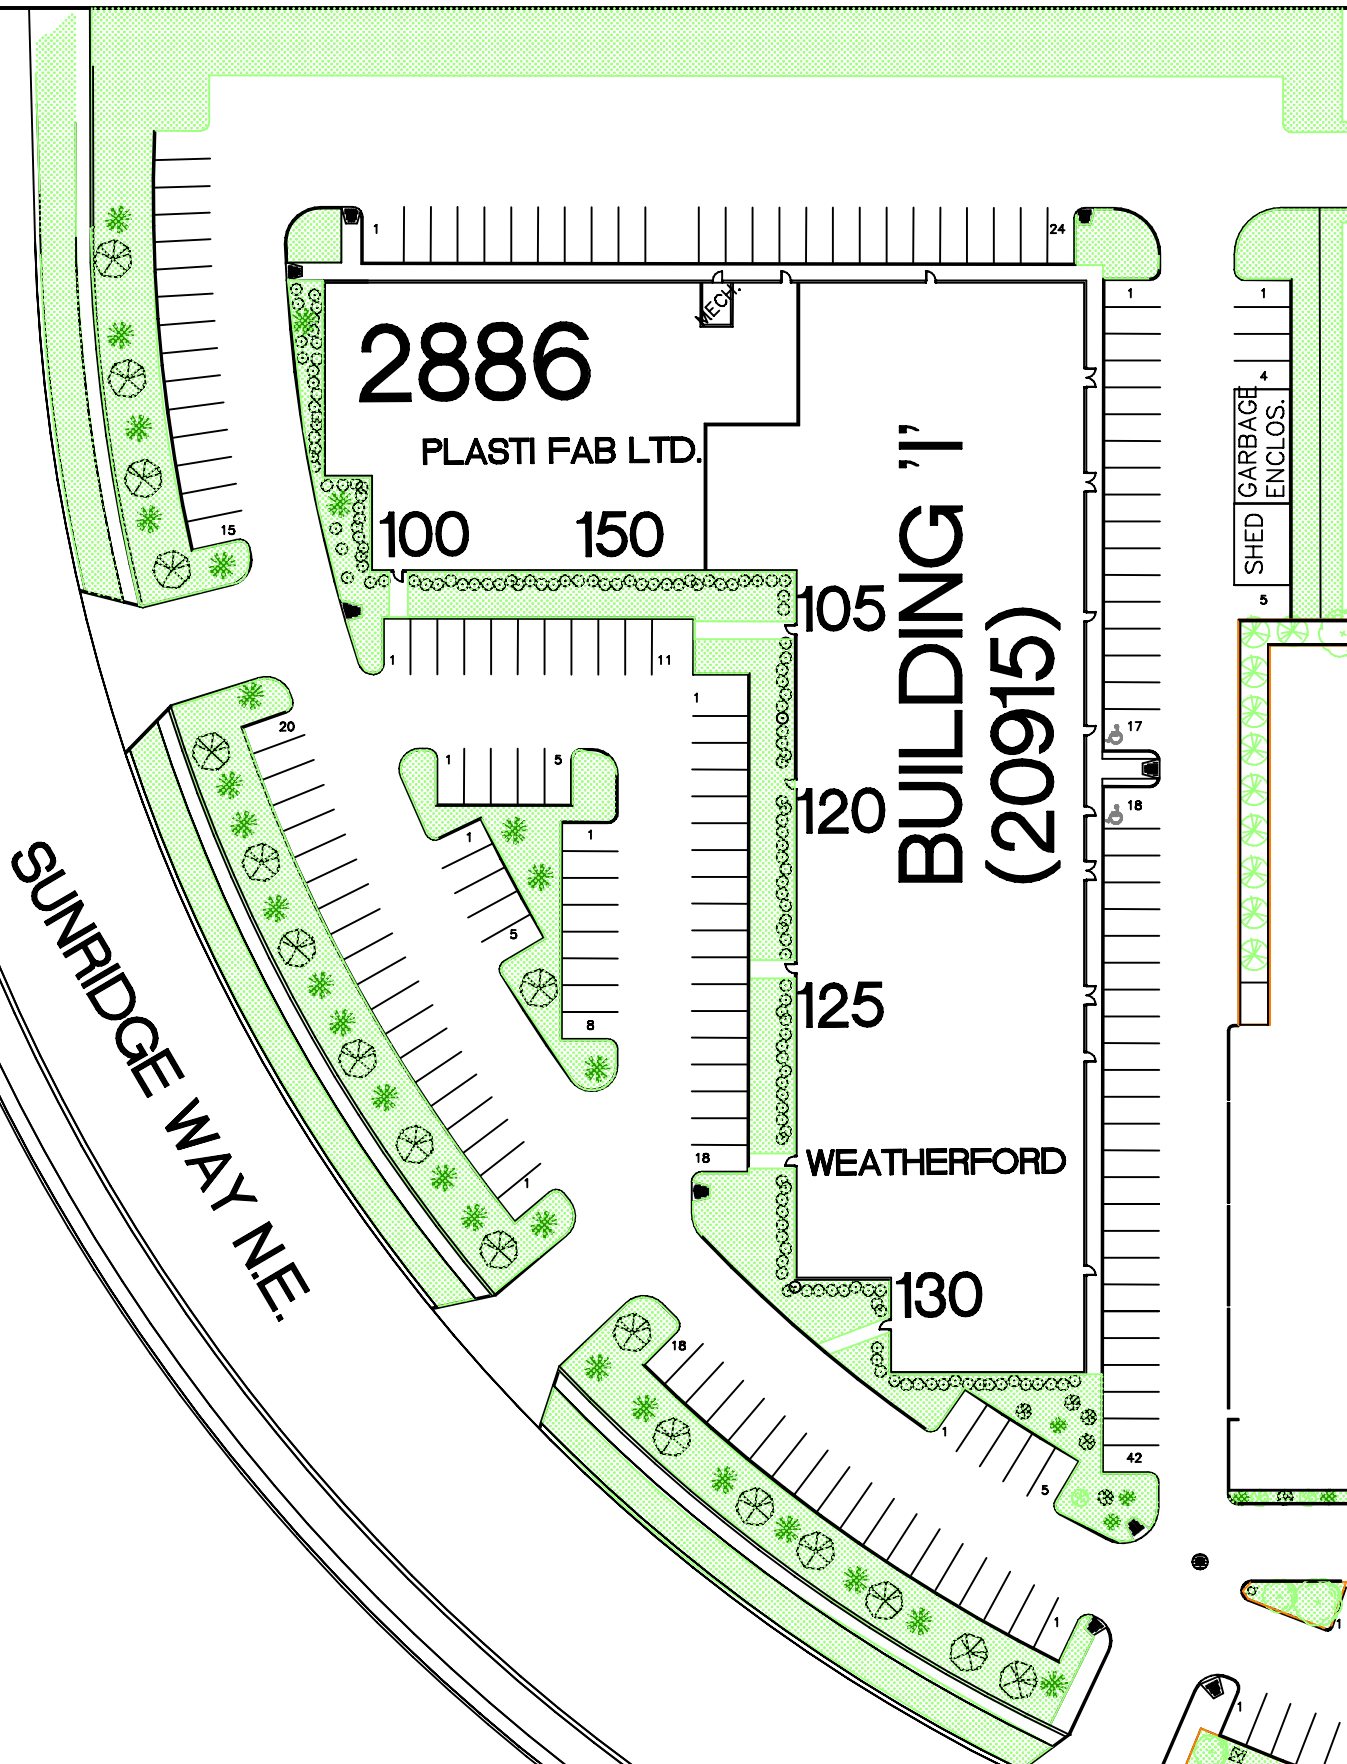

# SUNRIDGE BUSINESS PARK

DUNDEE REALTY MANAGEMENT CORPORATION

CAD-3 LTD: 630-4032

SCALE: = NTS

INQUIRIES: (403) 212-7114

NOVEMBER 28, 2008

