


ALBERTA LAND SURVEYOR'S REAL PROPERTY REPORT

26 Avenue S.W.

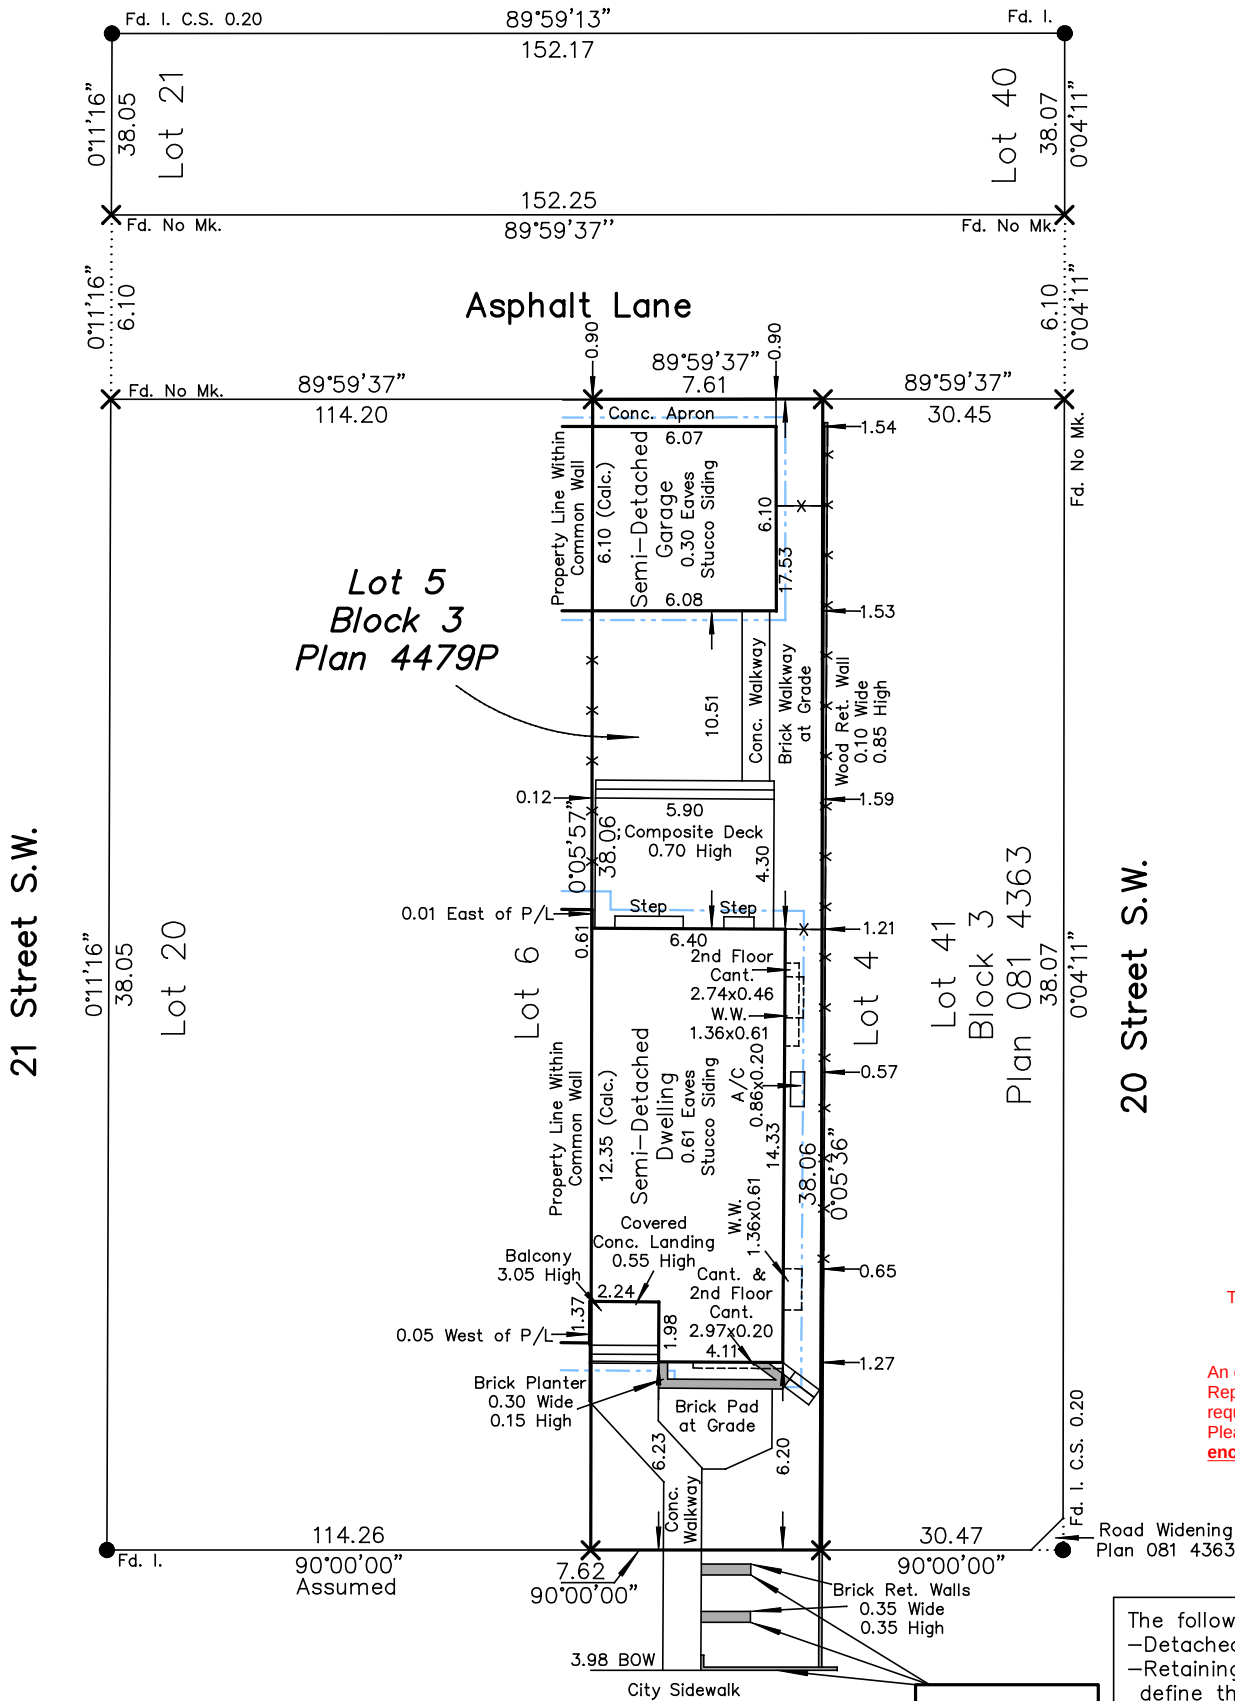

- ABBREVIATIONS**
- A---Arc Length
 - Acc.---Accessory
 - A/C---Air Conditioner
 - Bldg---Building
 - BOC---Back of Curb
 - BOW---Back of Walk
 - Calc.---Calculated
 - Cant.---Cantilever
 - Conc.---Concrete
 - C.S.---Countersunk
 - DH---Drill Hole
 - Enc.---Encroaches
 - Fd.---Found
 - I.---Iron Post
 - I.B.---Iron Bar
 - M.A.---Maintenance Access
 - Mk.---Mark
 - O.D.---Overland Drainage
 - P/L---Property Line
 - R---Radius
 - Reg.---Registration
 - Ret.---Retaining
 - R/W---Right of Way
 - W/O---Walkout Basement
 - W.W.---Window Well

NOTE:
UNLESS NOTED OTHERWISE LINES OUTSIDE OF PROPERTY ARE NOT TO SCALE.
*LOCATION OF THE PARTY WALL IS AN INTERPRETATION BASED ON OBSERVATIONS FROM OUTSIDE ONLY. IT IS OUR PRACTICE NOT TO ENTER PRIVATE RESIDENCES FOR LIABILITY AND PRIVACY REASONS. FOR ALL INTENDED PURPOSES, OUR PARTY WALL LINE IS FOR ILLUSTRATION ONLY AND WE CAN NOT BE HELD LIABLE FOR ANY PORTION OF THE BUILDINGS THAT MAY ENCROACH BETWEEN THE ADJOINING PROPERTIES.

Brick Ret. Walls
Enc. 0.82 & 2.39
& Wood Ret. Wall
Enc. 3.98
Into Road

The City of Calgary Real Estate & Development Services
Encroachment Advisory
An encroachment(s) has been identified on this Real Property Report. Encroachments into City of Calgary property may require authorization to be permitted to remain.
Please scan and e-mail a copy of the Real Property Report to encroachments@calgary.ca

- The following items may not be shown on the RPR:
- Detached sheds that are less than 10 sq.m.
 - Retaining walls or interior fences that do not define the property line
 - Hot tubs
 - Patios less than 0.60m in height
 - Planters, garden borders and ground level landscaping features
 - Ground level features covered by snow and ice

LEGAL DESCRIPTION:

Lot 5
Block 3
Plan 4479P


MUNICIPAL ADDRESS:

2110 27 Avenue S.W.
Calgary, Alberta

DATE OF SURVEY: February 24th, 2026.

LEGEND

Distances are in metres and decimals thereof.
Found Iron Posts are shown thus: _____
Drill Holes are shown thus: _____
Found Iron Bars are shown thus: _____
Found Concrete Nails are shown thus: _____
Calculation points are shown thus: _____
Pillars and posts are shown thus: _____
Property lines are shown thus: _____
Utility Right of Ways are shown thus: _____
Eaves are shown thus: _____
Fences are shown thus: _____
All fences are within 0.2 metres of the property lines unless otherwise shown.
All eaves are measured to fascia unless otherwise shown.

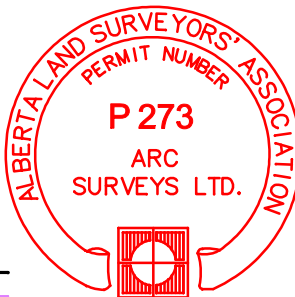

PURPOSE:

This Report and attached plan have been prepared for the benefit of the Property owner, subsequent owners and any of their agents for the purpose of a land conveyance, support of a subdivision application, a mortgage application, or a submittal to the municipality for the compliance certificate, etc. Copying is permitted only for the benefit of these parties, and only if the plan remains attached. Where applicable, registered easements and utility rights of way affecting the extent of the property have been shown on the attached plan. Unless shown otherwise, property corner markers have not been placed. The attached plan should not be used to establish boundaries due to the risk of misinterpretation or measurement error by the user. The information shown on this Real Property Report reflects the status of this property as of the date of survey only. Users are encouraged to have the Real Property Report updated for future requirements.

NOTE:

Title information is based on the C. of T. 121 076 617 which was searched on the 24th day of February, 2026, and is subject to:
Party Wall Agreement No.: 061 498 269

CERTIFICATION:

I hereby certify that this report, which includes the attached plan and related survey, was prepared and performed under my personal supervision and in accordance with the Alberta Land Surveyors' Association Manual of Standard Practice and supplements thereto. Accordingly within those standards and as of the date of this Report, I am of the opinion that:

1. the Plan illustrates the boundaries of the Property, the improvements as defined in Part C, Section 6.5 of the Alberta Land Surveyors' Association's Manual of Standard Practice, registered easements, and rights-of-way affecting the extent of the title to the property;
2. the improvements are entirely within the boundaries of the Property (except Brick & Wood Ret. Walls)
3. no visible encroachments exist on the Property from any improvements situated on an adjoining property
4. no visible encroachments exist on registered easements or rights-of-way affecting the extent of the Property
5. unless otherwise specified, the dimensions shown relate to the distances from property boundaries to the foundation walls of buildings at the date of survey.

Dated at Calgary, Alberta on this
24th day of February, 2026.

Chen Zheng, A.L.S.
This document is not valid unless it bears an original or digital signature in blue ink and an Arc Surveys Ltd. permit stamp in red ink.

© Copyright Arc Surveys Ltd. 2026
Arc Surveys Ltd.
#202, 337 41 Avenue N.E.
Calgary, Alberta T2E 2N4
Ph.: 403-277-1272
Fax: 403-277-1275
www.arcsurveys.ca
info@arcsurveys.ca

Surveyed: ML | Drawn: WY/WY | Scale: 1: 250 | 0m 2.5 5 10 | File No.: 260437