

ALBERTA LAND SURVEYOR'S REAL PROPERTY REPORT

LEGAL DESCRIPTION:

Lot 27
Block 11
Plan 741 0215

MUNICIPAL ADDRESS:

207 Oakside Road S.W.
Calgary, Alberta

DATE OF SURVEY: June 17th, 2026.

LEGEND

Distances are in metres and decimals thereof.

Found Iron Posts are shown thus: _____

Drill Holes are shown thus: _____

Found Iron Bars are shown thus: _____

Found Concrete Nails are shown thus: _____

Calculation points are shown thus: _____

Pillars and posts are shown thus: _____

Property lines are shown thus: _____

Utility Right of Ways are shown thus: _____

Eaves are shown thus: _____

Fences are shown thus: _____

All fences are within 0.2 metres of the property lines unless otherwise shown.

All eaves are measured to fascia unless otherwise shown.



PURPOSE:

This Report and attached plan have been prepared for the benefit of the Property owner, subsequent owners and any of their agents for the purpose of a land conveyance, support of a subdivision application, a mortgage application, or a submittal to the municipality for the compliance certificate, etc. Copying is permitted only for the benefit of these parties, and only if the plan remains attached. Where applicable, registered easements and utility rights of way affecting the extent of the property have been shown on the attached plan. Unless shown otherwise, property corner markers have not been placed. The attached plan should not be used to establish boundaries due to the risk of misinterpretation or measurement error by the user. The information shown on this Real Property Report reflects the status of this property as of the date of survey only. Users are encouraged to have the Real Property Report updated for future requirements.

NOTE:

Title information is based on the C. of T. 911 139 351 which was searched on the 19th day of June, 2026, and is subject to:

No Pertinent Registration.

CERTIFICATION:

I hereby certify that this report, which includes the attached plan and related survey, was prepared and performed under my personal supervision and in accordance with the Alberta Land Surveyors' Association Manual of Standard Practice and supplements thereto. Accordingly within those standards and as of the date of this Report, I am of the opinion that:

- the Plan illustrates the boundaries of the Property, the improvements as defined in Part C, Section 6.5 of the Alberta Land Surveyors' Association's Manual of Standard Practice, registered easements, and rights-of-way affecting the extent of the title to the property;
- the improvements are entirely within the boundaries of the Property (except Stone Ret. Wall, Conc. Apron & Fence)
- no visible encroachments exist on the Property from any improvements situated on an adjoining property
- no visible encroachments exist on registered easements or rights-of-way affecting the extent of the Property
- unless otherwise specified, the dimensions shown relate to the distances from property boundaries to the foundation walls of buildings at the date of survey.

Dated at Calgary, Alberta on this 25th day of June, 2026.


Jerrad Gerein, A.L.S.
This document is not valid unless it bears an original or digital signature in blue ink and an Arc Surveys Ltd. permit stamp in red ink.

© Copyright Arc Surveys Ltd. 2026

Arc Surveys Ltd.

#202, 337 41 Avenue N.E.
Calgary, Alberta T2E 2N4
Ph.: 403-277-1272 www.arcsurveys.ca
Fax: 403-277-1275 info@arcsurveys.ca

Surveyed:KX Drawn:PC/PC Scale:1:250 0m 2.5 5 10 File No.: 262497

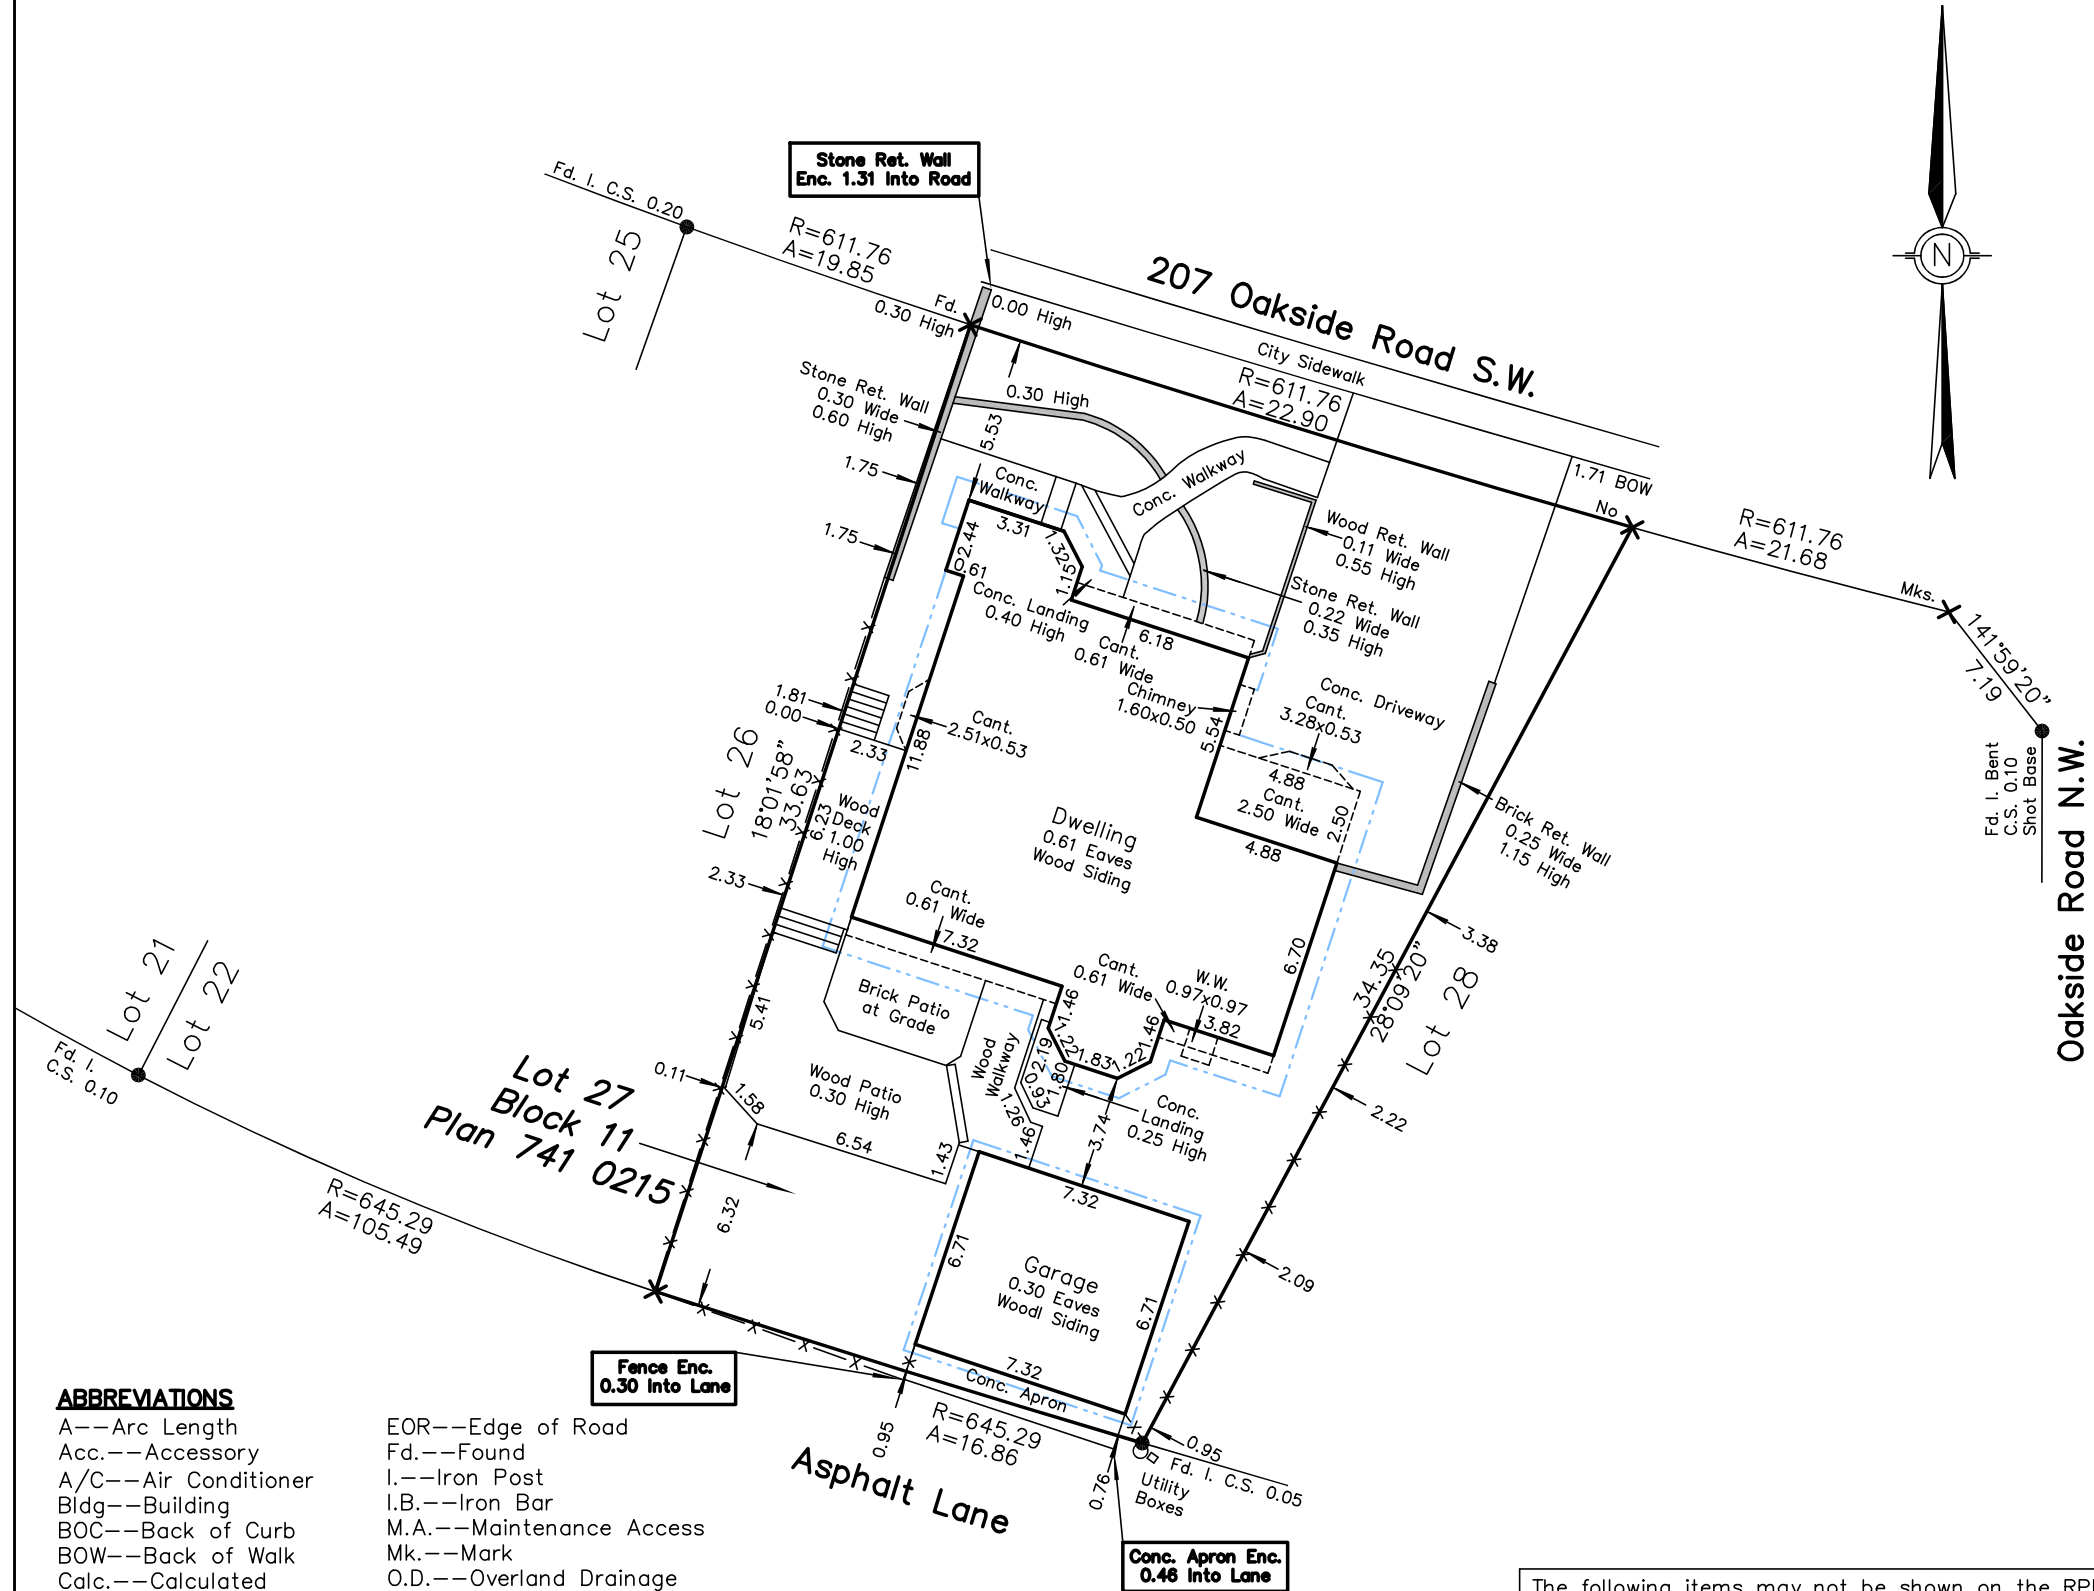

ABBREVIATIONS

A---Arc Length
Acc---Accessory
A/C---Air Conditioner
Bldg---Building
BOC---Back of Curb
BOW---Back of Walk
Calc---Calculated
Cant---Cantilever
Conc---Concrete
C.S---Countersunk
DH---Drill Hole
Enc---Encroaches
EOA---Edge of Asphalt

EOR---Edge of Road
Fd---Found
I---Iron Post
I.B---Iron Bar
M.A---Maintenance Access
Mk---Mark
O.D---Overland Drainage
P/L---Property Line
Reg---Registration
Ret---Retaining
R/W---Right of Way
W/O---Walkout Basement
W.W---Window Well

NOTE:

UNLESS NOTED OTHERWISE LINES OUTSIDE OF PROPERTY ARE NOT TO SCALE.

The following items may not be shown on the RPR:
-Detached sheds that are less than 10 sq.m.
-Retaining walls or interior fences that do not define the property line
-Hot tubs
-Patios less than 0.60m in height
-Planters, garden borders and ground level landscaping features