


ALBERTA LAND SURVEYOR'S REAL PROPERTY REPORT

LEGAL DESCRIPTION: Lot 9 Block 14 Plan 131 0253 MUNICIPAL ADDRESS: 11 Aspen Vista Way S.W. Calgary, Alberta

DATE OF SURVEY: March 11th, 2026.

LEGEND Distances are in metres and decimals thereof. Found Iron Posts are shown thus: Found Iron Bars are shown thus: Found Concrete Nails are shown thus: Calculation points are shown thus: Pillars and posts are shown thus: Property lines are shown thus: Utility Right of Ways are shown thus: Eaves are shown thus: Fences are shown thus: All fences are within 0.2 metres of the property lines unless otherwise shown. All eaves are measured to fascia unless otherwise shown.

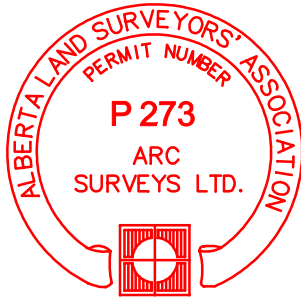

PURPOSE: This Report and attached plan have been prepared for the benefit of the Property owner, subsequent owners and any of their agents for the purpose of a land conveyance, support of a subdivision application, a mortgage application, or a submittal to the municipality for the compliance certificate, etc. Copying is permitted only for the benefit of these parties, and only if the plan remains attached. Where applicable, registered easements and utility rights of way affecting the extent of the property have been shown on the attached plan. Unless shown otherwise, property corner markers have not been placed. The attached plan should not be used to establish boundaries due to the risk of misinterpretation or measurement error by the user. The information shown on this Real Property Report reflects the status of this property as of the date of survey only. Users are encouraged to have the Real Property Report updated for future requirements.


NOTE: Title information is based on the C. of T. 151 176 989 which was searched on the 12th day of March, 2026, and is subject to: Caveat No.: 101 342 083, 131 026 689 Utility Right of Way No.: 131 026 688 Restrictive Covenant No.: 131 026 697, 141 214 915 Easement No.: 131 026 698 Encumbrance No.: 141 214 914

CERTIFICATION: I hereby certify that this report, which includes the attached plan and related survey, was prepared and performed under my personal supervision and in accordance with the Alberta Land Surveyors' Association Manual of Standard Practice and supplements thereto. Accordingly within those standards and as of the date of this Report, I am of the opinion that: 1. the Plan illustrates the boundaries of the Property, the improvements as defined in Part C, Section 6.5 of the Alberta Land Surveyors' Association's Manual of Standard Practice, registered easements, and rights-of-way affecting the extent of the title to the property; 2. the improvements are entirely within the boundaries of the Property 3. no visible encroachments exist on the Property from any improvements situated on an adjoining property 4. no visible encroachments exist on registered easements or rights-of-way affecting the extent of the Property 5. unless otherwise specified, the dimensions shown relate to the distances from property boundaries to the foundation walls of buildings at the date of survey.

Dated at Calgary, Alberta on this 12th day of March, 2026. Jerrad Gerein, A.L.S. This document is not valid unless it bears an original or digital signature in blue ink and an Arc Surveys Ltd. permit stamp in red ink. Arc Surveys Ltd. #202, 337 41 Avenue N.E. Calgary, Alberta T2E 2N4 Ph.: 403-277-1272 www.arcsurveys.ca Fax: 403-277-1275 info@arcsurveys.ca Surveyed: ML Drawn: JJ/JJ Scale: 1: 200 0m 2 4 8 File No.: 260613

- ABBREVIATIONS A---Arc Length Acc---Accessory A/C---Air Conditioner Bldg---Building BOC---Back of Curb BOW---Back of Walk Calc---Calculated Cant---Cantilever Conc---Concrete C.S---Countersunk DH---Drill Hole Enc---Encroaches Fd---Found I---Iron Post I.B---Iron Bar M.A---Maintenance Access Mk---Mark O.D---Overland Drainage P/L---Property Line R---Radius Reg---Registration Ret---Retaining R/W---Right of Way W/O---Walkout Basement W.W---Window Well

Aspen Summit Drive S.W.

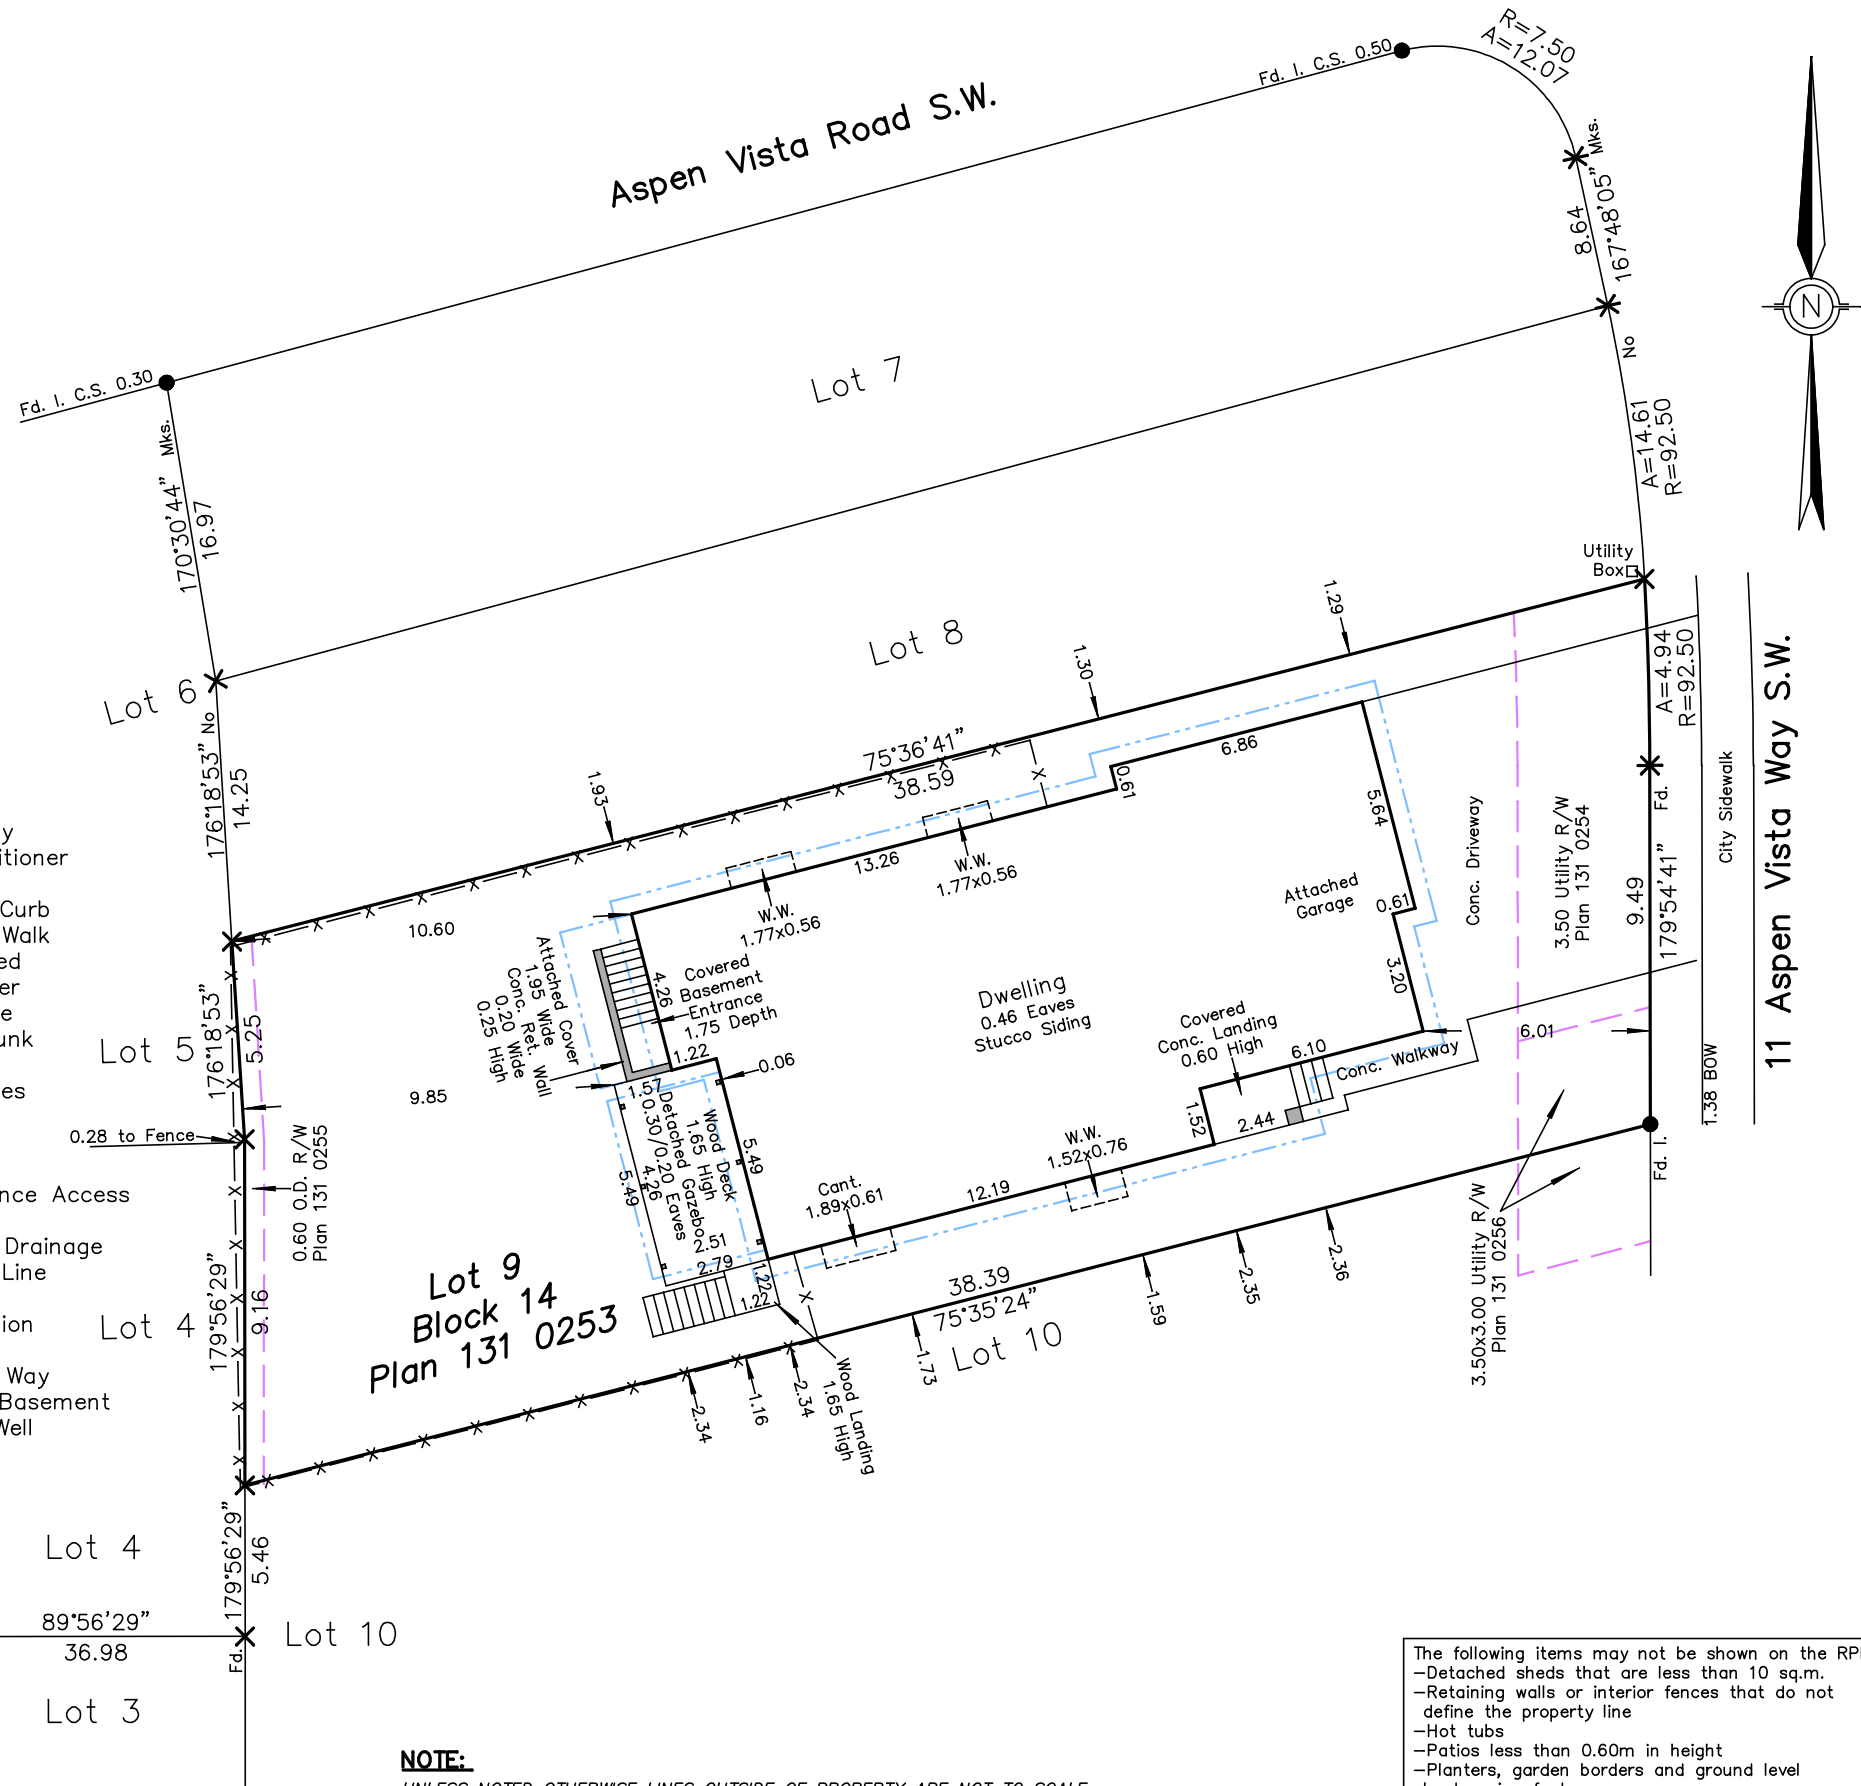

NOTE: UNLESS NOTED OTHERWISE LINES OUTSIDE OF PROPERTY ARE NOT TO SCALE.

- The following items may not be shown on the RPR: -Detached sheds that are less than 10 sq.m. -Retaining walls or interior fences that do not define the property line -Hot tubs -Patios less than 0.60m in height -Planters, garden borders and ground level landscaping features -Ground level features covered by snow and ice