




MANAGEMENT COMPANY	REQUIRED LOAD/WEEK	CONTAINER SIZE			PICK UP SCHEDULE
		WASTE	RECYCLING	FOOD/ORGANIC	
Super Save Disposal PHONE:(403) 590 4011	3.00 CU.M.	600P/3 YRDS/BIN 1 BIN/2 COMP. 6'0"L X4' W X 4' H			1 LOAD PICKUP/WEEK
	2.80 CU.M.			TOTER 1 BIN 24"LX32"WX42"H	1 LOAD PICKUP/MONTH

NO.	VEHICLE	TAC NAME	TURNING RADIUS
1	WASTE & RECYCLING	GVW 26100KG	12.8M
2	FIRE TRUCK	CFD_BRONTO_SKTLIGHT	
3	LOADING VEHICLE	M2W BALKIN 21.5 SERIES 12	12.0M

RG. NO:

DP1.0

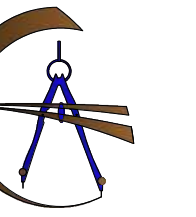

KA ASSOCIATES INC.

RESIDENTIAL COMMERCIAL & INTERIOR

04-3516, 26 ST NE, CALGARY,
AB T1Y 4T7
T: 403 889 6836, 403 800 6820
E-Mail: khalid@kaaa.ca
Website: kaarc.ca

CONSULTANTS

SCOPE OF WORK:
-2ND FLOOR ADDITION(INDOOR)
-MINOR CHANGES TO ELEVATIONS
-NO SITE PLAN CHANGES EXCEPT
LABBLED PARKING

NOTE:
CONTRACTOR MUST READ ALL
DRAWINGS AND VISIT SITE TO
CONFIRM ALL EXISTING DIMENSIONS
BEFORE START CONSTRUCTION AND
CONTACT DESIGNER IF ANY ERROR
IN DRAWING OR EXISTING SITE
CONDITION

CLIENT:

COPYRIGHT:

THESE DRAWINGS ARE THE
PROPERTY OF KA ASSOCIATES
INC. ALL RIGHTS RESERVED,
INCLUDING THE RIGHT OF
REPRODUCTION, IN WHOLE OR IN
PART OR ANY FORM WITHOUT
THE WRITTEN PERMISSION OF KA
ASSOCIATES INC.

PROJECT:

HAYSBORO DENTAL
BUILDING ALTERATION

CIVIC ADDRESS:

9504 HORTON ROAD S.W. CALGARY

LEGAL ADDRESS:

LOT 6 BLOCK 9 PLAN 931 1963

REVISIONS:

NO.	DATE	DESCRIPTION
11		
10		
09		
08		
07		





06	28-07-26	ISSUED FOR DP
05	21-07-26	FOR CLIENT REVIEW
04	02-07-26	FOR CLIENT REVIEW
03	12-06-26	FOR CLIENT REVIEW
02	15-05-26	AS-BUILT DRAWING
01	07-05-26	START


MARK	DATE	DESCRIPTION
PROJECT NO:	KAAC2605	
CAD DWG FILE:	0504 HAYSBORO DENTAL_DP.DWG	
DRAWN BY:	BS	
CHK'D BY:	KA	
DRAWING TITLE		

ELEVATIONS

DRG. NO:

 DP3.0

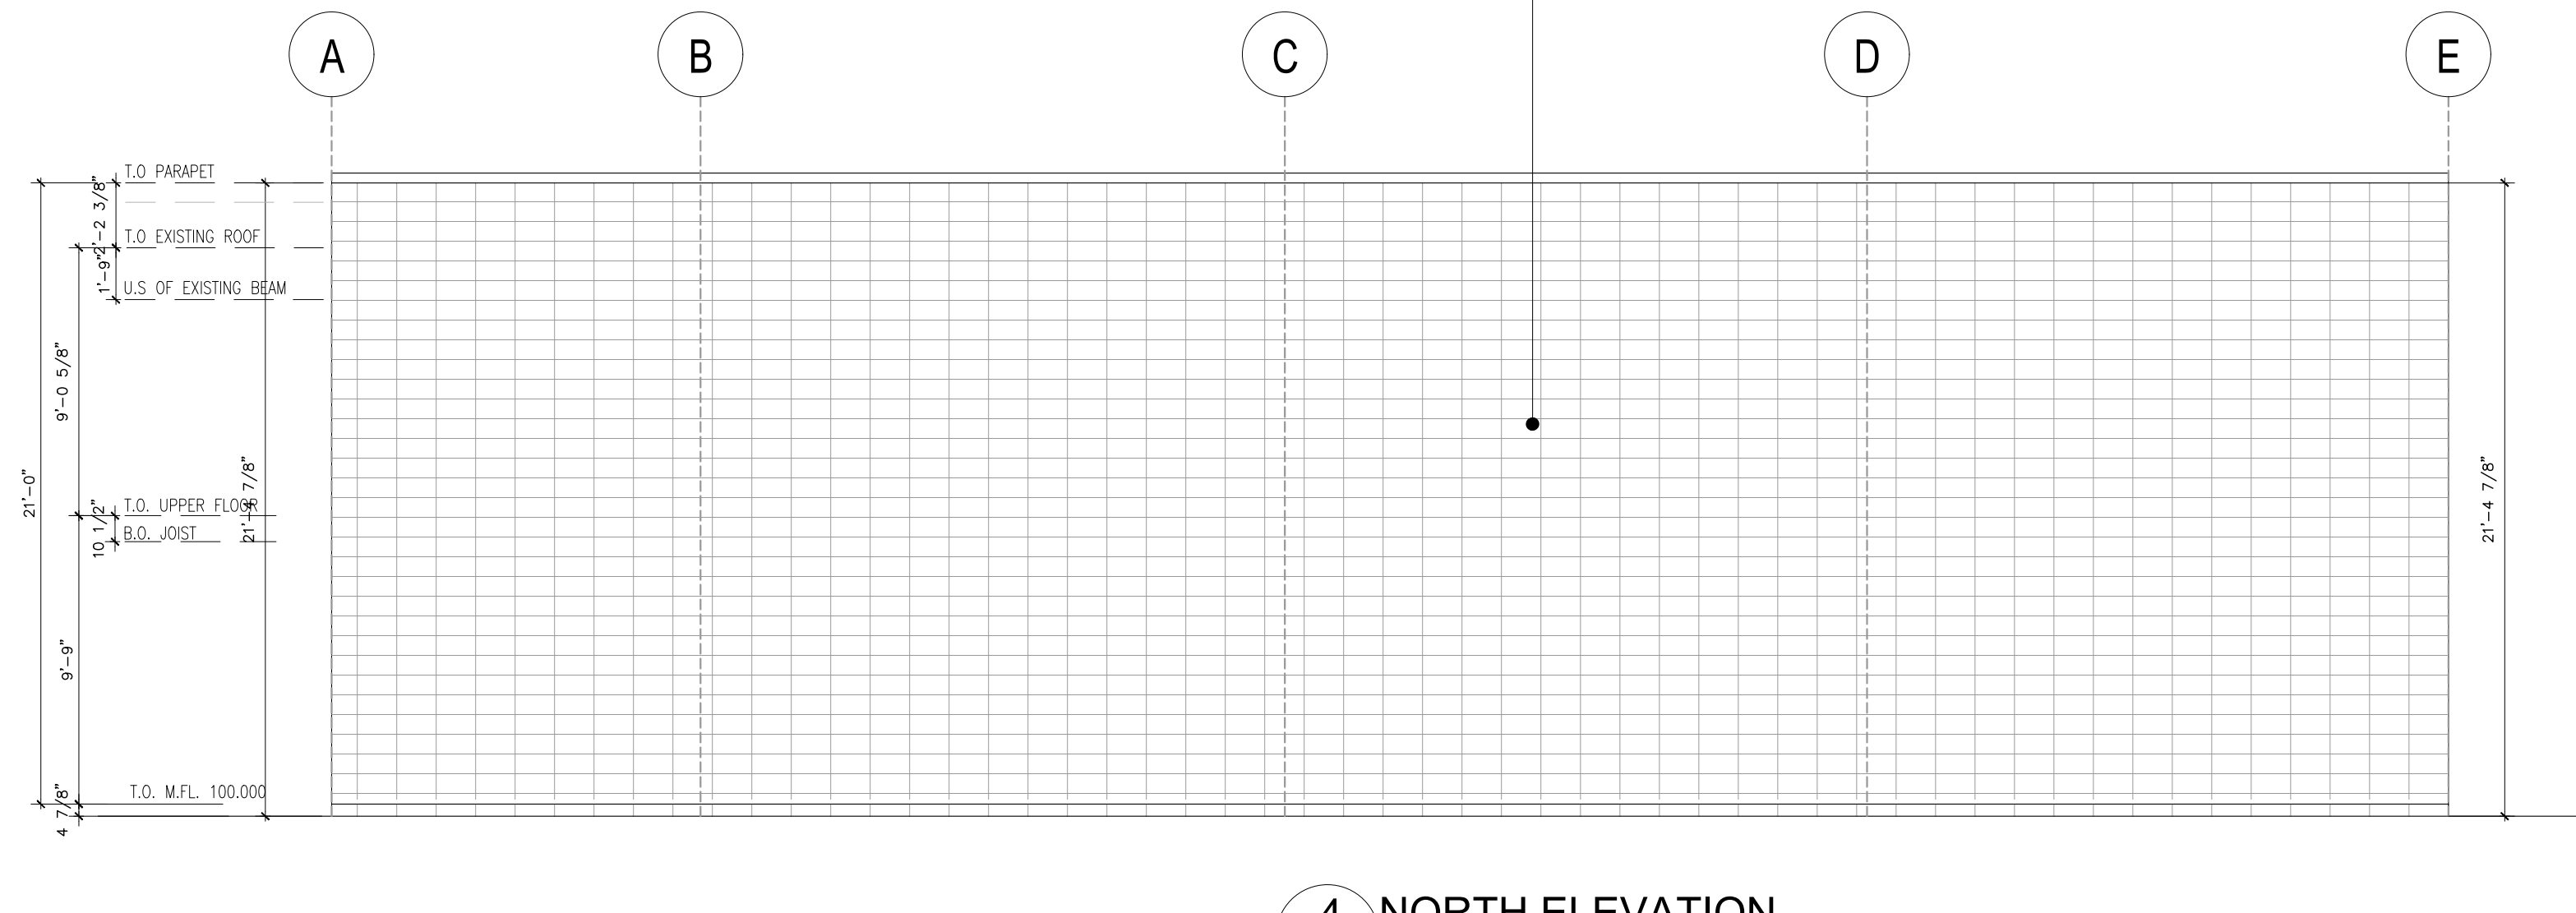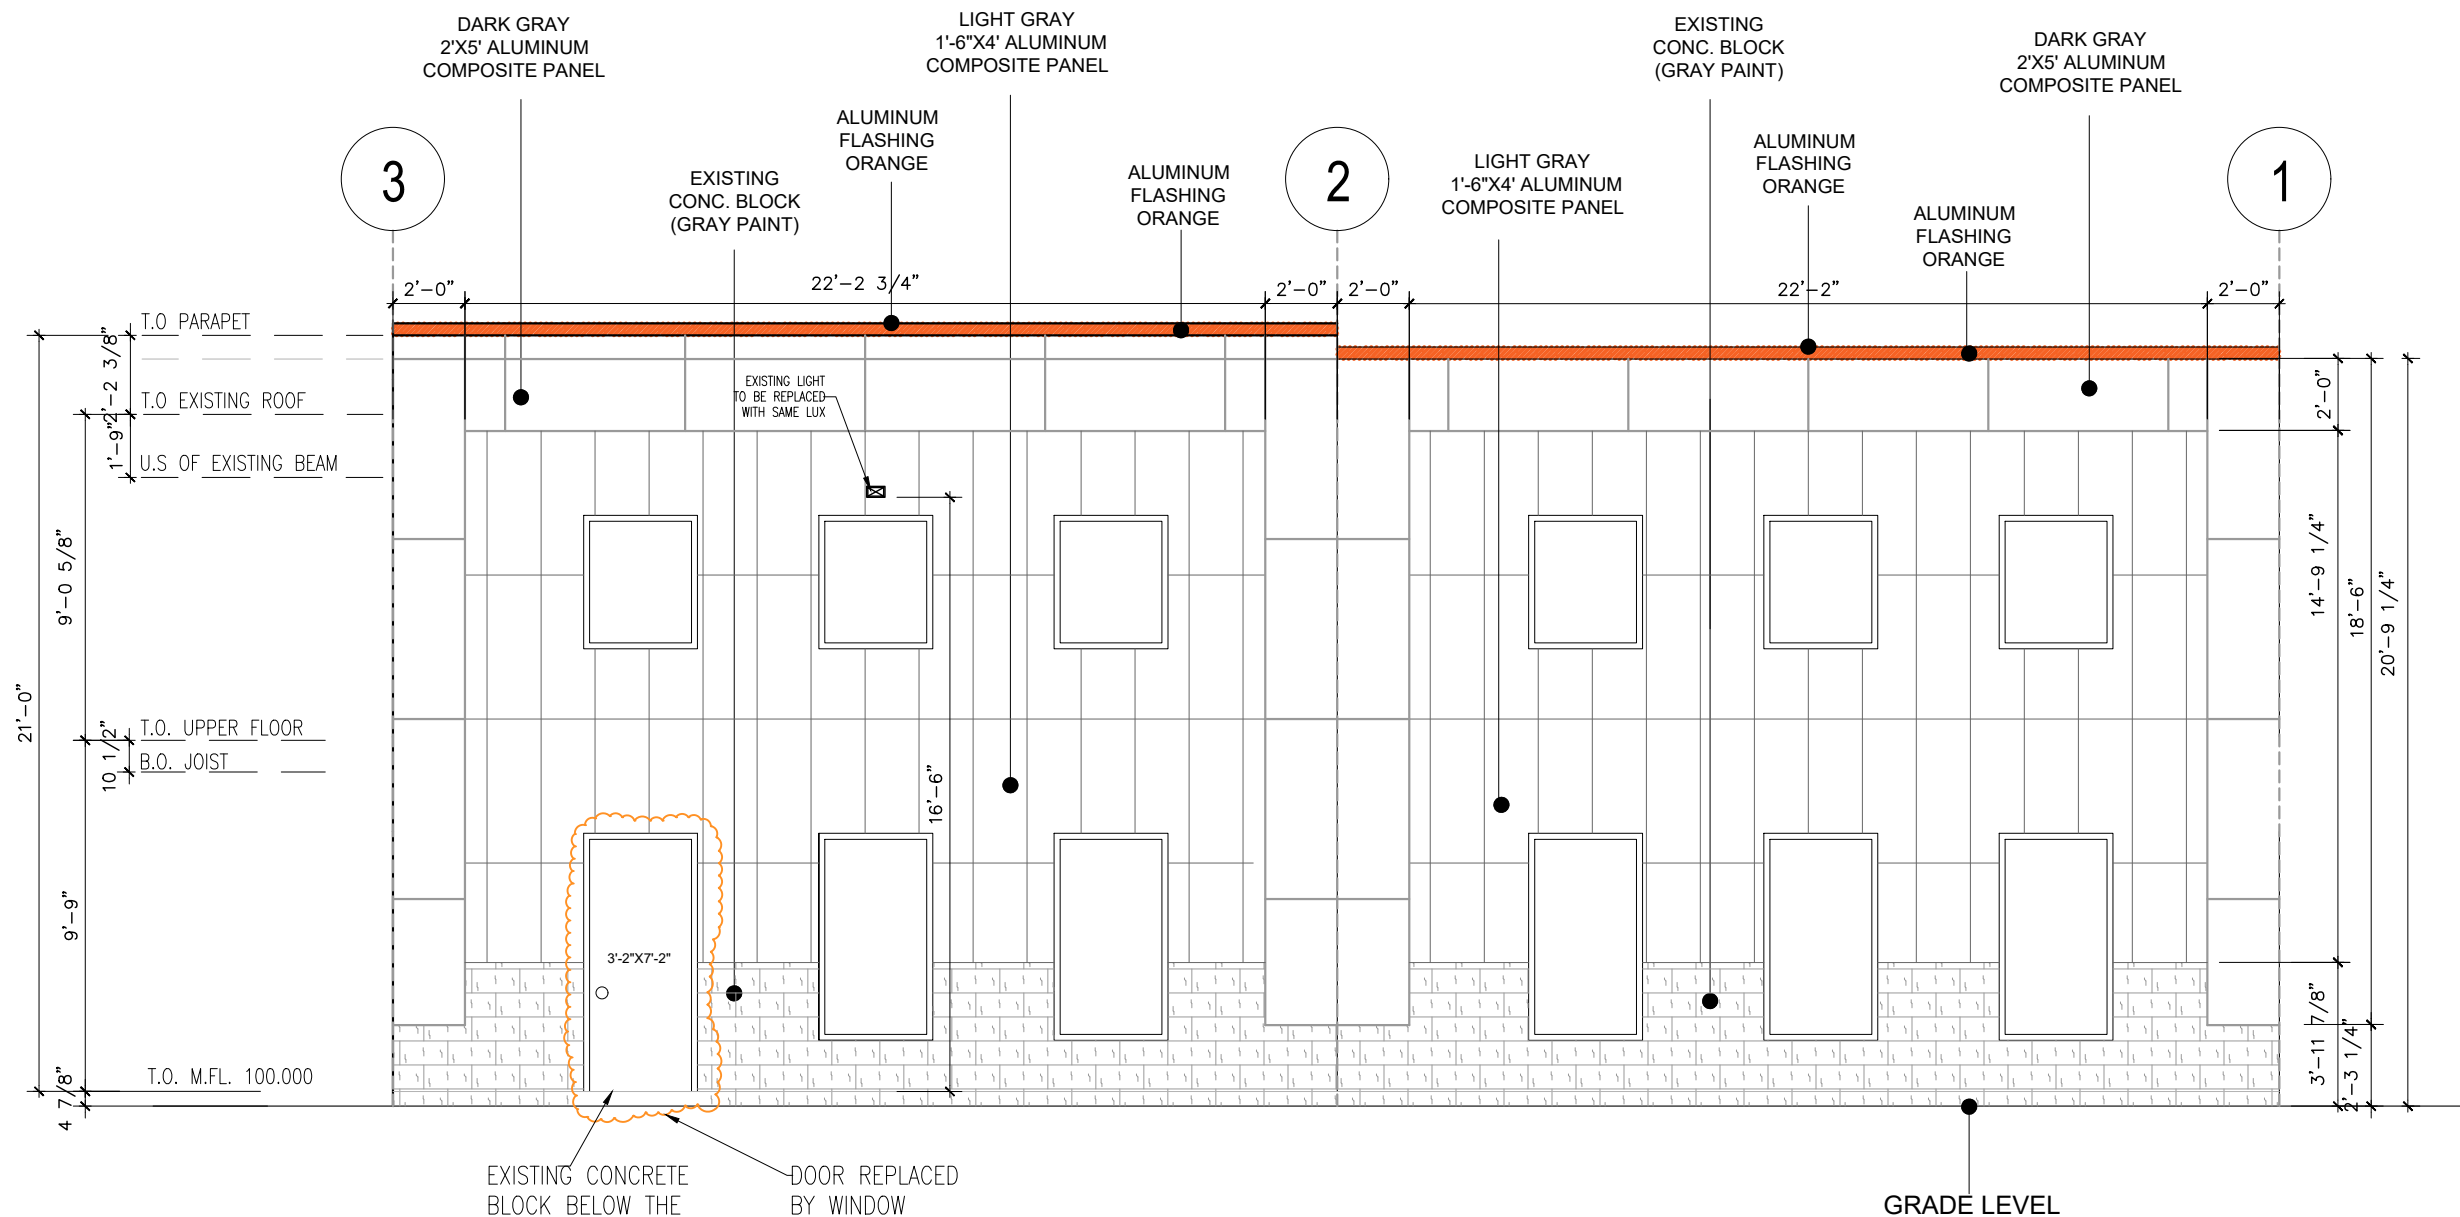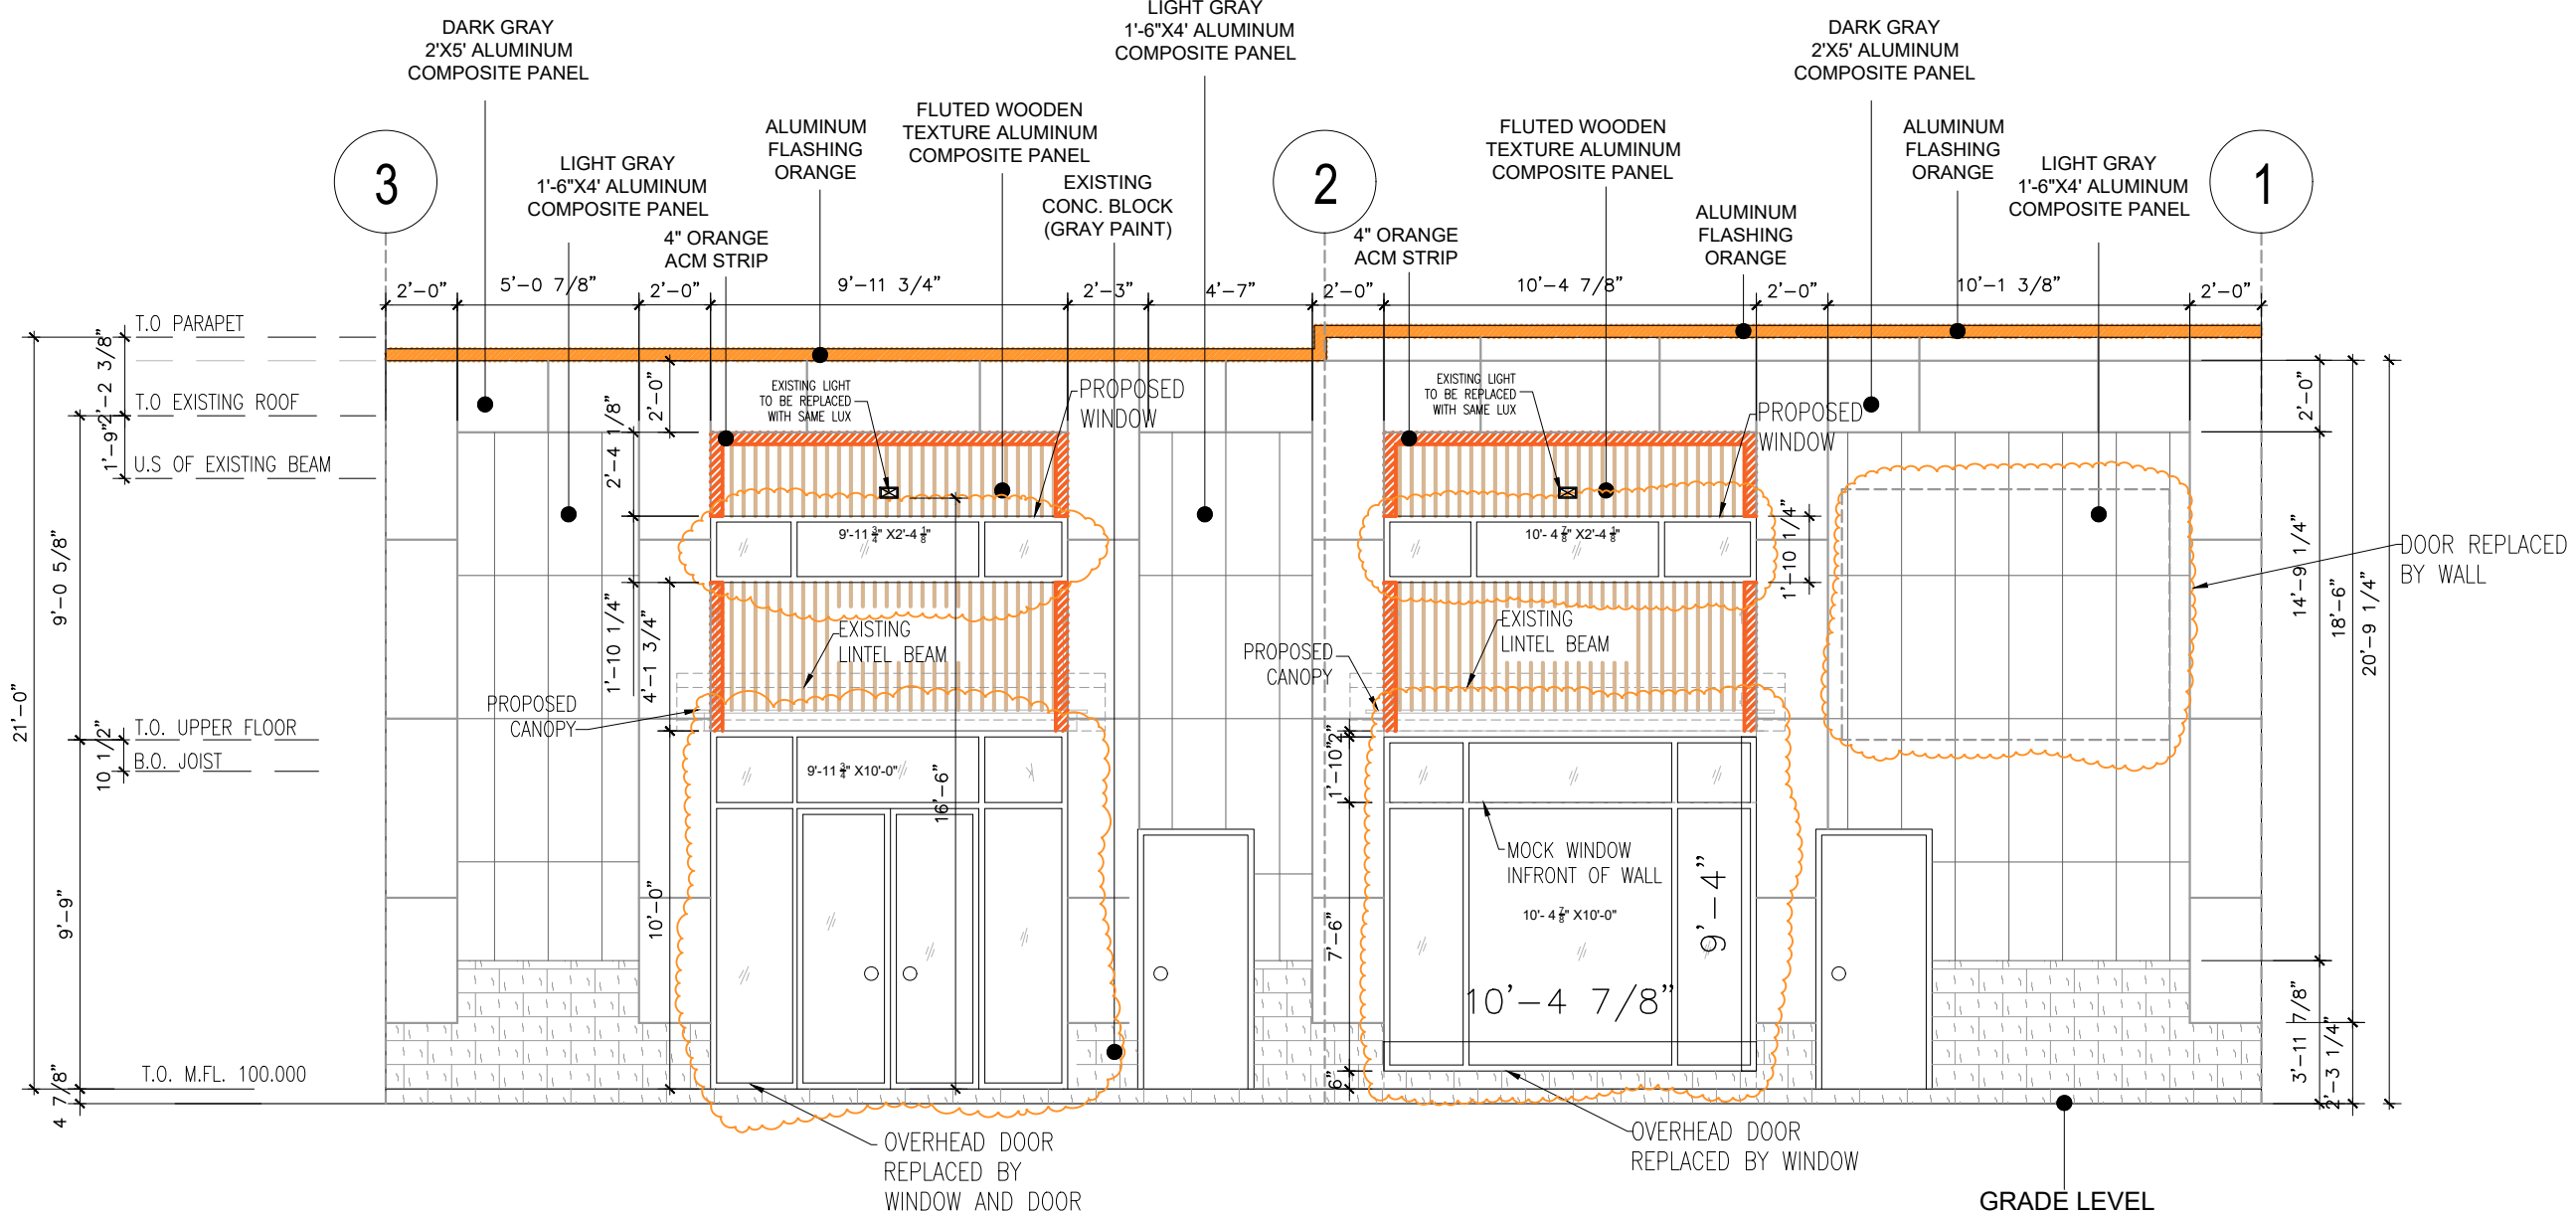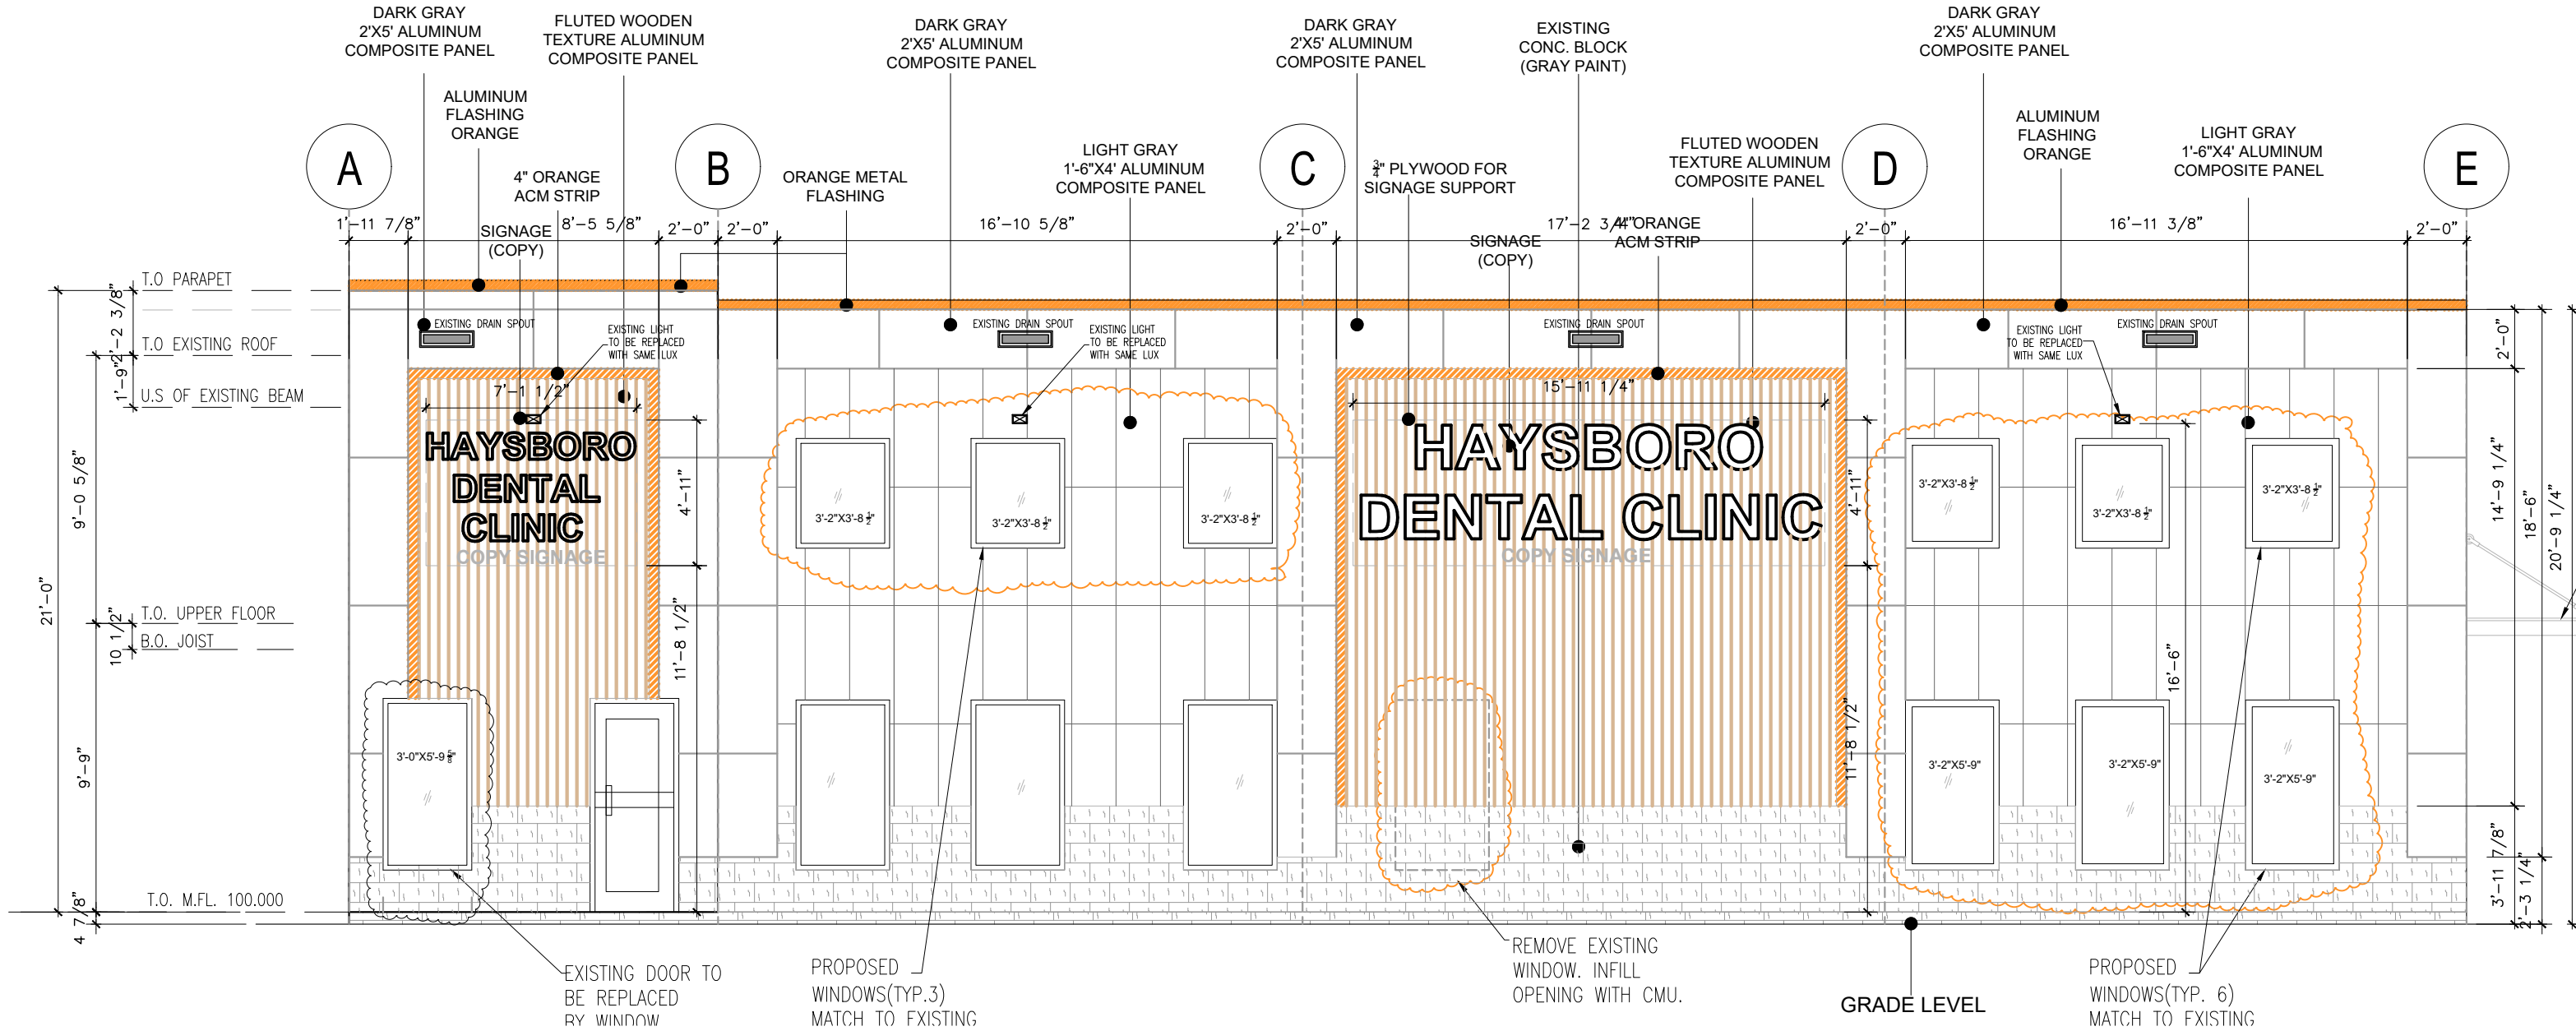




2 VIEW 1
DP4.0



3 VIEW 2
DP4.0



4 VIEW 3
DP4.0

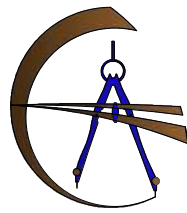

KA ASSOCIATES INC.

RESIDENTIAL COMMERCIAL & INTERIOR

04-3516, 26 ST NE, CALGARY,
AB T1Y 4T7
T: 403 889 6836, 403 800 6820
E-Mail: khalid@kaaa.ca
Website: kaarc.ca

CONSULTANTS

SCOPE OF WORK:
-2ND FLOOR ADDITION(INDOOR)
-MINOR CHANGES TO ELEVATIONS
-NO SITE PLAN CHANGES EXCEPT
LABBLED PARKING

NOTE:
CONTRACTOR MUST READ ALL
DRAWINGS AND VISIT SITE TO
CONFIRM ALL EXISTING DIMENSIONS
BEFORE START CONSTRUCTION AND
CONTACT DESIGNER IF ANY ERROR
IN DRAWING OR EXISTING SITE
CONDITION

CLIENT:

COPYRIGHT:

THESE DRAWINGS ARE THE
PROPERTY OF KA ASSOCIATES
INC.ALL RIGHTS RESERVED,
INCLUDING THE RIGHT OF
REPRODUCTION, IN WHOLE OR IN
PART OR ANY FORM WITHOUT
THE WRITTEN PERMISSION OF KA
ASSOCIATES INC.

PROJECT:

HAYSBORO DENTAL
BUILDING ALTERATION

CIVIC ADDRESS:

9504 HORTON ROAD S.W. CALGARY

LEGAL ADDRESS:

LOT 6 BLOCK 9 PLAN 931 1963

REVISIONS:

NO.	DATE	DESCRIPTION
11		
10		
09		
08		
07		
06	28-07-26	ISSUED FOR DP
05	21-07-26	FOR CLIENT REVIEW
04	02-07-26	FOR CLIENT REVIEW
03	12-06-26	FOR CLIENT REVIEW
02	15-05-26	AS-BUILT DRAWING
01	07-05-26	START

PROJECT NO:	KAAC2605
CAD DWG FILE:	0504 HAYSBORO DENTAL_DP.DWG
DRAWN BY:	BS
CHK'D BY:	KA
DRAWING TITLE	

SECTION & 3D VIEWS

DRG. NO:

DP4.0