




26 TH STREET N.E

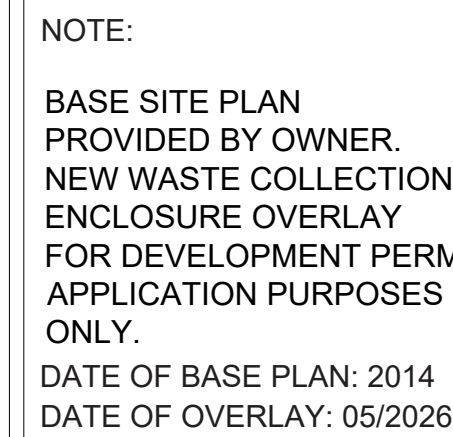

general notes

AS-BUILT SITE PLAN
WASTE COLLECTION
ENCLOSURE

RETROACTIVE DEVELOPMENT
PERMIT APPLICATION

2750 SUNRIDGE BLVD NE,
CALGARY, AB
T1Y 3C2,

EMERALD HOTEL & SUITES
CALGARY AIRPORT

[illegible]

proj arch	proj mgr	proj date num
--------------	-------------	------------------

EMERALD HOTEL & SUITES
CALGARY AIRPORT

SITE PLAN

A0.1



WRITTEN DIMENSIONS ON THESE DRAWINGS SHALL HAVE PRECEDENCE OVER SCALED DIMENSIONS. CONTRACTORS SHALL VERIFY, AND BE RESPONSIBLE FOR ALL DIMENSIONS AND CONDITIONS ON THE JOB. THE DRAFTER MUST BE NOTIFIED OF VARIATIONS FROM THE DIMENSIONS AND CONDITIONS SHOWN BY THESE DRAWINGS.

WRITTEN DIMENSIONS ON THESE DRAWINGS SHALL HAVE PRECEDENCE OVER SCALED DIMENSIONS. CONTRACTORS SHALL VERIFY, AND BE RESPONSIBLE FOR ALL DIMENSIONS AND CONDITIONS ON THE JOB. THE DRAFTER MUST BE NOTIFIED OF VARIATIONS FROM THE DIMENSIONS AND CONDITIONS SHOWN BY THESE DRAWINGS.

general notes

RETROACTIVE DEVELOPMENT
PERMIT APPLICATION

2750 SUNRIDGE BLVD NE,
CALGARY, AB
T1Y 3C2,

EMERALD HOTEL & SUITES
CALGARY AIRPORT

[illegible]

proj date
proj num
proj mgr
proj arch

EMERALD HOTEL & SUITES
CALGARY AIRPORT

GARBAGE ENCLOSURE DETAIL

A0.2

[illegible]

1 SITE PLAN
A01 SCALE = 1:300