


ALBERTA LAND SURVEYOR'S REAL PROPERTY REPORT

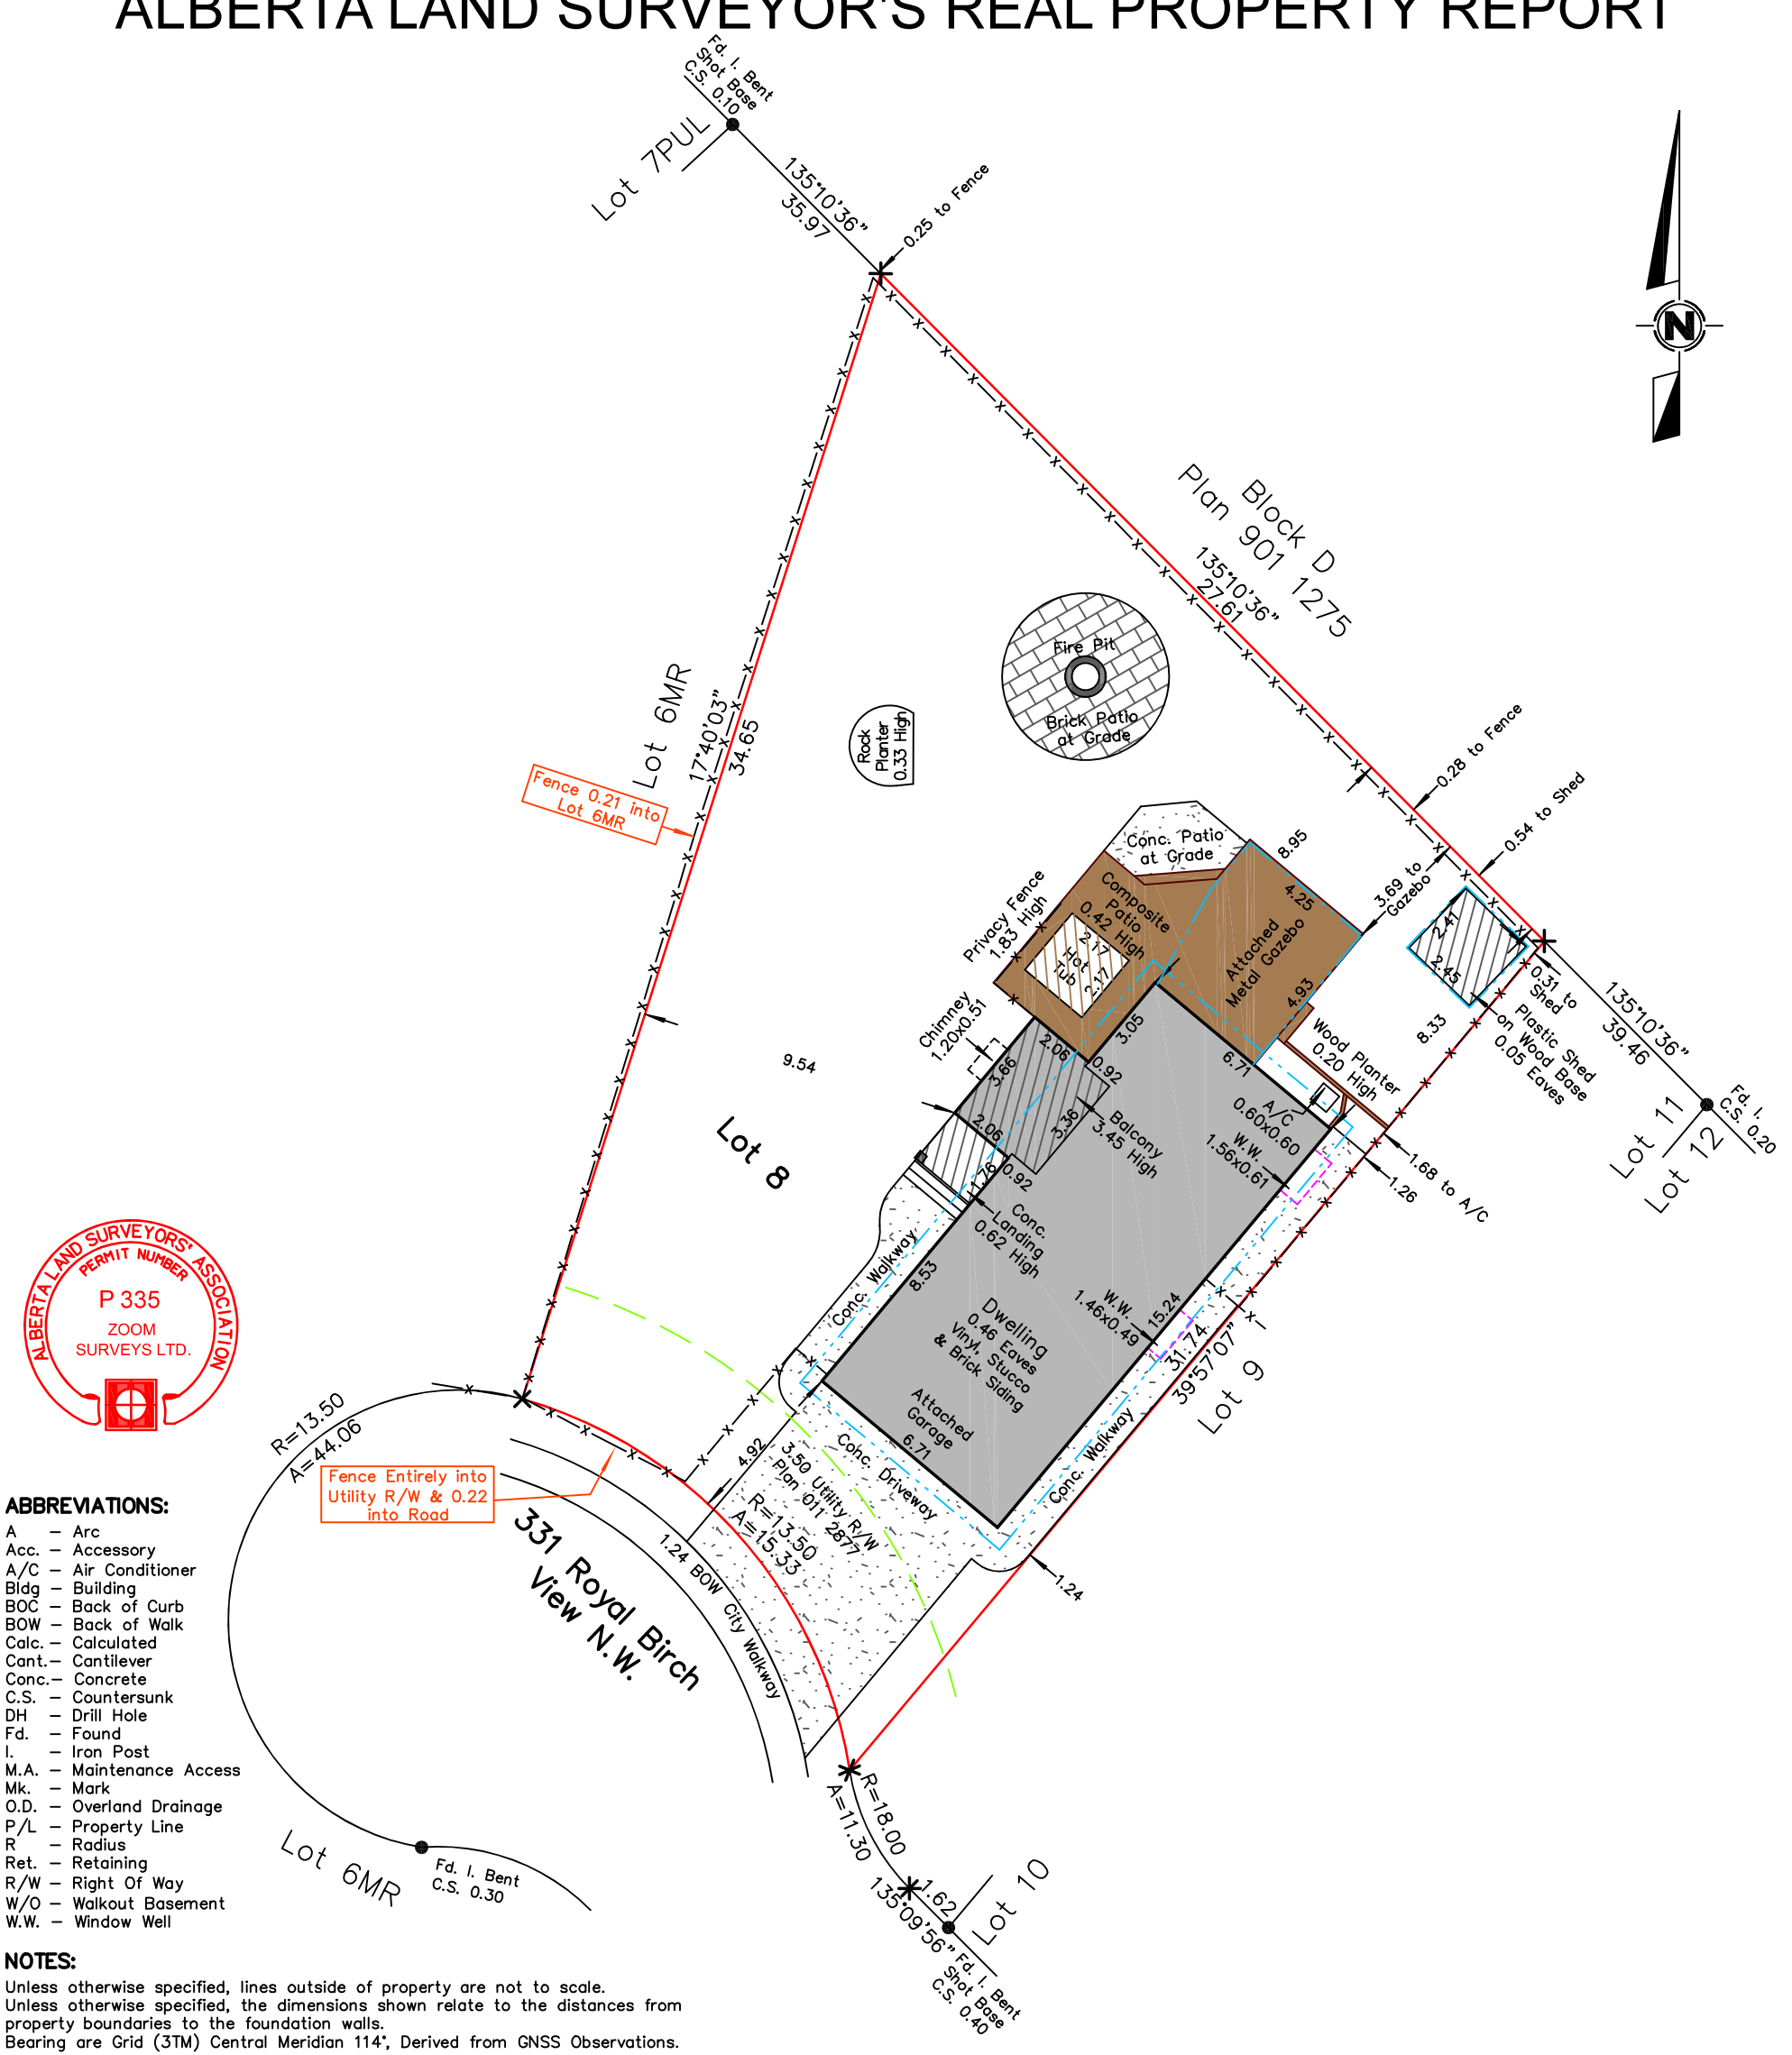


LEGAL DESCRIPTION:
Lot 8, Block 1, Plan 011 2876

MUNICIPAL ADDRESS:
331 Royal Birch View N.W.
Calgary, Alberta

DATE OF SURVEY: August 7, 2026.

Title information is based on the certificate of title 071 554 922
Which was searched on July 28, 2026.
The property is subject to the following instruments:
Utility Right of Way No.: 011 309 405
Caveat No.: 011 309 406

Dated at Calgary, Alberta on August 11, 2026.

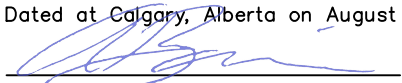
ADAM BARVIR, ALBERTA LAND SURVEYOR
© COPYRIGHT, ZOOM SURVEYS LTD. 2026
This document is not valid unless it bears an original or digital signature in blue ink and a Zoom Surveys Ltd. permit stamp in red ink.

LEGEND:

All distances are in metres and decimals thereof.

Found iron posts --- ● ---
Calculation points --- X ---
Beginning of curves --- | ---
Pillars and posts --- ■ ---
Subject property lines --- ---
Right of ways --- ---
Eaves --- ---
Fences --- x ---

All eaves are measured to fascia unless otherwise shown.
All fences are within 0.2 metres of the property lines unless otherwise shown.

CERTIFICATION:

I, Adam Barvir, hereby certify that this report, which includes the attached plan and related survey, was prepared and performed under my supervision, direction, and control and in accordance with standards and rules for the practice of surveying prescribed by the Alberta Land Surveyors' Association. Accordingly, within those standards and as of the date of this report, I am of the opinion that:

- The plan illustrates the boundaries of the subject Property, the improvements as defined in Part C, Section 6.5 of the Alberta Land Surveyors' Association's Manual of Standard Practice, and the defined limits of registered interests affecting the extent of the title to the subject property.
- The improvements are entirely within the boundaries of the subject property.
Except Fence
- No visible improvements situated on an adjoining property cross the boundaries of the subject property.
- No visible improvements exist within the limits of any registered interests affecting the extent of the subject property.
Except Fence

PURPOSE:

This report and attached plan have been prepared for the benefit of the property owner, subsequent owners and any of their agents for the purpose of a land conveyance, a mortgage application, or a submittal to the municipality for the compliance certificate, etc. Copying is permitted only for the benefit of these parties, and only if the plan remains attached.

Where applicable, registered easements and utility rights of way affecting the extent of the property have been shown on the attached plan. Unless shown otherwise, property corner markers have not been placed during the survey for this report.

The attached plan should not be used to establish boundaries due to the risk of misinterpretation or measurement error by the user.

The information shown on this report reflects the status of this property as of the date of survey only. Users are encouraged to have the Real Property Report updated for future requirements because subsequent development changes on the property will not be reflected on the report.



2819A Centre Street N.W.
Calgary, Alberta T2E 2V7
Phone: 403-837-8599
E-mail: office@zoomsurveys.ca
Website: www.zoomsurveys.ca

Job No.: 26-0571	Scale: 1:200	Surveyed: DN	Drawn: AK
------------------	--------------	--------------	-----------