
DEVELOPMENT PERMIT DECISION RENDERED ON THIS PLAN

Emerald Hotel & Suites Calgary Airport

26 TH STREET N.E

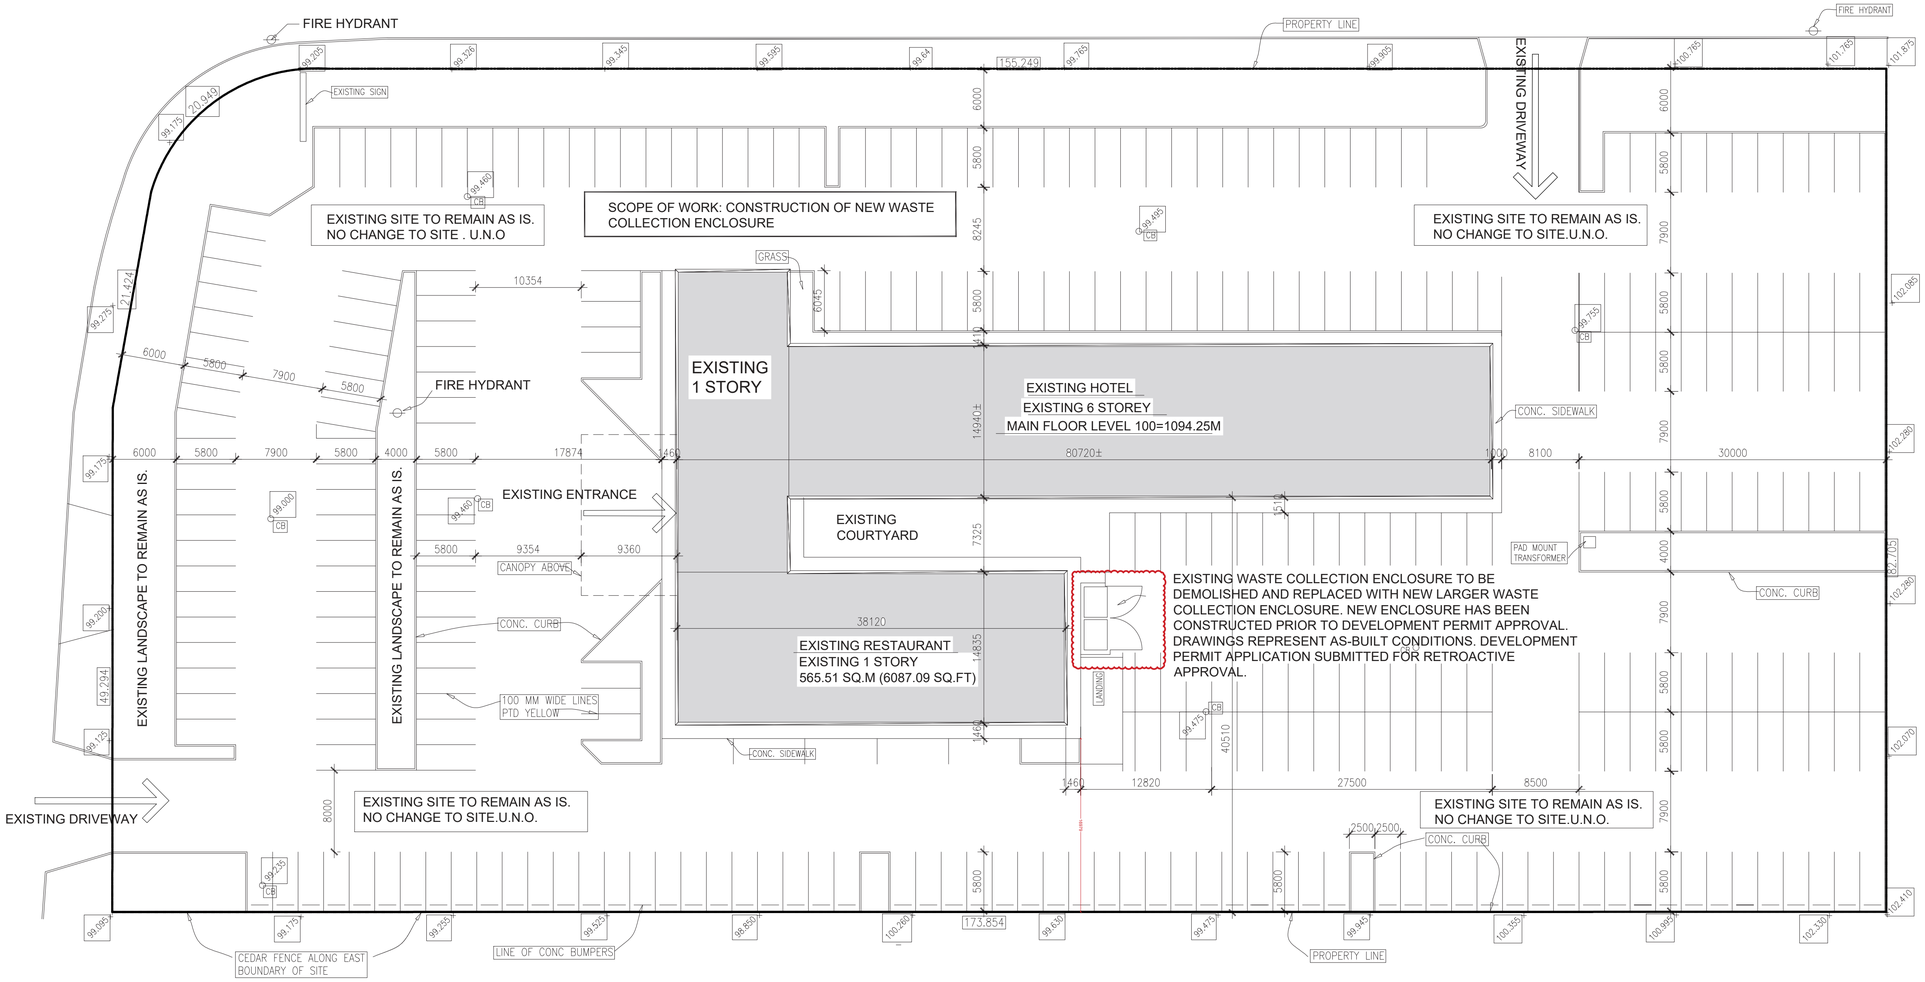

27 TH AVENUE N.E.

1 / A01 SITE PLAN
SCALE = 1:300

NOTE:

BASE SITE PLAN PROVIDED BY OWNER.
NEW WASTE COLLECTION ENCLOSURE OVERLAY FOR DEVELOPMENT PERMIT APPLICATION PURPOSES ONLY.
DATE OF BASE PLAN: 2014
DATE OF OVERLAY: 05/2026

general notes

WRITTEN DIMENSIONS ON THESE DRAWINGS SHALL HAVE PRECEDENCE OVER SCALED DIMENSIONS. CONTRACTORS SHALL VERIFY, AND BE RESPONSIBLE FOR ALL DIMENSIONS AND CONDITIONS ON THE JOB. THE DRAFTER MUST BE NOTIFIED OF VARIATIONS FROM THE DIMENSIONS AND CONDITIONS SHOWN BY THESE DRAWINGS.

AS-BUILT SITE PLAN
WASTE COLLECTION ENCLOSURE

RETROACTIVE DEVELOPMENT PERMIT APPLICATION

2750 SUNRIDGE BLVD NE,
CALGARY, AB
T1Y 3C2,

EMERALD HOTEL & SUITES
CALGARY AIRPORT

revision history

	description	date
1		
2		
3		
4		
5		

revision history

	date
client review	
plan check	
bidding	
construction	

proj arch
proj mgr
proj num
proj date

EMERALD HOTEL & SUITES
CALGARY AIRPORT
CLIENT: [redacted]

SITE PLAN


A0.1

DEVELOPMENT PERMIT DECISION RENDERED ON THIS PLAN

W S N E

Emerald Hotel & Suites Calgary Airport

26 TH STREET N.E

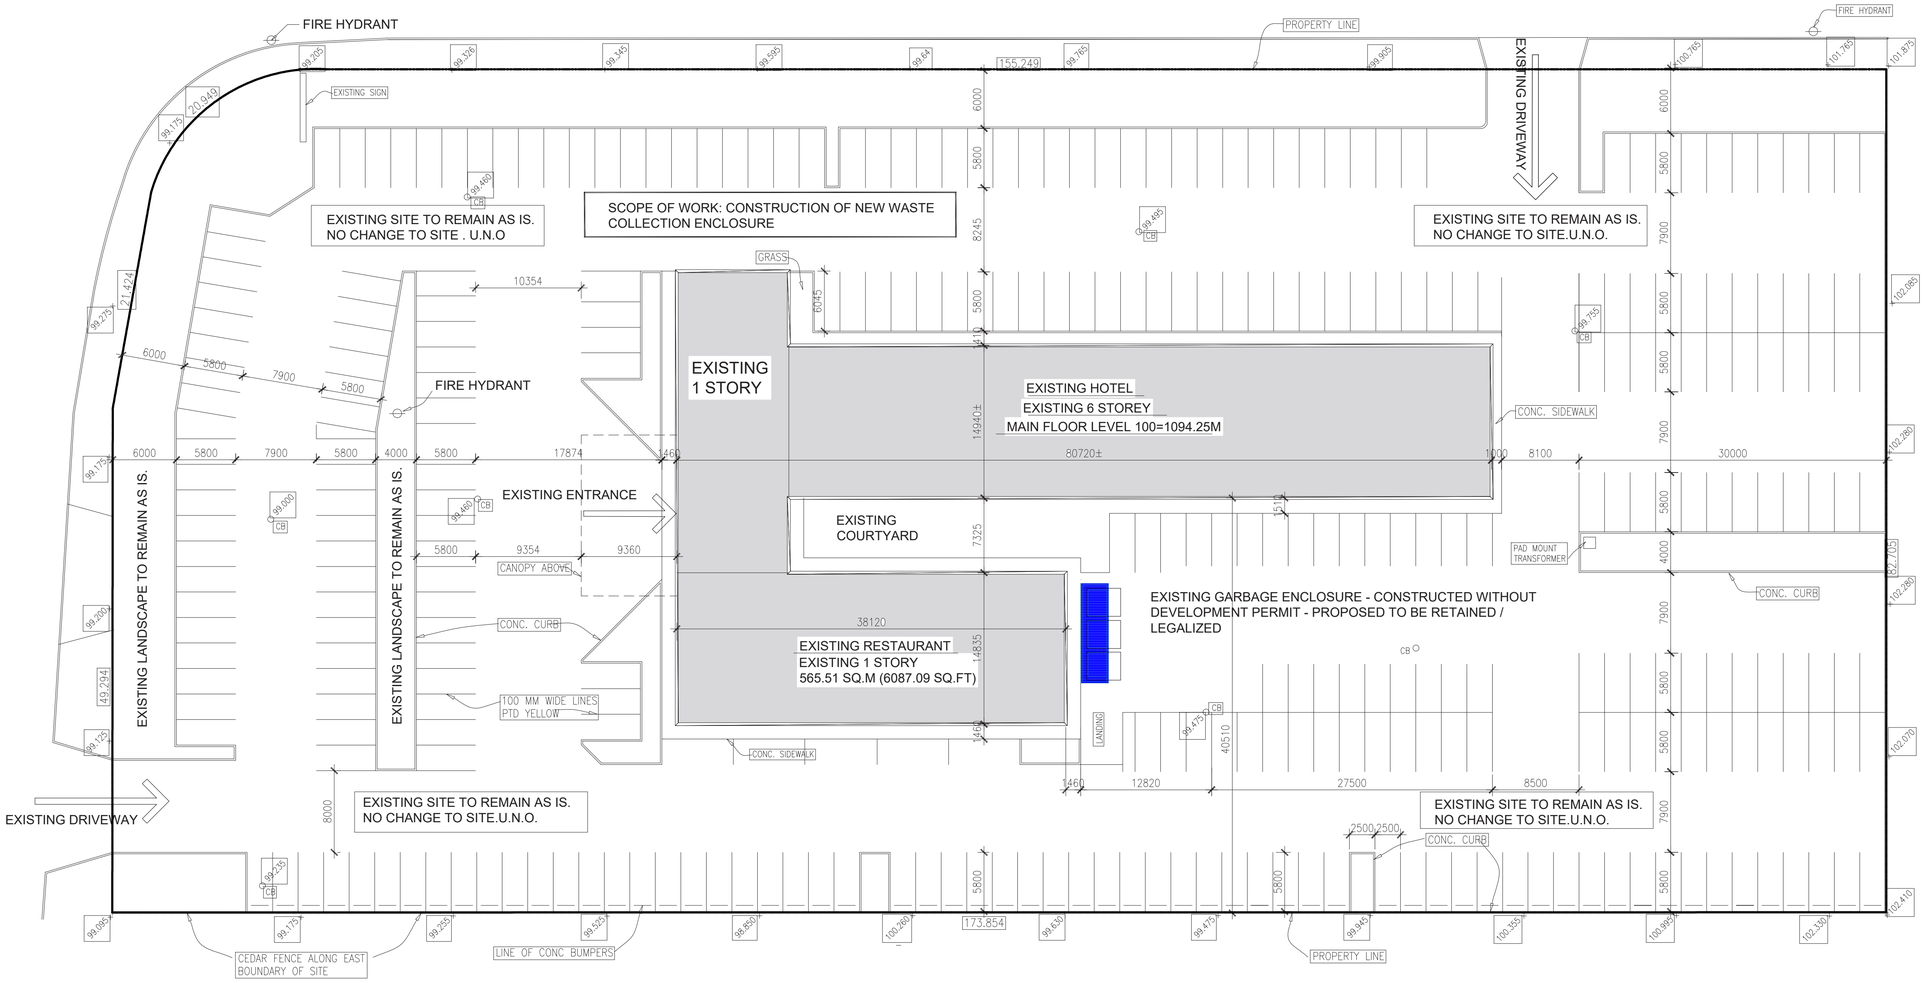

1 A01 SITE PLAN
SCALE = 1:300

NOTE:

BASE SITE PLAN PROVIDED BY OWNER.
NEW WASTE COLLECTION ENCLOSURE OVERLAY FOR DEVELOPMENT PERMIT APPLICATION PURPOSES ONLY.
DATE OF BASE PLAN: 2014
DATE OF OVERLAY: 05/2026

general notes

WRITTEN DIMENSIONS ON THESE DRAWINGS SHALL HAVE PRECEDENCE OVER SCALED DIMENSIONS. CONTRACTORS SHALL VERIFY, AND BE RESPONSIBLE FOR ALL DIMENSIONS AND CONDITIONS ON THE JOB. THE DRAFTER MUST BE NOTIFIED OF VARIATIONS FROM THE DIMENSIONS AND CONDITIONS SHOWN BY THESE DRAWINGS.

AS-BUILT SITE PLAN
WASTE COLLECTION ENCLOSURE

RETROACTIVE DEVELOPMENT PERMIT APPLICATION

2750 SUNRIDGE BLVD NE,
CALGARY, AB
T1Y 3C2,

EMERALD HOTEL & SUITES CALGARY AIRPORT

revision history

	description	date
1		
2		
3		
4		
5		

revision history


	date
client review	
plan check	
bidding	
construction	

proj date
proj num
proj mgr
arch

EMERALD HOTEL & SUITES
CALGARY AIRPORT
CLIENT: [redacted]


GARBAGE ENCLOSURE DETAIL

A0.2

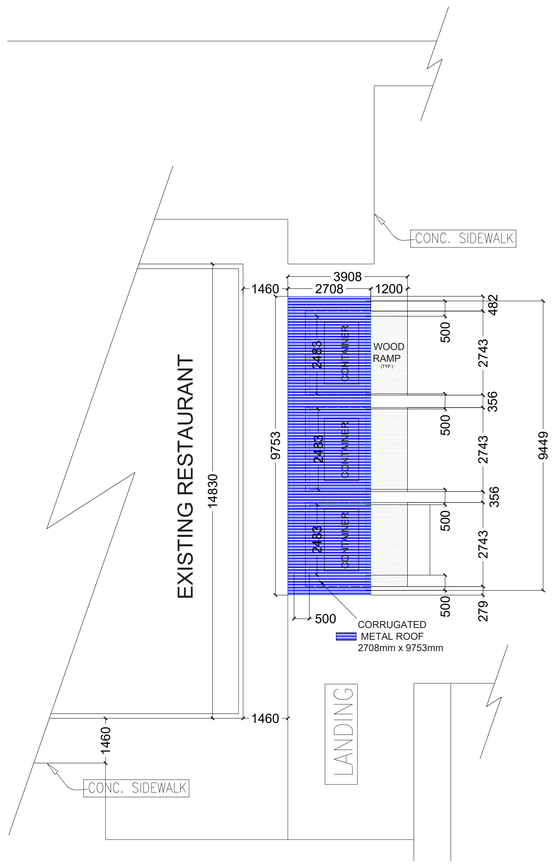


GARBAGE ENCLOSURE - PLAN VIEW

SCALE: 1:100

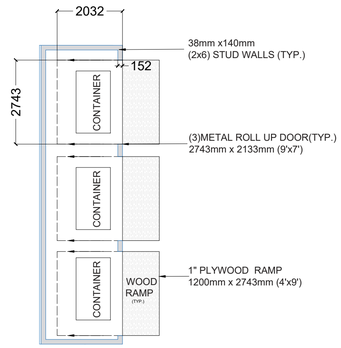

PLAN DETAIL

SCALE: 1:100

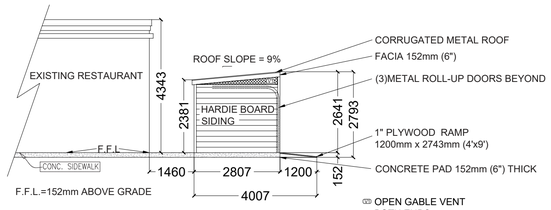


EAST ELEVATION

SCALE: 1:100

- OPEN GABLE VENT
  BOTH ENDS
  NATURAL CROSS
  VENTILATION (TYP.)
  OPEN GABLE EACH END
  (0.32m²)(3.45 SQ FT)
  COMBINED BOTH
  ENDS=0.64m²/6.9 SQ.FT

GARBAGE ENCLOSURE
INTERIOR VOLUME
FLOOR AREA = 27.39m²
(294.8 SQ FT)
INTERIOR VOLUME =
68.78m³ (2,429 CU FT)
AVERAGE CEILING HEIGHT
= 2.511m (8'3")"
BIRD SCREEN TO BE PROVIDED

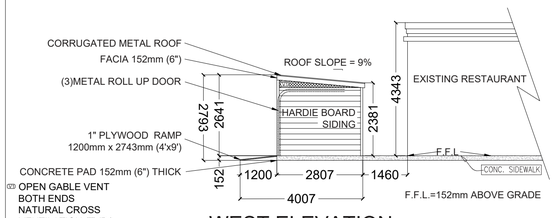


WEST ELEVATION

SCALE: 1:100


- OPEN GABLE VENT
  BOTH ENDS
  NATURAL CROSS
  VENTILATION (TYP.)
  OPEN GABLE EACH END
  (0.32m²)(3.45 SQ FT)
  COMBINED BOTH
  ENDS=0.64m²/6.9 SQ.FT

GARBAGE ENCLOSURE
INTERIOR VOLUME
FLOOR AREA = 27.39m²
(294.8 SQ FT)
INTERIOR VOLUME =
68.78m³ (2,429 CU FT)
AVERAGE CEILING HEIGHT
= 2.511m (8'3")"
BIRD SCREEN TO BE PROVIDED

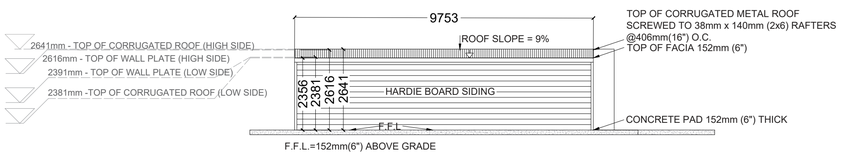

NORTH ELEVATION

SCALE: 1:100

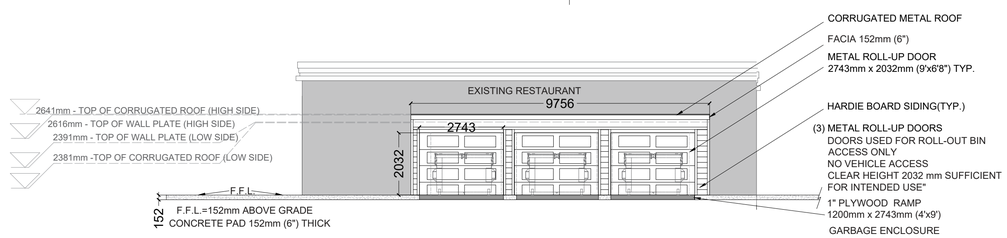


SOUTH ELEVATION

SCALE: 1:100

WASTE COLLECTION ENCLOSURE

SCALE: 1:100

DEVELOPMENT PERMIT DECISION RENDERED ON THIS PLAN

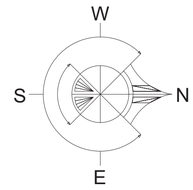

NOTE:

BASE SITE PLAN PROVIDED BY OWNER. NEW WASTE COLLECTION ENCLOSURE OVERLAY FOR DEVELOPMENT PERMIT APPLICATION PURPOSES ONLY.

DATE OF BASE PLAN: 2014

DATE OF OVERLAY: 05/2026

NOTES:

NO ELECTRICAL SERVICE PROVIDED
NO PLUMBING OR MECHANICAL SERVICE PROVIDED
NATURAL VENTILATION VIA OPEN GABLE VENTS BOTH ENDS
STRUCTURE IS EXISTING — PROPOSED TO BE RETAINED
ALL DIMENSIONS ARE TO FACE OF STUD UNLESS NOTED
CONTRACTOR TO VERIFY ALL DIMENSIONS ON SITE

general notes

WRITTEN DIMENSIONS ON THESE DRAWINGS SHALL HAVE PRECEDENCE OVER SCALED DIMENSIONS. CONTRACTORS SHALL VERIFY, AND BE RESPONSIBLE FOR ALL DIMENSIONS AND CONDITIONS ON THE JOB. THE DRAFTER MUST BE NOTIFIED OF VARIATIONS FROM THE DIMENSIONS AND CONDITIONS SHOWN BY THESE DRAWINGS.

AS-BUILT SITE PLAN
WASTE COLLECTION ENCLOSURE

RETROACTIVE DEVELOPMENT PERMIT APPLICATION

2750 SUNRIDGE BLVD NE,
CALGARY, AB
T1Y 3C2,

EMERALD HOTEL & SUITES
CALGARY AIRPORT

revision history

	description	date
1		
2		
3		
4		
5		

revision history

	date
client review	
plan check	
bidding	
construction	

proj date
proj num
proj mgr
proj arch

EMERALD HOTEL & SUITES
CALGARY AIRPORT
CLIENT: [redacted]

DETAILS

A0.3