

NEW ACCESSORY BUILDING CONSTRUCTION/RENOVATION
236 ASPEN MEADOWS PLACE SW, CALGARY

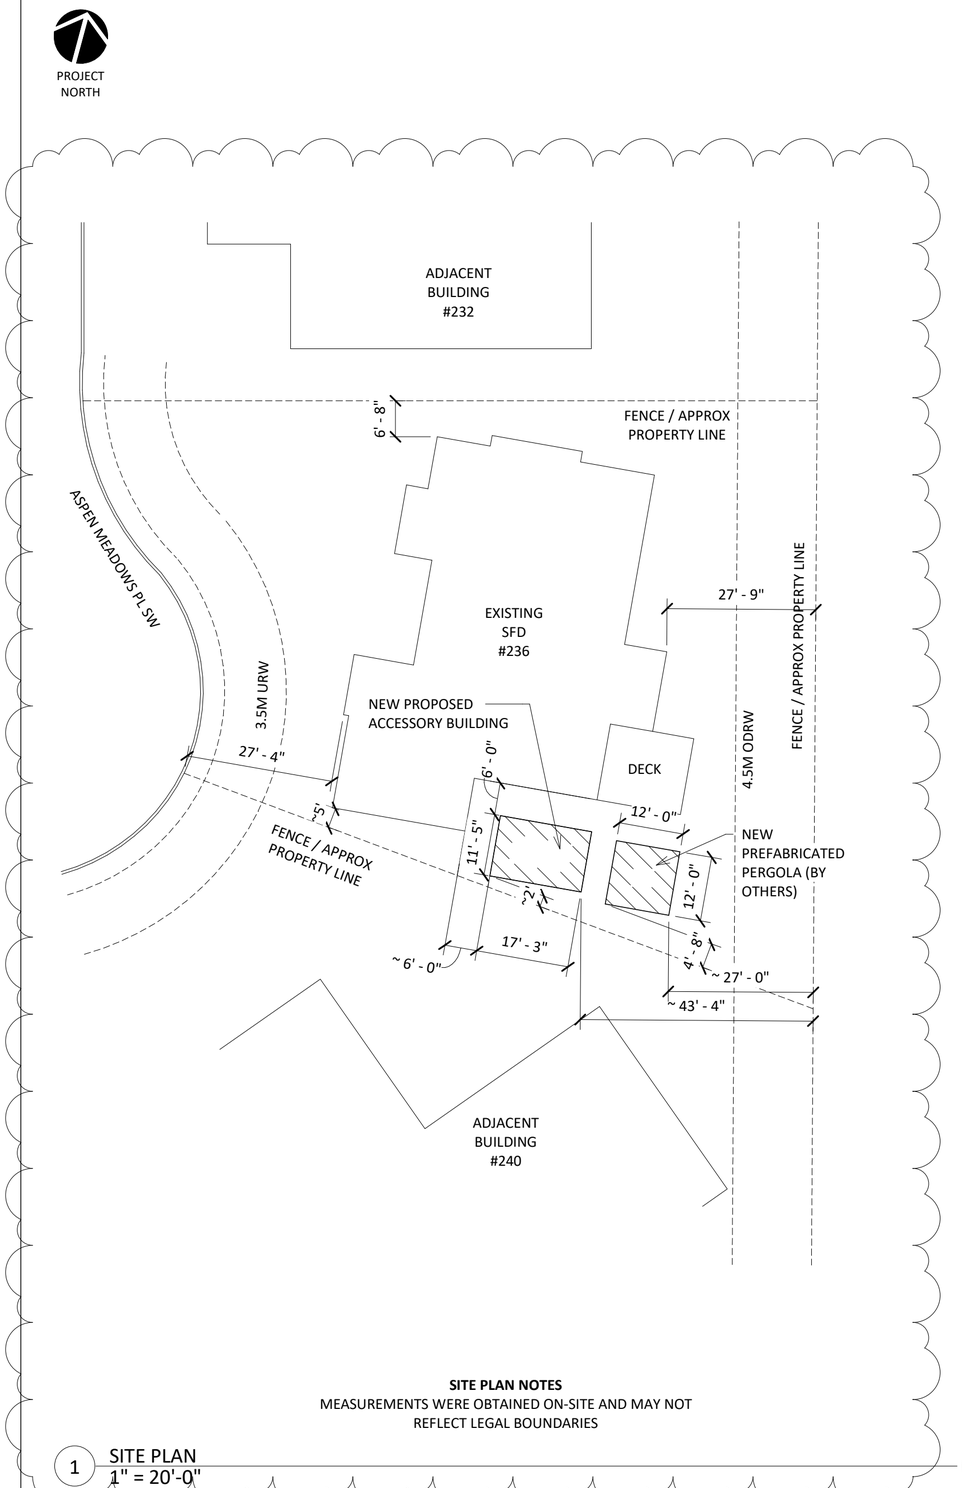

SITE PLAN NOTES
MEASUREMENTS WERE OBTAINED ON-SITE AND MAY NOT REFLECT LEGAL BOUNDARIES

1 SITE PLAN
1" = 20'-0"



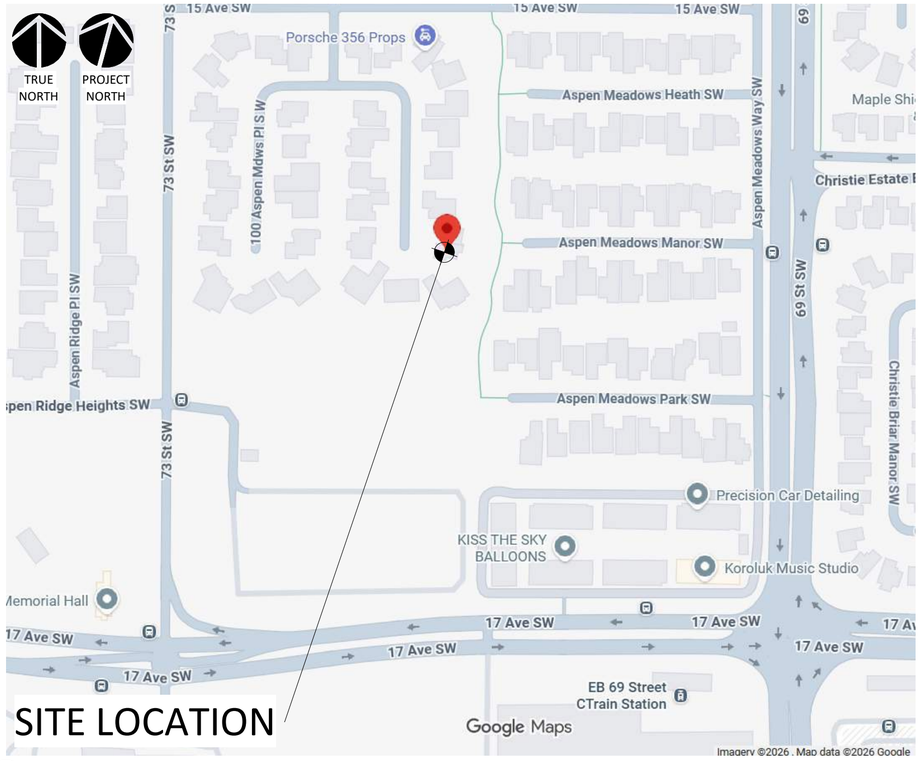

2 LOCATION MAP
NTS

SHEET LIST	
SHEET #	**SHEET NAME**
0.01	TITLE SHEET
0.02	PROJECT NOTES
4.11	RENOVATION PLANS
4.12	RENOVATION PLANS
4.13	RENOVATION PLANS
4.21	RENOVATION ELEVATIONS
4.51	RENOVATION SCHEDULES
4.71	RENOVATION SECTIONS AND DETAILS
6.01	GENERAL NOTES
6.02	GENERAL NOTES

ELEMENT FORENSIC ENGINEERING
PHONE: 905.436.5758 | 403.462.4335
EMAIL: ELEMENT@ELEMENTFE.CA
BURLINGTON | CAMBRIDGE | OSHAWA | CALGARY

- ALL DRAWINGS AND RELATED DOCUMENTS ARE COPYRIGHT PROPERTY. THEY MAY NOT BE REPRODUCED, ALTERED OR REUSED WITHOUT THE EXPRESSED WRITTEN CONSENT OF ELEMENT FORENSIC ENGINEERING.
- CONTRACTOR MUST CHECK AND VERIFY ALL DIMENSIONS AND BE RESPONSIBLE FOR THE SAME, REPORTING ANY DISCREPANCIES TO ELEMENT FORENSIC ENGINEERING PRIOR TO COMMENCEMENT OF WORK.
- LATEST APPROVED DRAWINGS GOVERN CONSTRUCTION.
- DO NOT SCALE DRAWINGS. DRAWINGS SHALL BE PRINTED IN COLOUR.

PERMIT TO PRACTICE
ELEMENT FORENSIC ENGINEERING INC.
RM SIGNATURE:
RM APEGA ID #: 32580
DATE: September 2, 2026
PERMIT NUMBER: P016549
The Association of Professional Engineers and Geoscientists of Alberta (APEGA)

PROFESSIONAL ENGINEER ALBERTA
LIAM N. CLUNE
ID 325840

DRAWINGS ARE SEALED FOR DESIGN PERTAINING THE RESTORATION OF LOSS RELATED DAMAGE AND ANY NOTED ALTERATION FROM THE AS-BUILT CONDITION. ELEMENT FORENSIC ENGINEERING HAS NOT CONDUCTED A DETAILED REVIEW OR REVERSE ENGINEERING ANALYSIS OF THE BUILDING FOR CONFORMITY WITH THE BUILDING CODE NOR THE LOCAL MUNICIPAL BYLAWS. AS A RESULT CANNOT BE HELD LIABLE OR RESPONSIBLE FOR THIS INFORMATION.

REV.	DATE	DESCRIPTION
1	MAY 29/26	ISSUED FOR CLIENT REVIEW
2	JUN 2/26	REVISION
3	AUG 7/26	ISSUED FOR CLIENT REVIEW
4	AUG 10/26	ISSUED FOR CLIENT REVIEW
5	AUG 17/26	ISSUED FOR PERMIT
6	AUG 26/26	REVISION
7	SEP 2/26	REVISION


ADDRESS
236 ASPEN MEADOWS PL SW, CALGARY, AB

FILE
2511-0505-NI

CLIENT
FELDMAN

SHEET
0.01


TITLE
TITLE SHEET

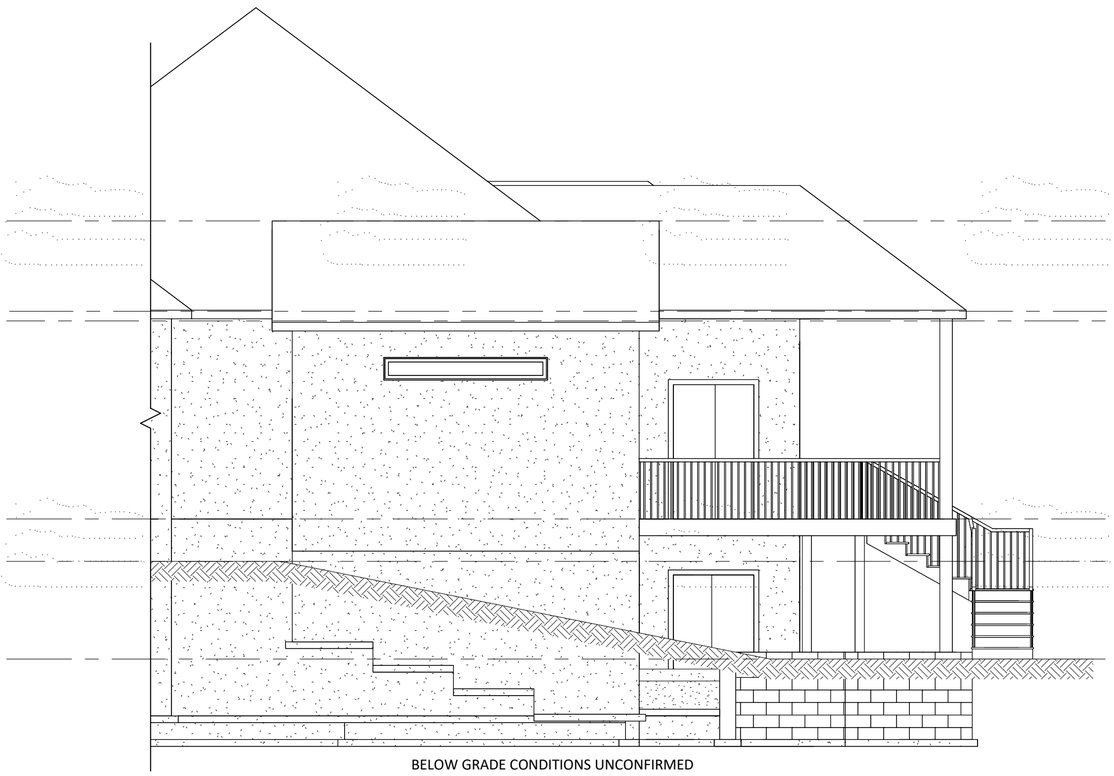


1 RENOVATION ELEVATION - SOUTH
3/16" = 1'-0"



2 RENOVATION ELEVATION - EAST
3/16" = 1'-0"

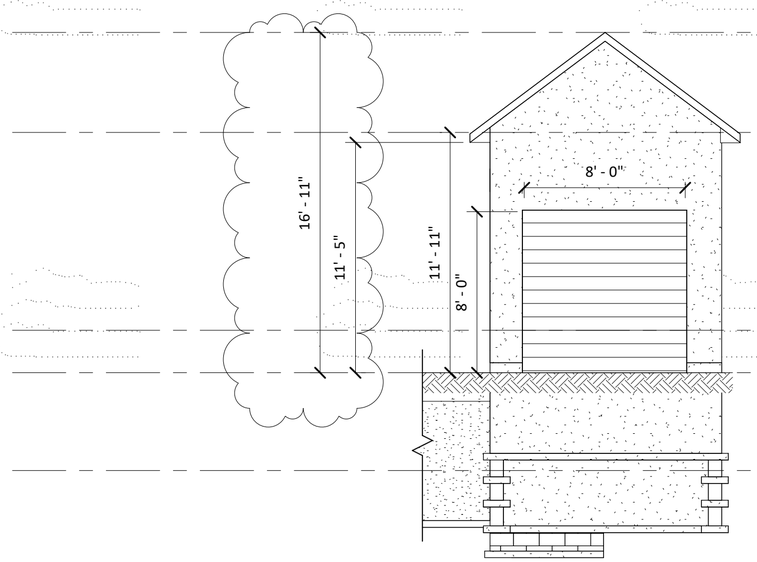

3 RENOVATION ELEVATION - WEST
3/16" = 1'-0"

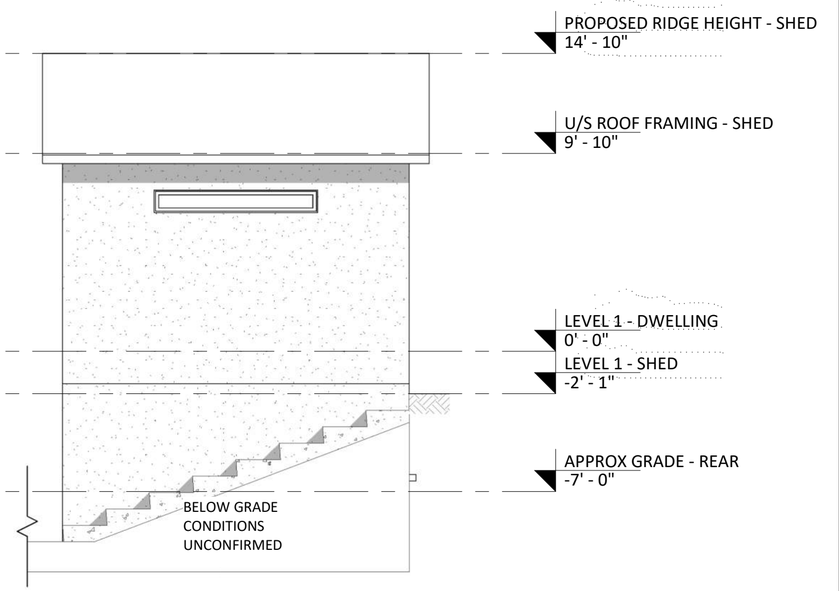

4 RENOVATION ELEVATION - NORTH
3/16" = 1'-0"

ELEMENT
FORENSIC ENGINEERING
PHONE: 905.436.5758 | 403.462.4335
EMAIL: ELEMENT@ELEMENTFE.CA
BURLINGTON | CAMBRIDGE | OSHAWA | CALGARY

- ALL DRAWINGS AND RELATED DOCUMENTS ARE COPYRIGHT PROPERTY. THEY MAY NOT BE REPRODUCED, ALTERED OR REUSED WITHOUT THE EXPRESSED WRITTEN CONSENT OF ELEMENT FORENSIC ENGINEERING.
- CONTRACTOR MUST CHECK AND VERIFY ALL DIMENSIONS AND BE RESPONSIBLE FOR THE SAME, REPORTING ANY DISCREPANCIES TO ELEMENT FORENSIC ENGINEERING PRIOR TO COMMENCEMENT OF WORK.
- LATEST APPROVED DRAWINGS GOVERN CONSTRUCTION.
- DO NOT SCALE DRAWINGS. DRAWINGS SHALL BE PRINTED IN COLOUR.

PERMIT TO PRACTICE
ELEMENT FORENSIC ENGINEERING INC.
RM SIGNATURE: *Liam Cline*
RM APEGA ID #: 32580
DATE: September 2, 2026
PERMIT NUMBER: P016549
The Association of Professional Engineers and Geoscientists of Alberta (APEGA)

PROFESSIONAL ENGINEER ALBERTA
LIAM N. CLINE
ID 325840

DRAWINGS ARE SEALED FOR DESIGN PERTAINING THE RESTORATION OF LOSS RELATED DAMAGE AND ANY NOTED ALTERATION FROM THE AS-BUILT CONDITION. ELEMENT FORENSIC ENGINEERING HAS NOT CONDUCTED A DETAILED REVIEW OR REVERSE ENGINEERING ANALYSIS OF THE BUILDING FOR CONFORMITY WITH THE BUILDING CODE NOR THE LOCAL MUNICIPAL BYLAWS. AS A RESULT CANNOT BE HELD LIABLE OR RESPONSIBLE FOR THIS INFORMATION.

REV.	DATE	DESCRIPTION
1	MAY 29/26	ISSUED FOR CLIENT REVIEW
2	JUN 2/26	REVISION
3	AUG 7/26	ISSUED FOR CLIENT REVIEW
4	AUG 10/26	ISSUED FOR CLIENT REVIEW
5	AUG 17/26	ISSUED FOR PERMIT
6	AUG 26/26	REVISION
7	SEP 2/26	REVISION

ADDRESS
236 ASPEN MEADOWS PL SW, CALGARY, AB

FILE
2511-0505-NI

CLIENT
FELDMAN

SHEET
4.21

TITLE
RENOVATION ELEVATIONS