
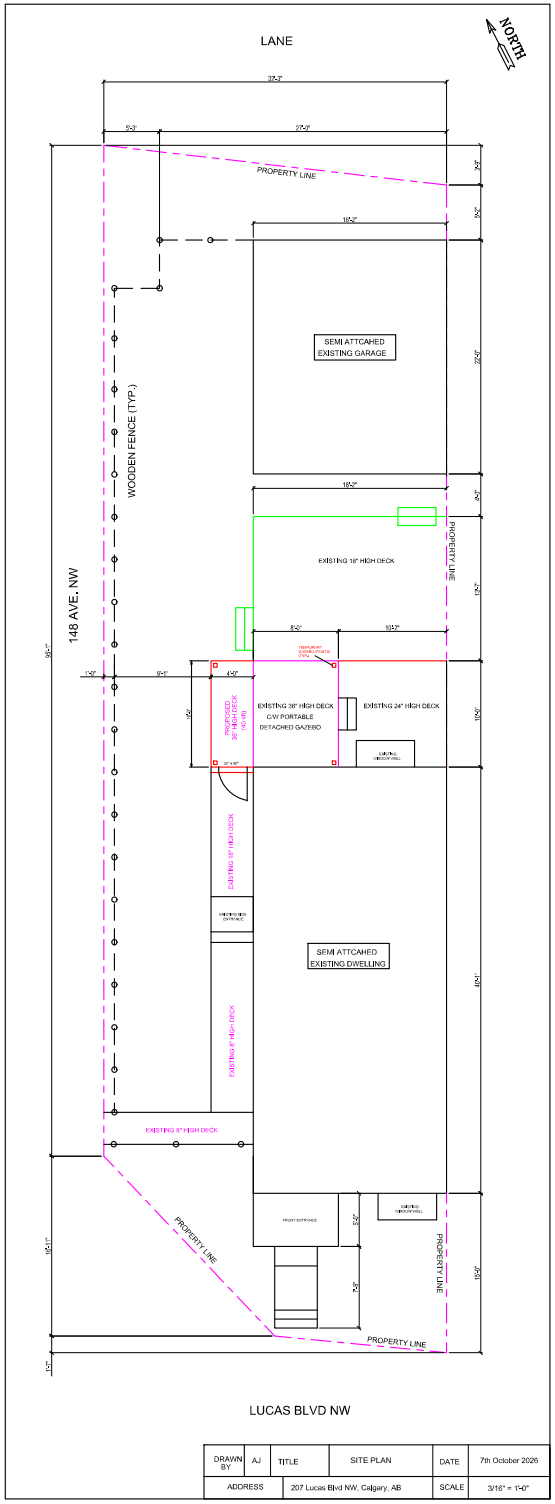


DRAWN BY	AJ	TITLE	SITE PLAN	DATE	7th October 2026
ADDRESS		207 Lucas Blvd NW, Calgary, AB		SCALE	3/16" = 1'-0"

TITANIUM PLUS SPEC

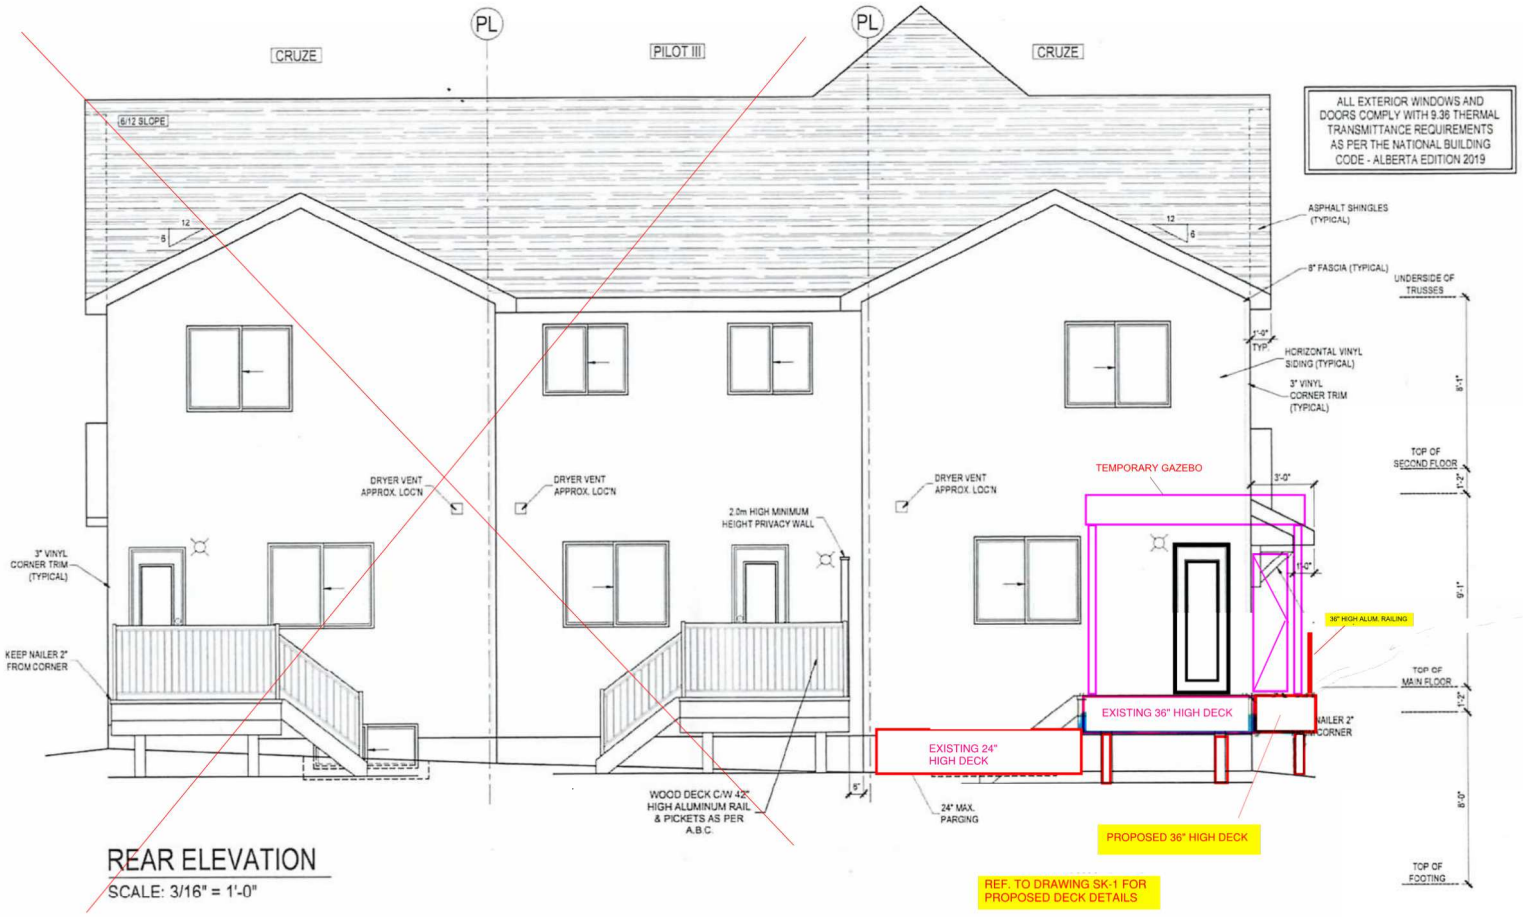


REAR ELEVATION

SCALE: 3/16" = 1'-0"

Daytona HOMES	JOB # ~~LIVSTH 014.001 002 003~~	MODEL: Cruze-t3-1 RC	NOTES 1. DO NOT SCALE DIMENSIONS 2. Contractor shall verify specifications & dimensions. Any discrepancies shall be reported to Daytona Homes for clarification and/or revision. 3. These drawings are the property of Daytona Homes. Do not use or reproduce them without their consent. 4. Drawings are never 100% accurate. As such, Daytona Homes reserves the right to make corrections to errors on plans.	7th October 2026	PAGE 2 OF 15
	LOT: 1, 2, & 3 BLK: 14 PLAN: 181 1978 *NOTE: SITE PLAN BY AREA SURVEYOR*	ADDRESS: 207 / ~~211 / 215~~ LUCAS BOULEVARD NW			
	SPEC: TITANIUM	DRAWN BY: DESIGN HOUSE OF CALGARY LTD			
		DATE: YEAR/MONTH/DAY 26th Sep. 2026			

TITANIUM PLUS SPEC

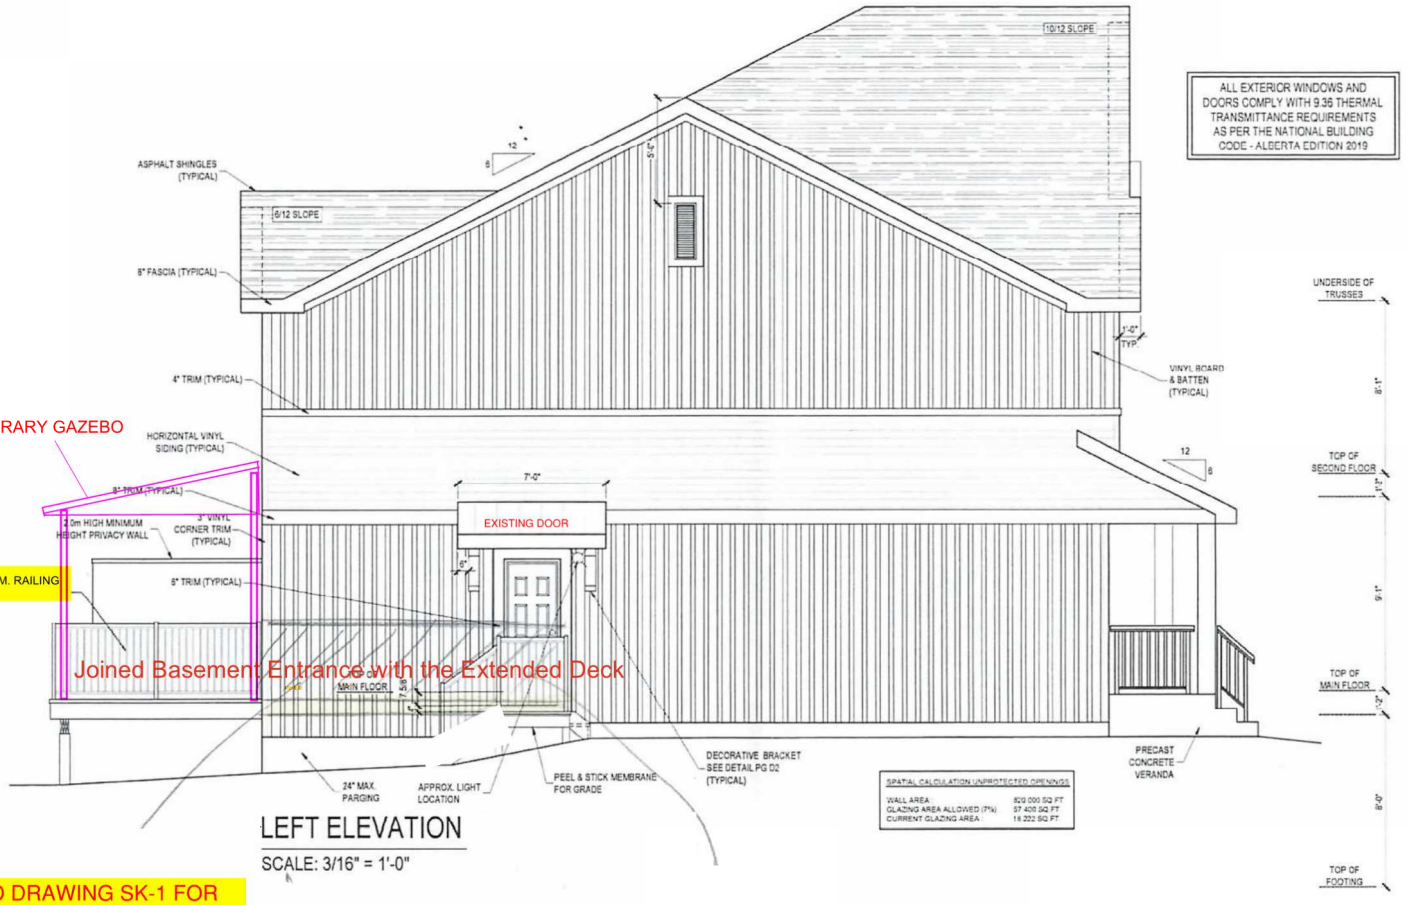

Joined Basement Entrance with the Extended Deck

LEFT ELEVATION

SCALE: 3/16" = 1'-0"

REF. TO DRAWING SK-1 FOR PROPOSED DECK DETAILS

Daytona HOMES	JOB # LIVSTH ~~014.001 002 003~~	MODEL: Cruze-t3-1 RC	NOTES 1. DO NOT SCALE DIMENSIONS 2. Contractor shall verify specifications & dimensions. Any discrepancies shall be reported to Daytona Homes for clarification and/or revision. 3. These drawings are the property of Daytona Homes. Do not use or reproduce them without their consent. 4. Drawings are never 100% accurate. As such, Daytona Homes reserves the right to make corrections to errors on plans.	7th October 2026	PAGE 3 OF 15
	LOT: 1, 2, & 3 BLK: 14 PLAN: 181 1978 *NOTE: SITE PLAN BY AREA SURVEYOR*	ADDRESS: 207 / ~~211 / 215~~ LUCAS BOULEVARD NW			
	SPEC: TITANIUM	DRAWN BY: DESIGN HOUSE OF CALGARY LTD			
		DATE: YEAR/MONTH/DAY 26th Sep. 2026			